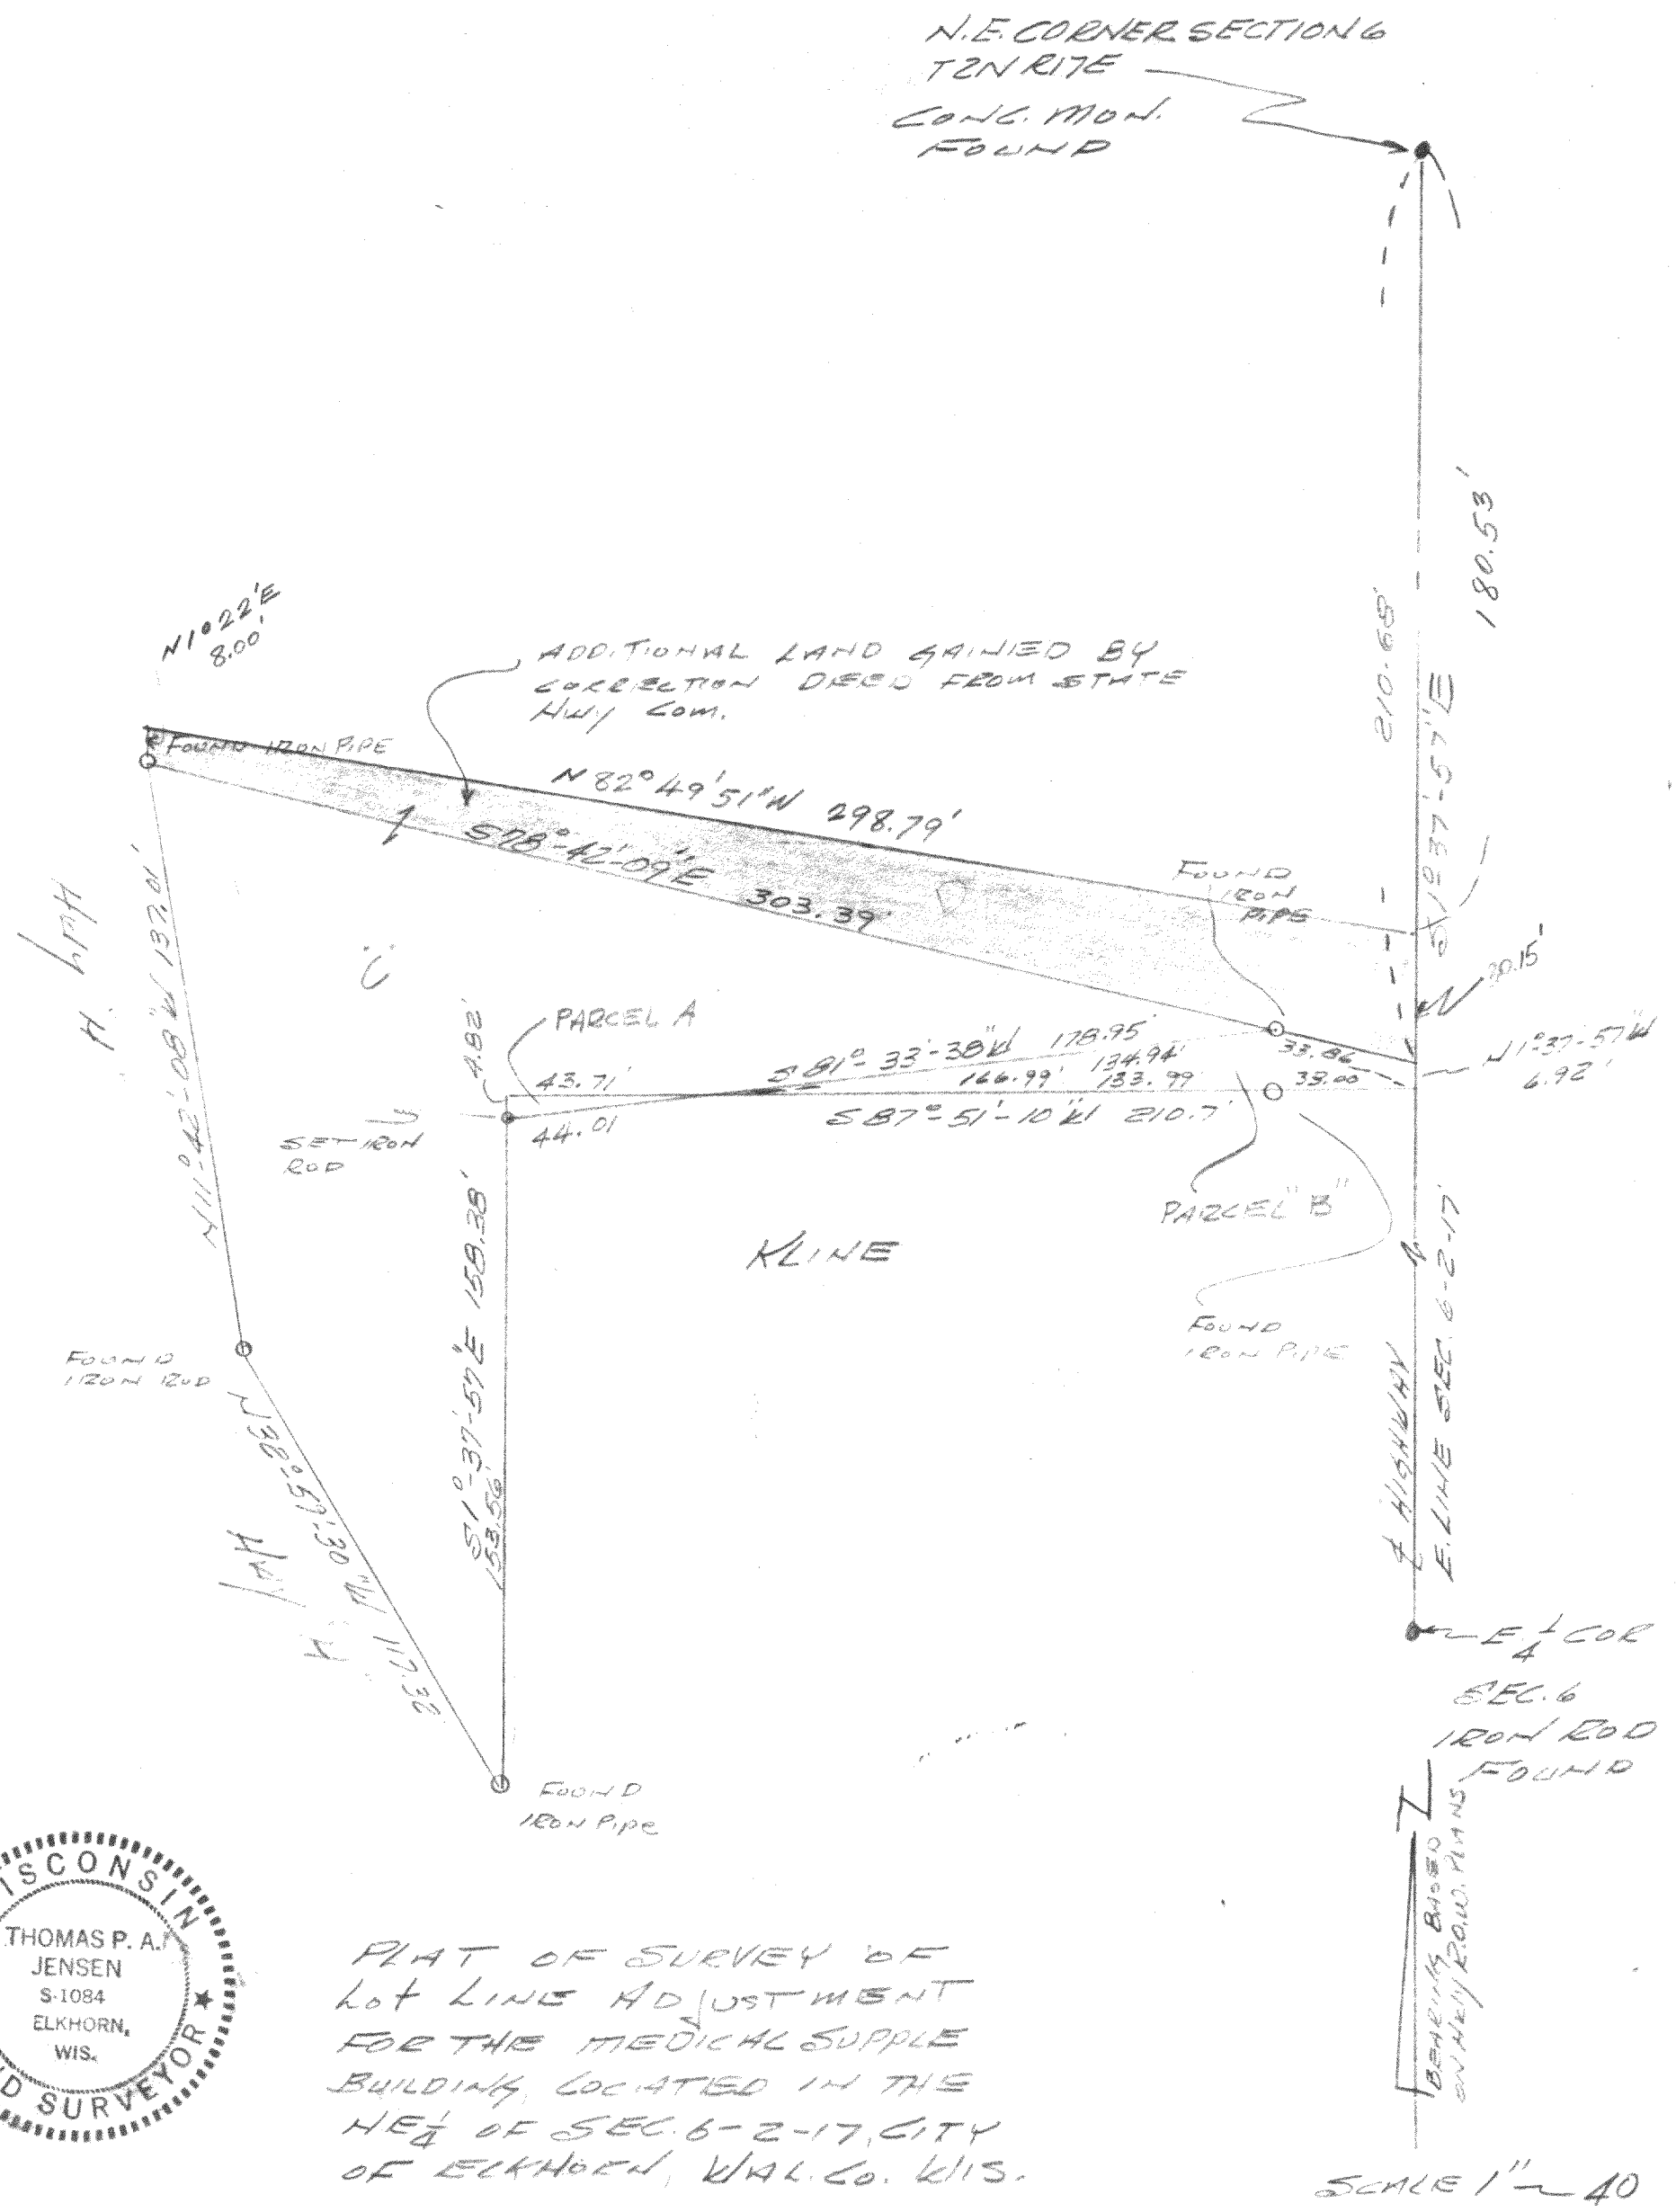

THOMAS P. A. JENSEN
S-1084
ELKHORN, WIS.
WISCONSIN LAND SURVEYOR

PLAT OF SURVEY OF
LOT LINE ADJUSTMENT
FOR THE MEDICAL SUPPLE
BUILDING, LOCATED IN THE
NE¼ OF SEC. 6-2-17, CITY
OF ELKHORN, WAL. CO. WIS.

SCALE 1" = 40

AUG. 20, 1976
REVISED SEP. 8, 1976

Thomas P. A. Jensen
SURVEYOR #1086
JENSEN & JOHNSON, INC

VSE-1 (lot line adjustment)

4-162 J