
#139-72

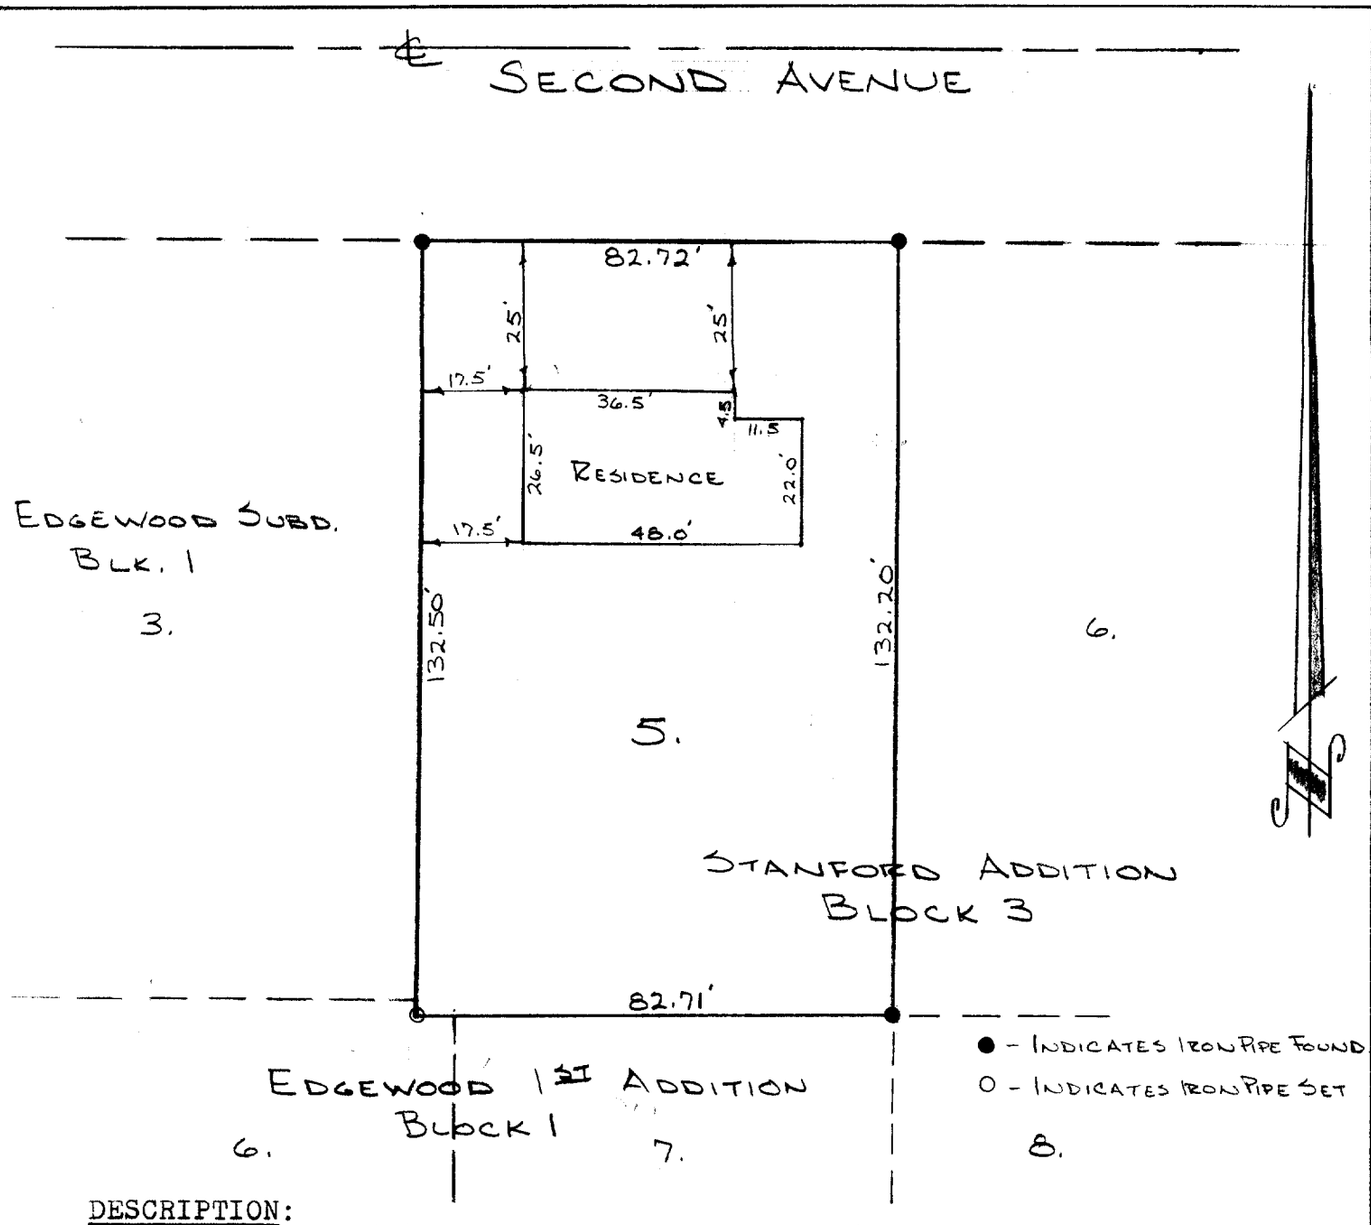

DESCRIPTION:
Lot number Five (5) of Block number Three (3) of Stanford Addition, City of Elkhorn, Walworth County, Wisconsin.

CERTIFICATE:
I, Joseph M. Biagi, surveyor, do hereby certify that I have surveyed the lands hereon described.

November 28, 1972

Joseph M. Biagi RLS #12

YS-8

4-166B