
52-4

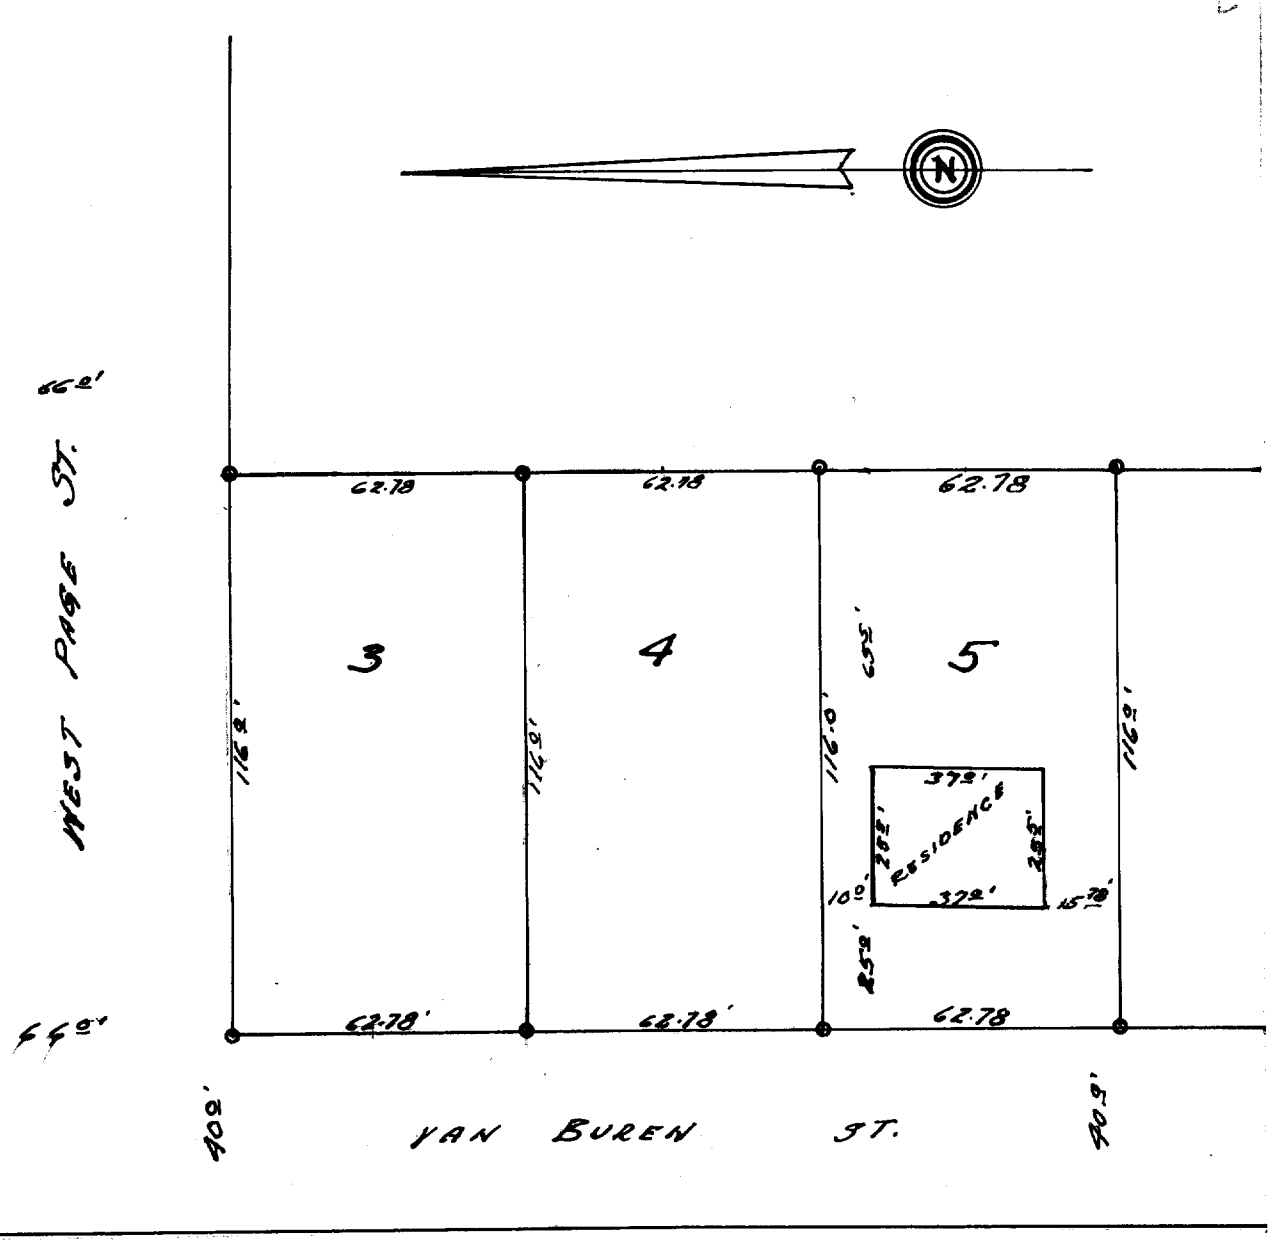

DESCRIPTION:

Lot 5, Ted's Addition to the City of Elkhorn, Walworth County, Wisconsin.

CERTIFICATE:

I, hereby certify that I have on this the 28th day of August 1952, surveyed the above described property according to the official record on file in the office of the Recorder of Deeds in and for Walworth County, Wisconsin, and find that the measurements and bearings of the boundary lines of said property as taken at the site on this day substantially agree with said official record and that the residence shown as being constructed upon said property is wholly within the confines of the boundary lines of said property and that no encroachments exist.

SIGNED AND SEALED THIS 29TH DAY OF AUGUST 1952.

Joseph M. Biagi.
Professional Engineeer
Elkgorn Wisconsin.

4-167

YTA-3