
#123-71

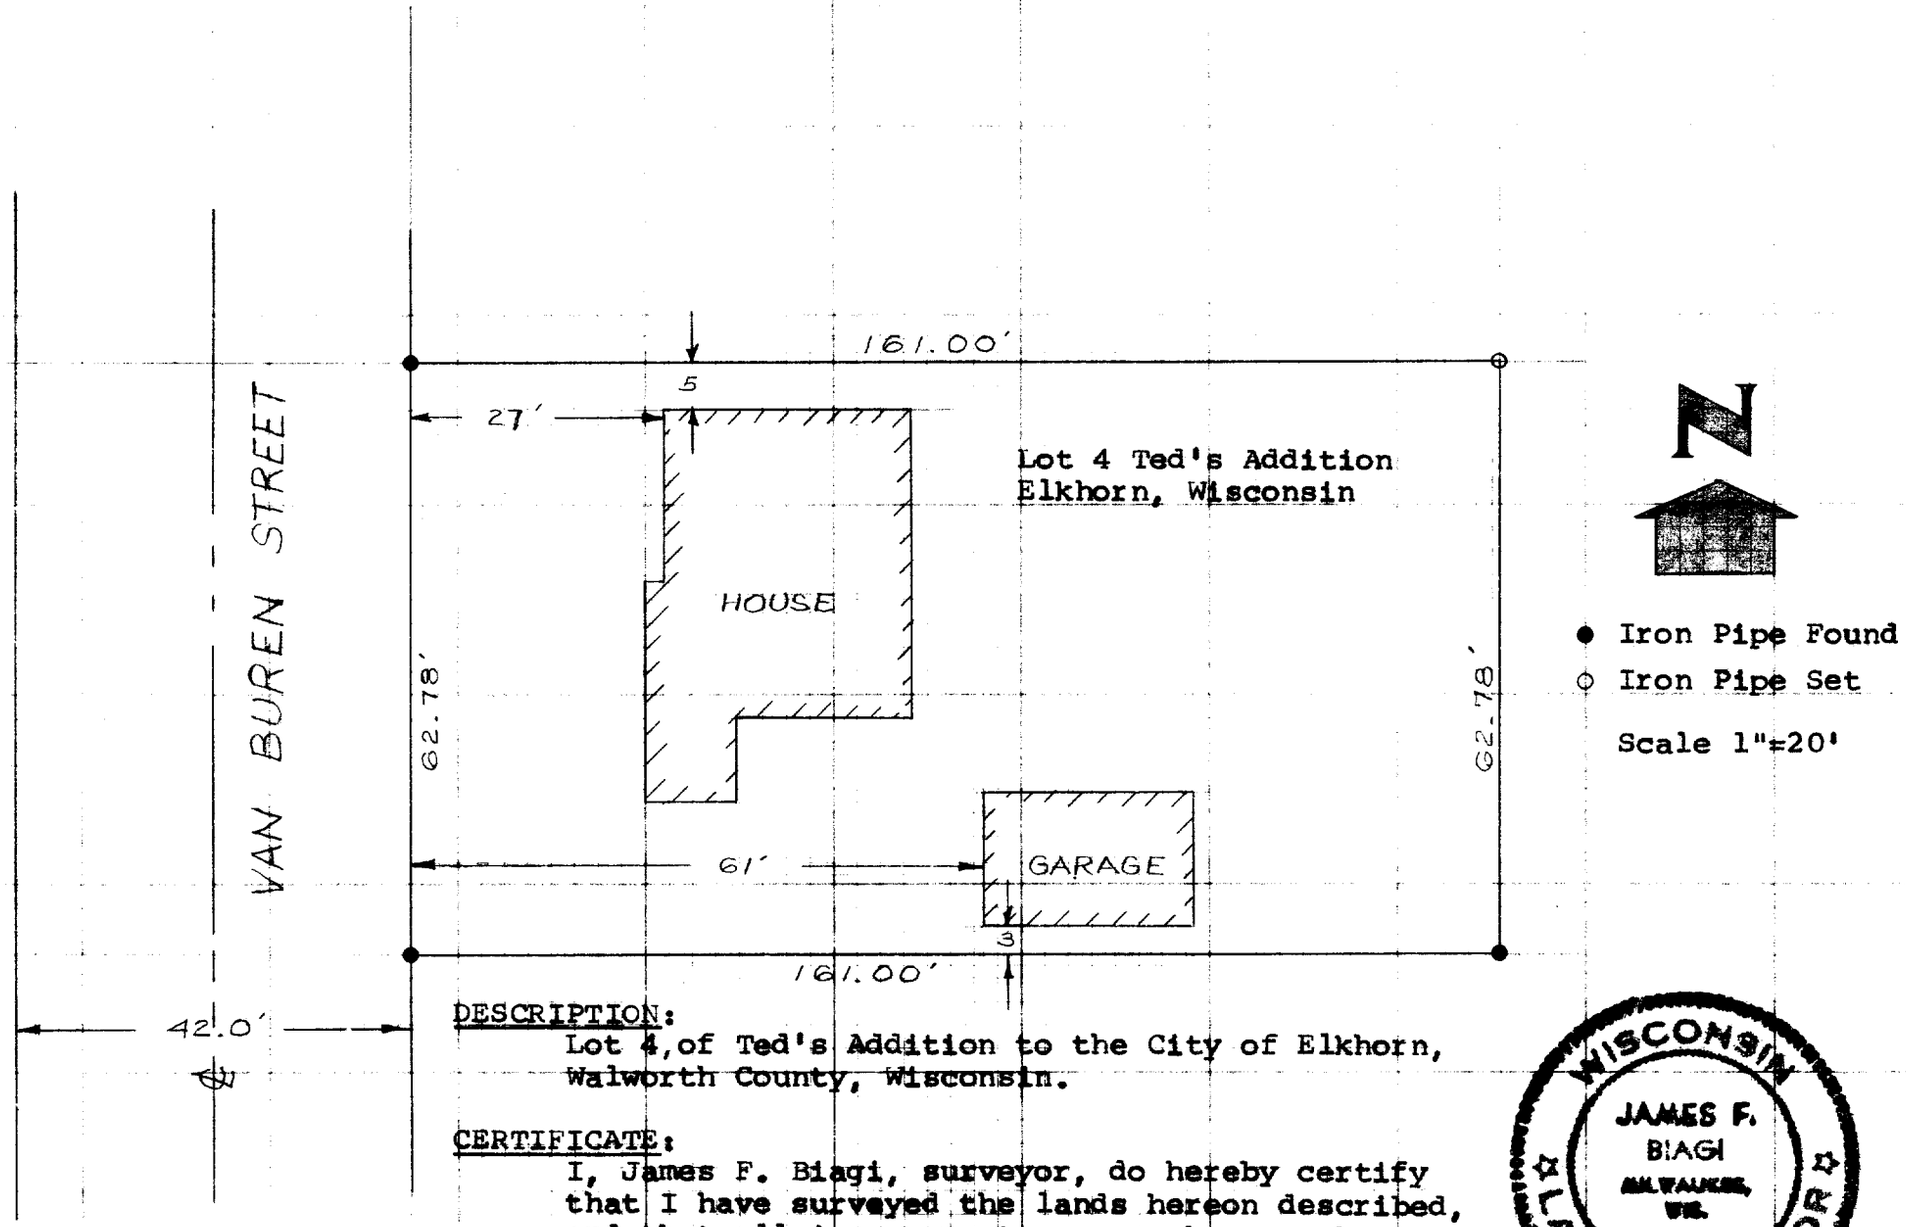


DESCRIPTION:
Lot 4, of Ted's Addition to the City of Elkhorn, Walworth County, Wisconsin.

CERTIFICATE:
I, James F. Biagi, surveyor, do hereby certify that I have surveyed the lands hereon described, and that all improvements are as hereon shown.

DATE:
May 26, 1971

James F. Biagi R.L.S.272

WISCONSIN
JAMES F. BIAGI
MILWAUKEE, WIS.
LAND SURVEYOR

YTA 4

4-16-71B