
PREPARED FOR: JANE St.JOHN

J.K. SURVEYING INC.
N3705 WILLOWBEND LANE
LAKE GENEVA, WI 53147
(262) 248-3697

COUNTY TRUNK HIGHWAY "H"
(66' WIDE)

GLENRIDGE LANE
(50.0' WIDE)

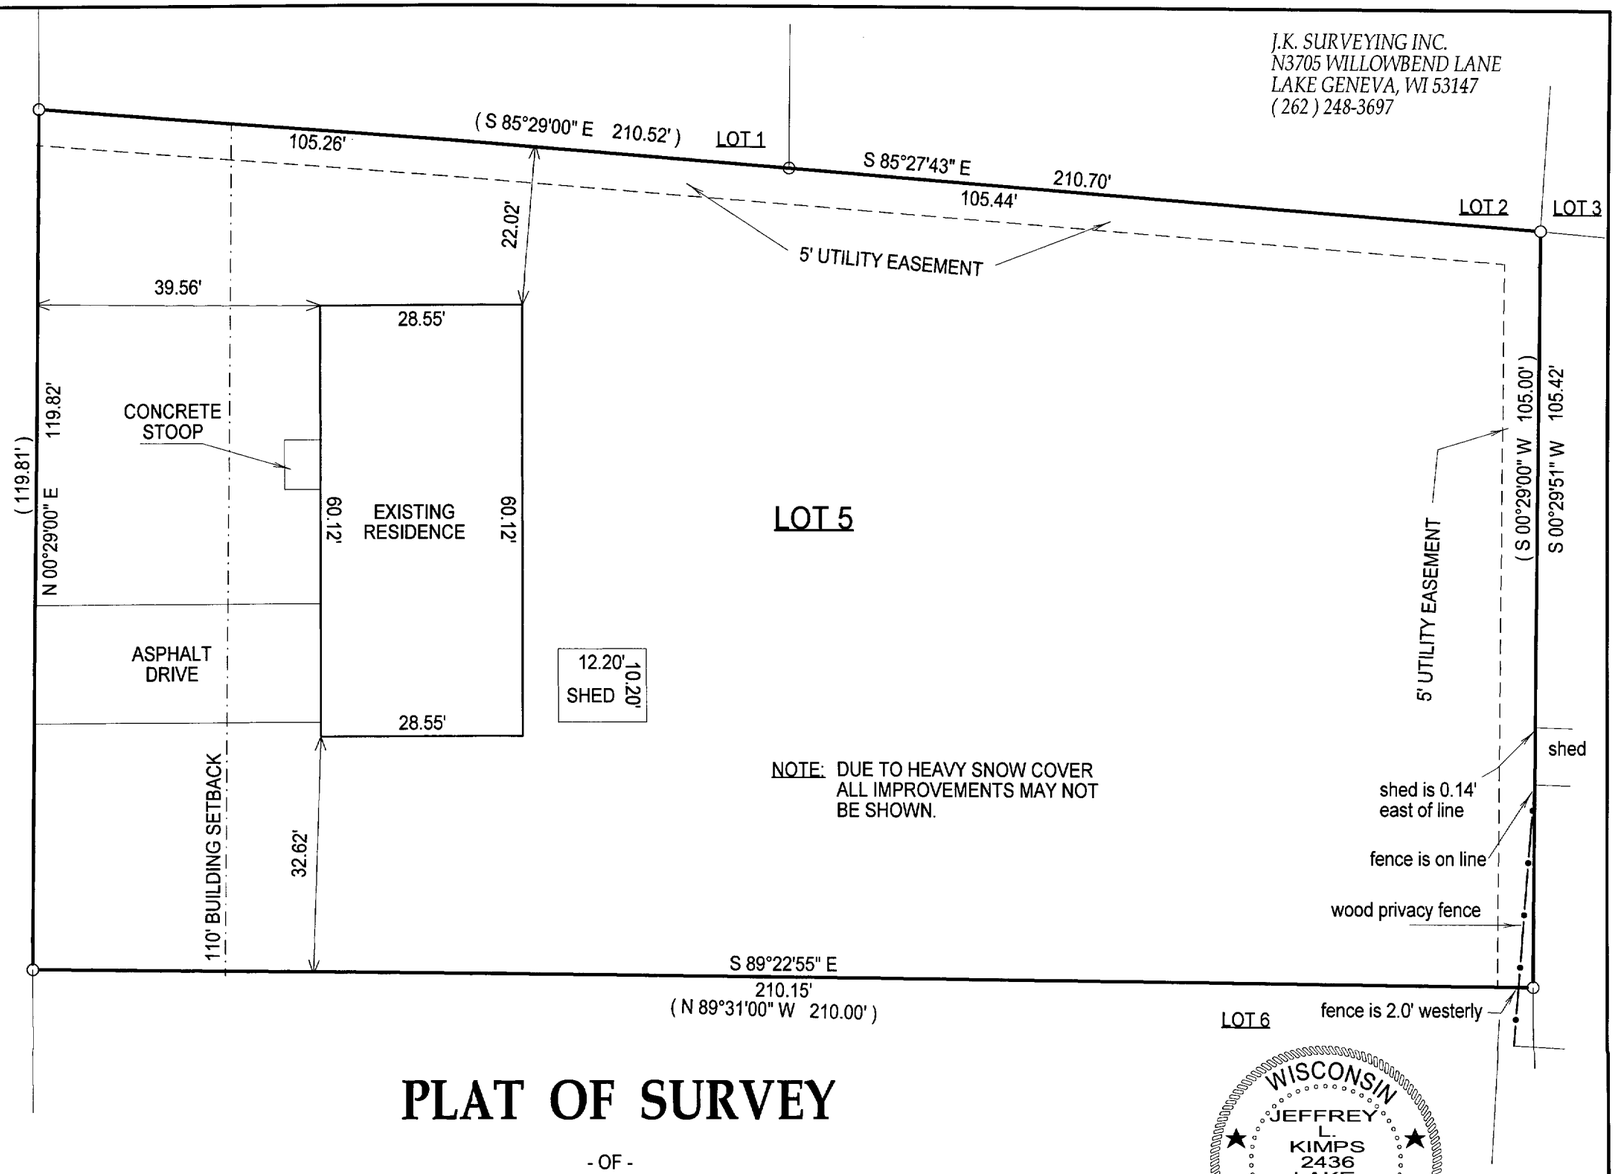

NOTE: DUE TO HEAVY SNOW COVER ALL IMPROVEMENTS MAY NOT BE SHOWN.

PLAT OF SURVEY

- OF -

LOT 5 GREEN ACRES SUBDIVSION, ACCORDING TO THE RECORDED PLAT THEREOF, CITY OF ELKHORN,WALWORTH COUNTY, WISCONSIN, LOCATED IN THE NW 1/4 OF THE NW 1/4 OF SECTION 8, TOWN 2 NORTH, RANGE 17 EAST.

( ) = RECORDED AS
□ = FOUND IRON BAR
○ = FOUND IRON PIPE
■ = SET IRON BAR
● = SET IRON PIPE
SCALE: 1" = 20'
JOB #: 04-044
TAX ID #: YGR00005

COMPARE LEGAL DESCRIPTION ABOVE AND DRAWING WITH DEED. FOR BUILDING RESTRICTIONS AND EASEMENTS NOT SHOWN,REFER TO DEED, ABSTRACT SOURCES AND LOCAL MUNICIPAL CODES. NOTIFY THE SURVEYOR IMMEDIATELY OF ANY DISCREPANCY.

"I hereby certify that I have surveyed the above described property and that the above map, to the best of my knowledge and belief, is a true representation thereof and shows the size and location of all visible structures, apparent easements and encroachments if any."
This survey is made for the present owners of the property, and those who purchase, mortgage, or guarantee the title thereto, within one year from the date hereof.

DATED THIS 9 TH, DAY OF FEBRUARY 2004.

WISCONSIN JEFFREY L. KIMPS 2436 LAKE GENEVA. WIS. LAND SURVEYOR

JEFFREY L KIMPS S-2436
Wisconsin Registered Land Surveyor
(original if signed in red)

MAR 3

KW

004-1721