
PREPARED FOR : *TOM MARTIN*
KEEFE REAL ESTATE INC.
980-A N. WISCONSIN ST.
ELKHORN WI. 53121

PLAT OF SURVEY


- OF -

THE EAST 47.1 FEET OF LOT 14 AND THE WEST 73.1 FEET OF LOT 13, BLOCK 1 IN JAMESJONES 2nd ADDITION TO THE CITY OF ELKHORN, WALWORTH COUNTY, WISCONSIN.

J.K. SURVEYING INC.
N3705 WILLOWBEND LANE
LAKE GENEVA, WI, 53147
262-248-3697

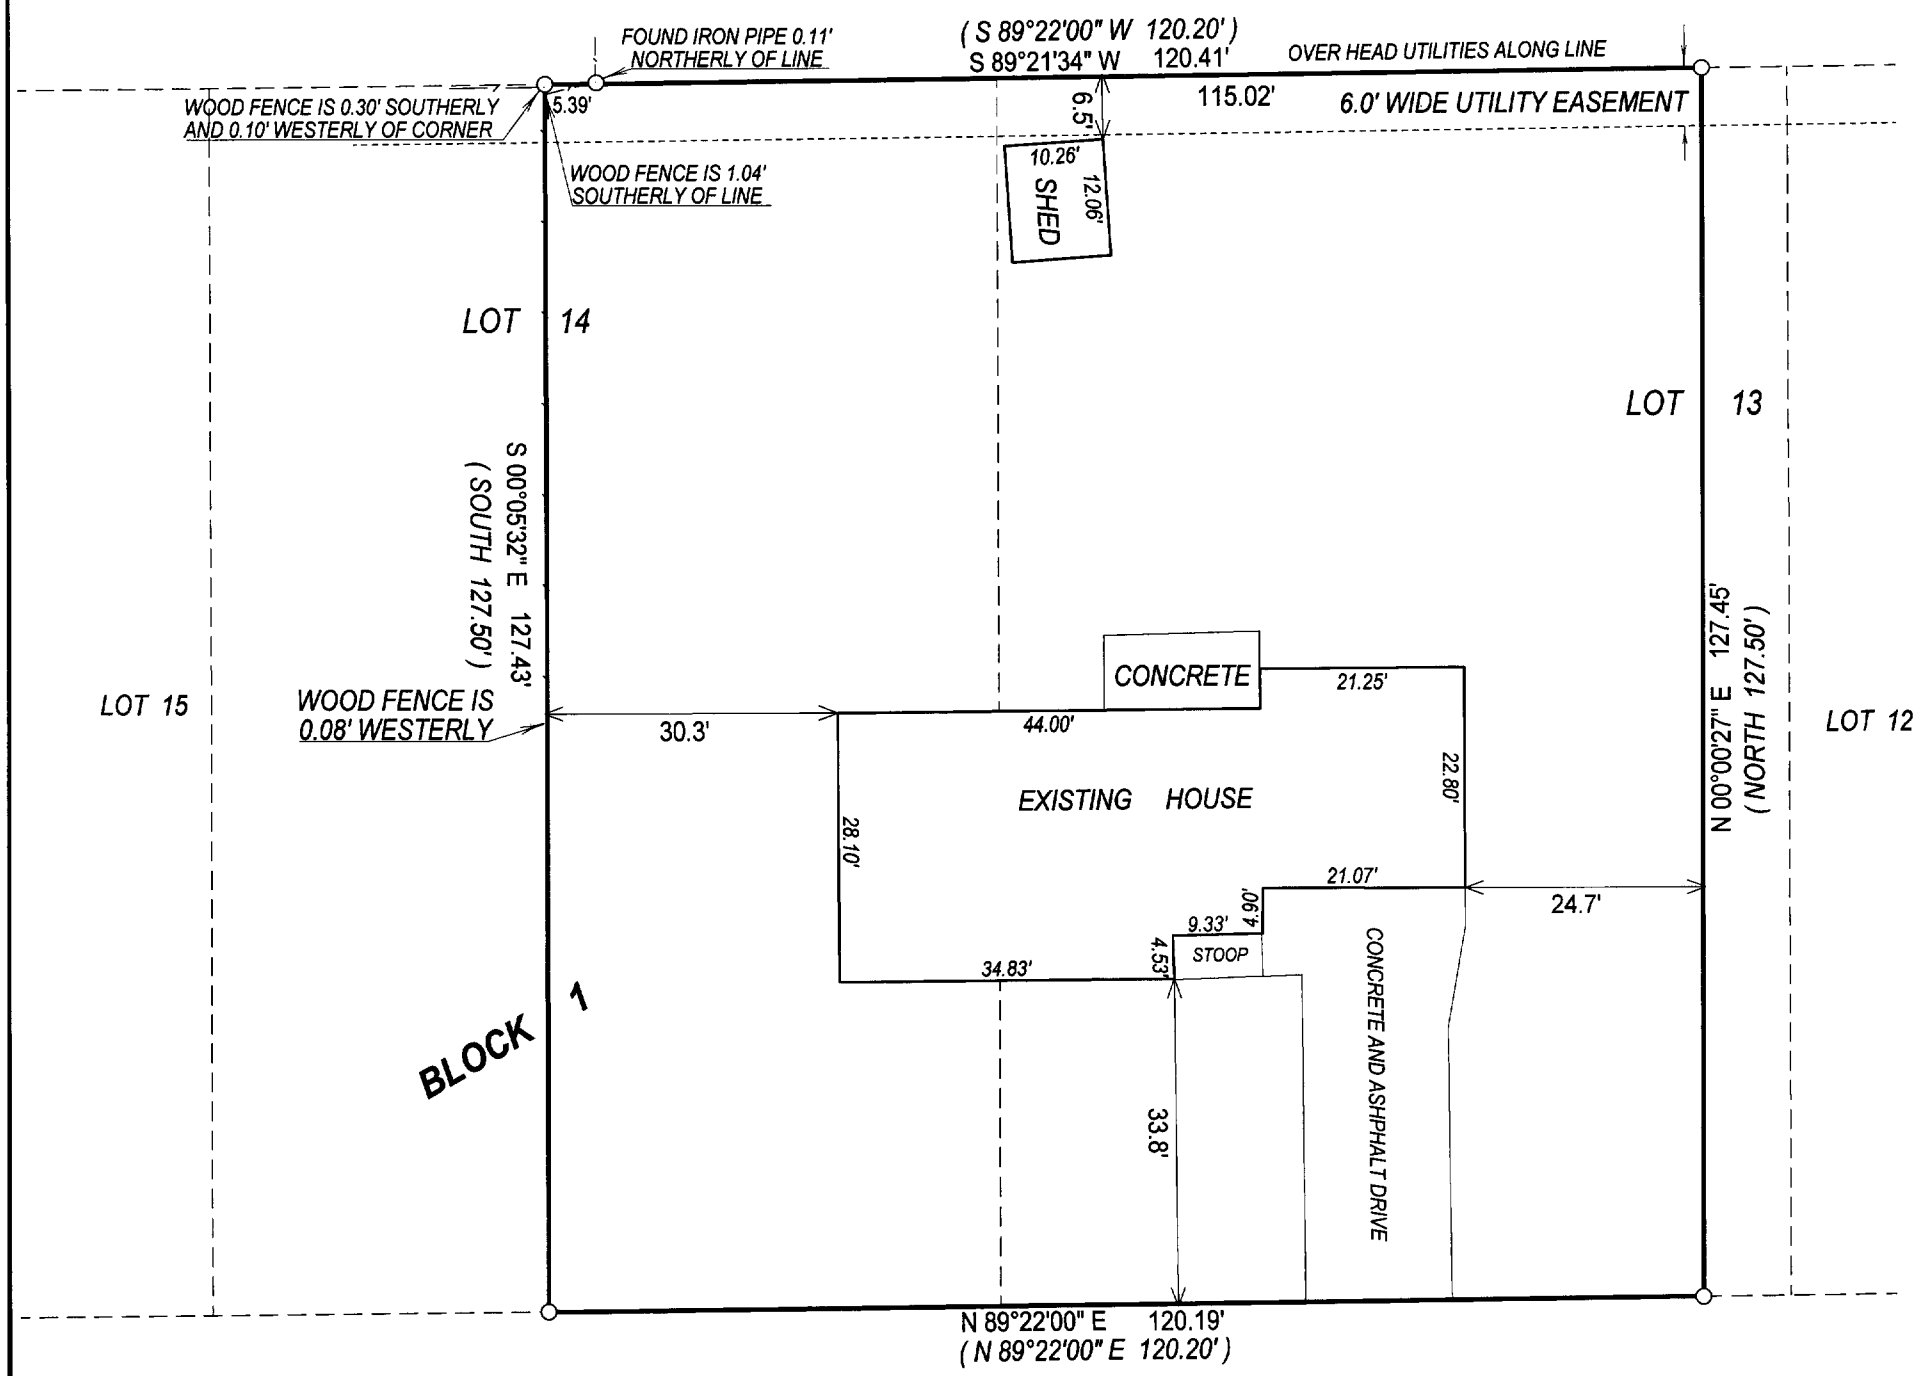

C.L. WESTWARD DRIVE
(66' WIDE ROAD)

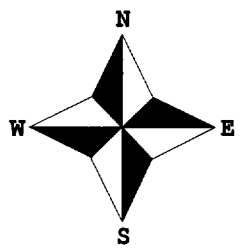

( )= recorded as
□ = *found iron bar*
○ = *found iron pipe*
● = *set iron pipe*
■ = *set iron bar*

SCALE 1" = 20'

JOB # 04-023

TAX ID # YJA200013

MAR 3
KW

COMPARE LEGAL DESCRIPTION ABOVE AND DRAWING WITH DEED. FOR BUILDING RESTRICTIONS AND EASEMENTS NOT SHOWN,REFER TO DEED, ABSTRACT SOURCES AND LOCAL MUNICIPAL CODES. NOTIFY THE SURVEYOR IMMEDIATELY OF ANY DISCREPANCY.

"I hereby certify that I have surveyed the above described property and that the above map, to the best of my knowledge and belief, is a true representation thereof and shows the size and location of all visible structures, apparent easements and encroachmentsif any."
This survey is made for the present owners of the property, and those who purchase, mortgage, or guarentee the title thereto, within one year from the date hereof.

WISCONSIN
JOHN P. KROTT
S-2258
MUKWONAGO, WIS.
LAND SURVEYOR

JOHN KROTT S - 2258
Wisconsin Registered Land Surveyor
(original if signed in red)

DATED THIS THE 2nd DAY OF FEBRUARY 2004.

004-1723