PREPARED FOR : *TOM MARTIN*
KEEFE REAL ESTATE INC.
980-A N. WISCONSIN ST.
ELKHORN WI. 53121


PLAT OF SURVEY

- OF -

J.K. SURVEYING INC.
N3705 WILLOWBEND LANE
LAKE GENEVA, WI, 53147
262-248-3697

COMMENCING AT THE NORTHEAST CORNER OF BLOCK 47 , ROCKWELL'S SECOND ADDITION, THENCE SOUTH 176.5 FEET ; THENCE WEST 66 FEET , THENCE NORTH 176.5 FEET TO THE NORTH LINE OF BLOCK 47; THENCE EAST 66 FEET TO THE PLACE OF BEGINNING.

ROCKWELL STREET

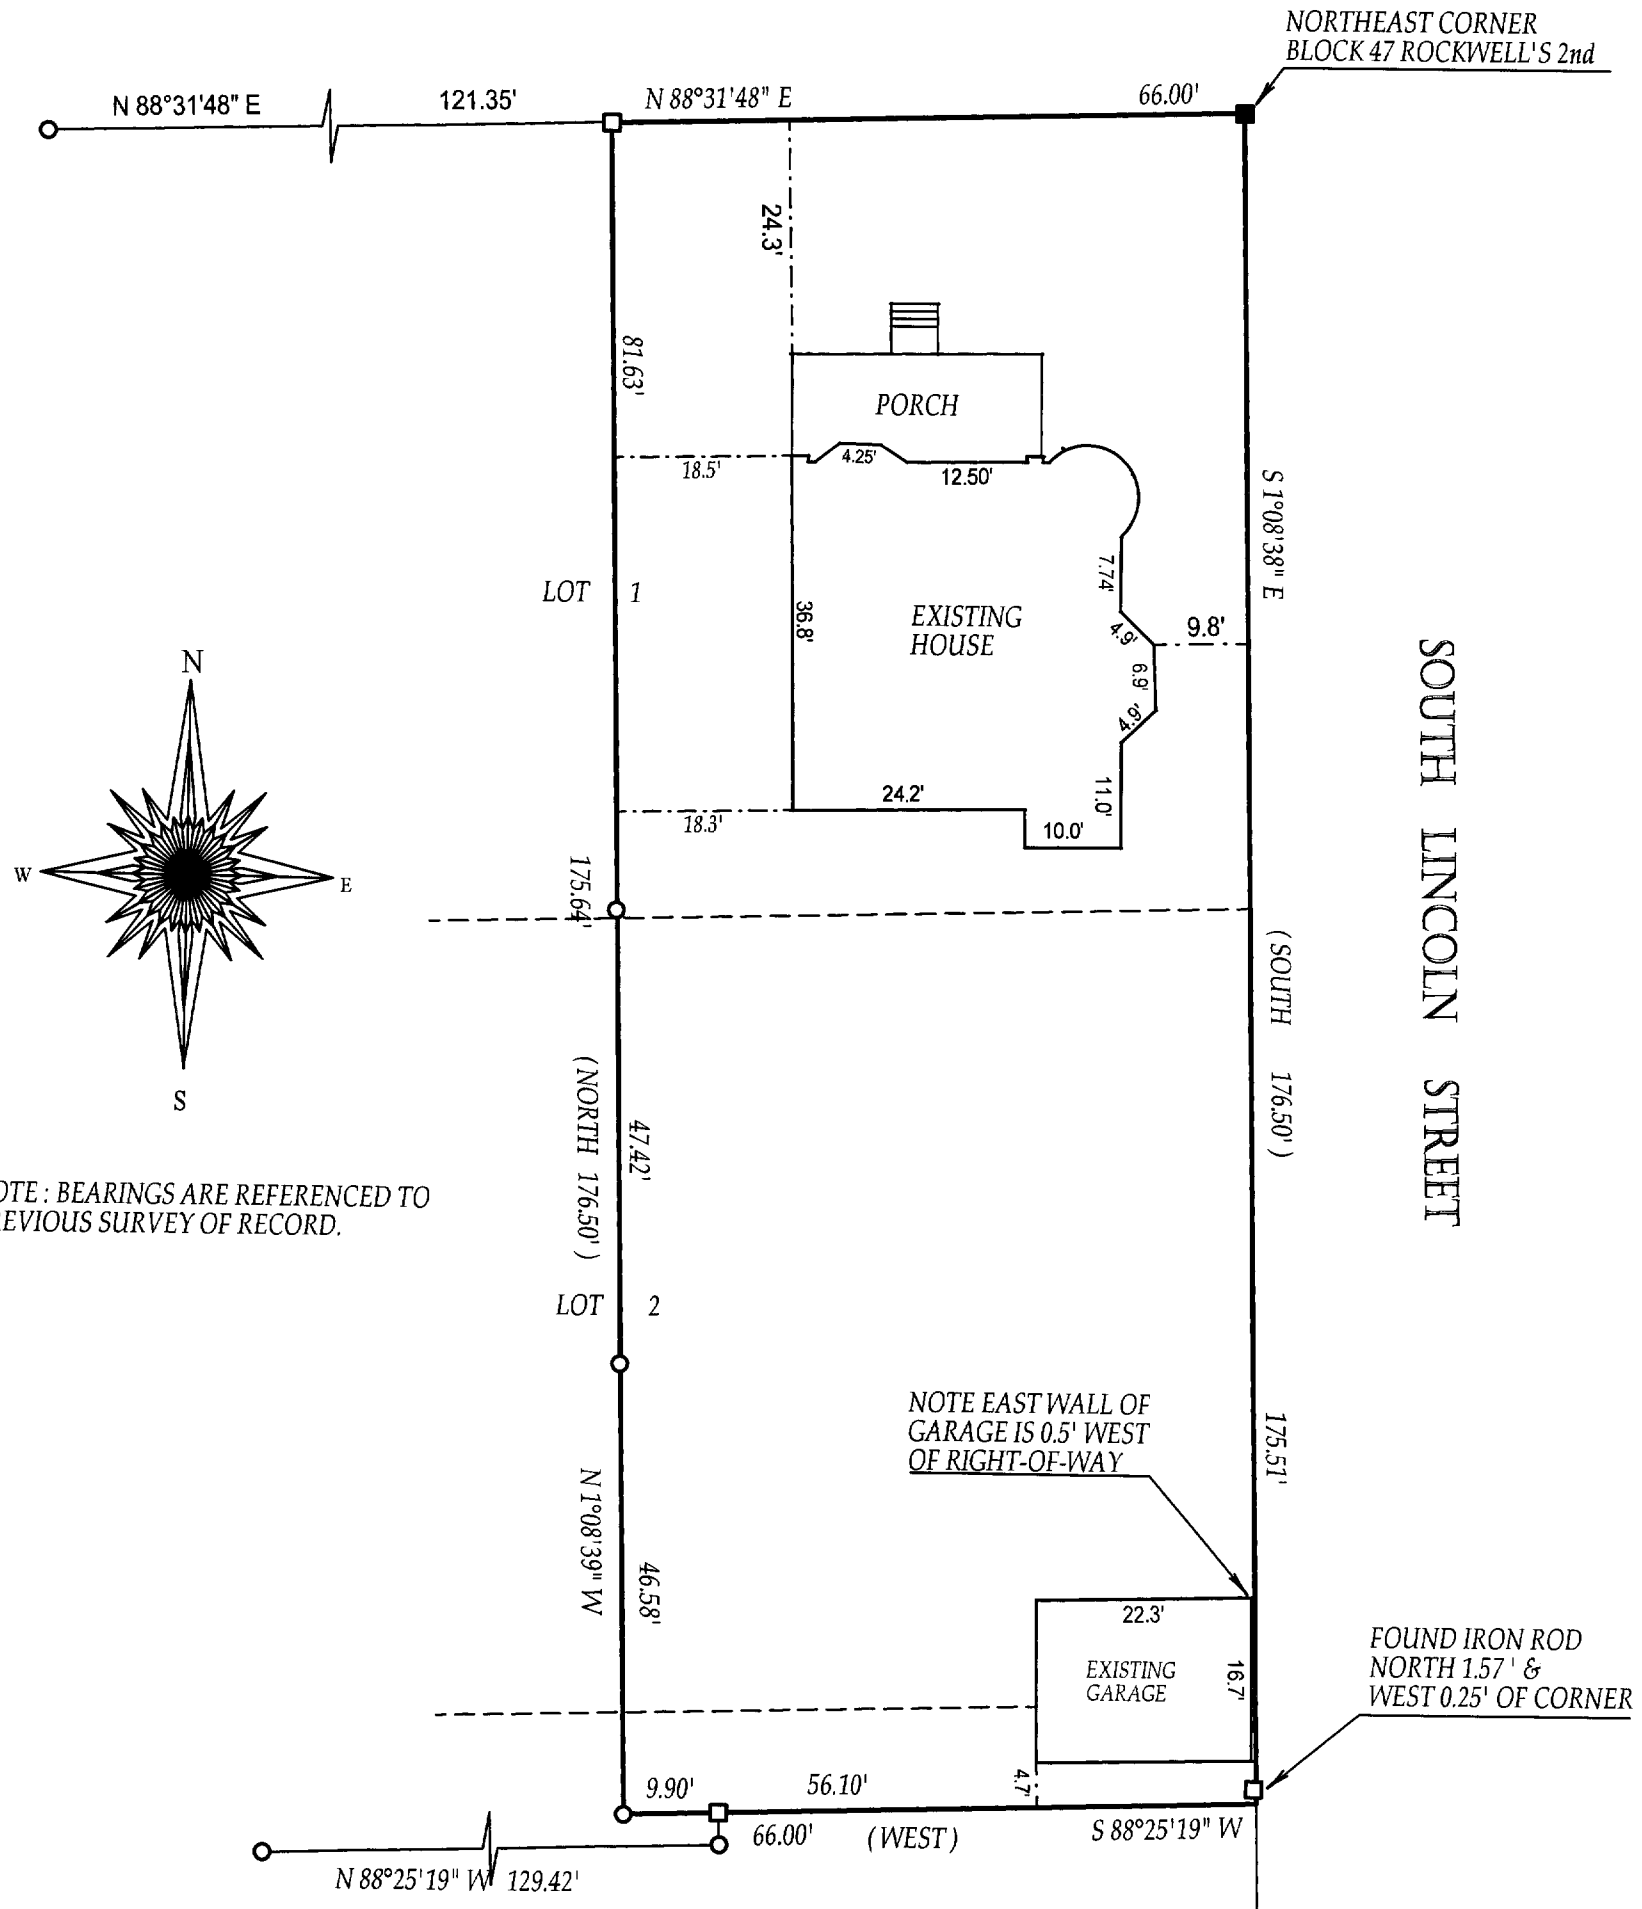

( )= *recorded as*
□ = *found iron bar*
○ = *found iron pipe*
● = *set iron pipe*
■ = *set iron bar*

SCALE 1" = 20'

JOB # 04-397

TAX ID # YRW200001

RECEIVED
AUG 1 3 20

COMPARE LEGAL DESCRIPTION ABOVE AND DRAWING WITH DEED. FOR BUILDING RESTRICTIONS AND EASEMENTS NOT SHOWN,REFER TO DEED, ABSTRACT SOURCES AND LOCAL MUNICIPAL CODES. NOTIFY THE SURVEYOR IMMEDIATELY OF ANY DISCREPANCY.

"I hereby certify that I have surveyed the above described property and that the above map is a true representation thereof and shows the size and location of all visible structures, apparent easements and encroachments if any."
This survey is made for the present owners of the property, and those who purchase, mortgage, or guarantee the title thereto, within one year from the date hereof.

DATED THIS 29th,DAY OF JULY , 2004

WISCONSIN
JOHN P. KROTT
S-2258
LAKE GENEVA, WIS.
LAND SURVEYOR

JOHN KROTT S - 2258
Wisconsin Registered Land Surveyor
(original if signed in red)

004-1752