
PREPARED FOR:
MICHAEL KUEHN
1407 LINDA LANE
LAKE GENEVA , WI
53147

PLAT OF SURVEY

- OF -

LOT 29 OF JACKSON CREEK EAST SUBDIVISION LOCATED IN THE SW AND SE 1/4'S OF THE SW 1/4 OF SECTION 7, TOWN 2 NORTH , RANGE 17 EAST , CITY OF ELKHORN , WALWORTH COUNTY , WISCONSIN.

J.K. SURVEYING INC.
N3705 WILLOWBEND LANE
LAKE GENEVA, WI, 53147
262-248-3697

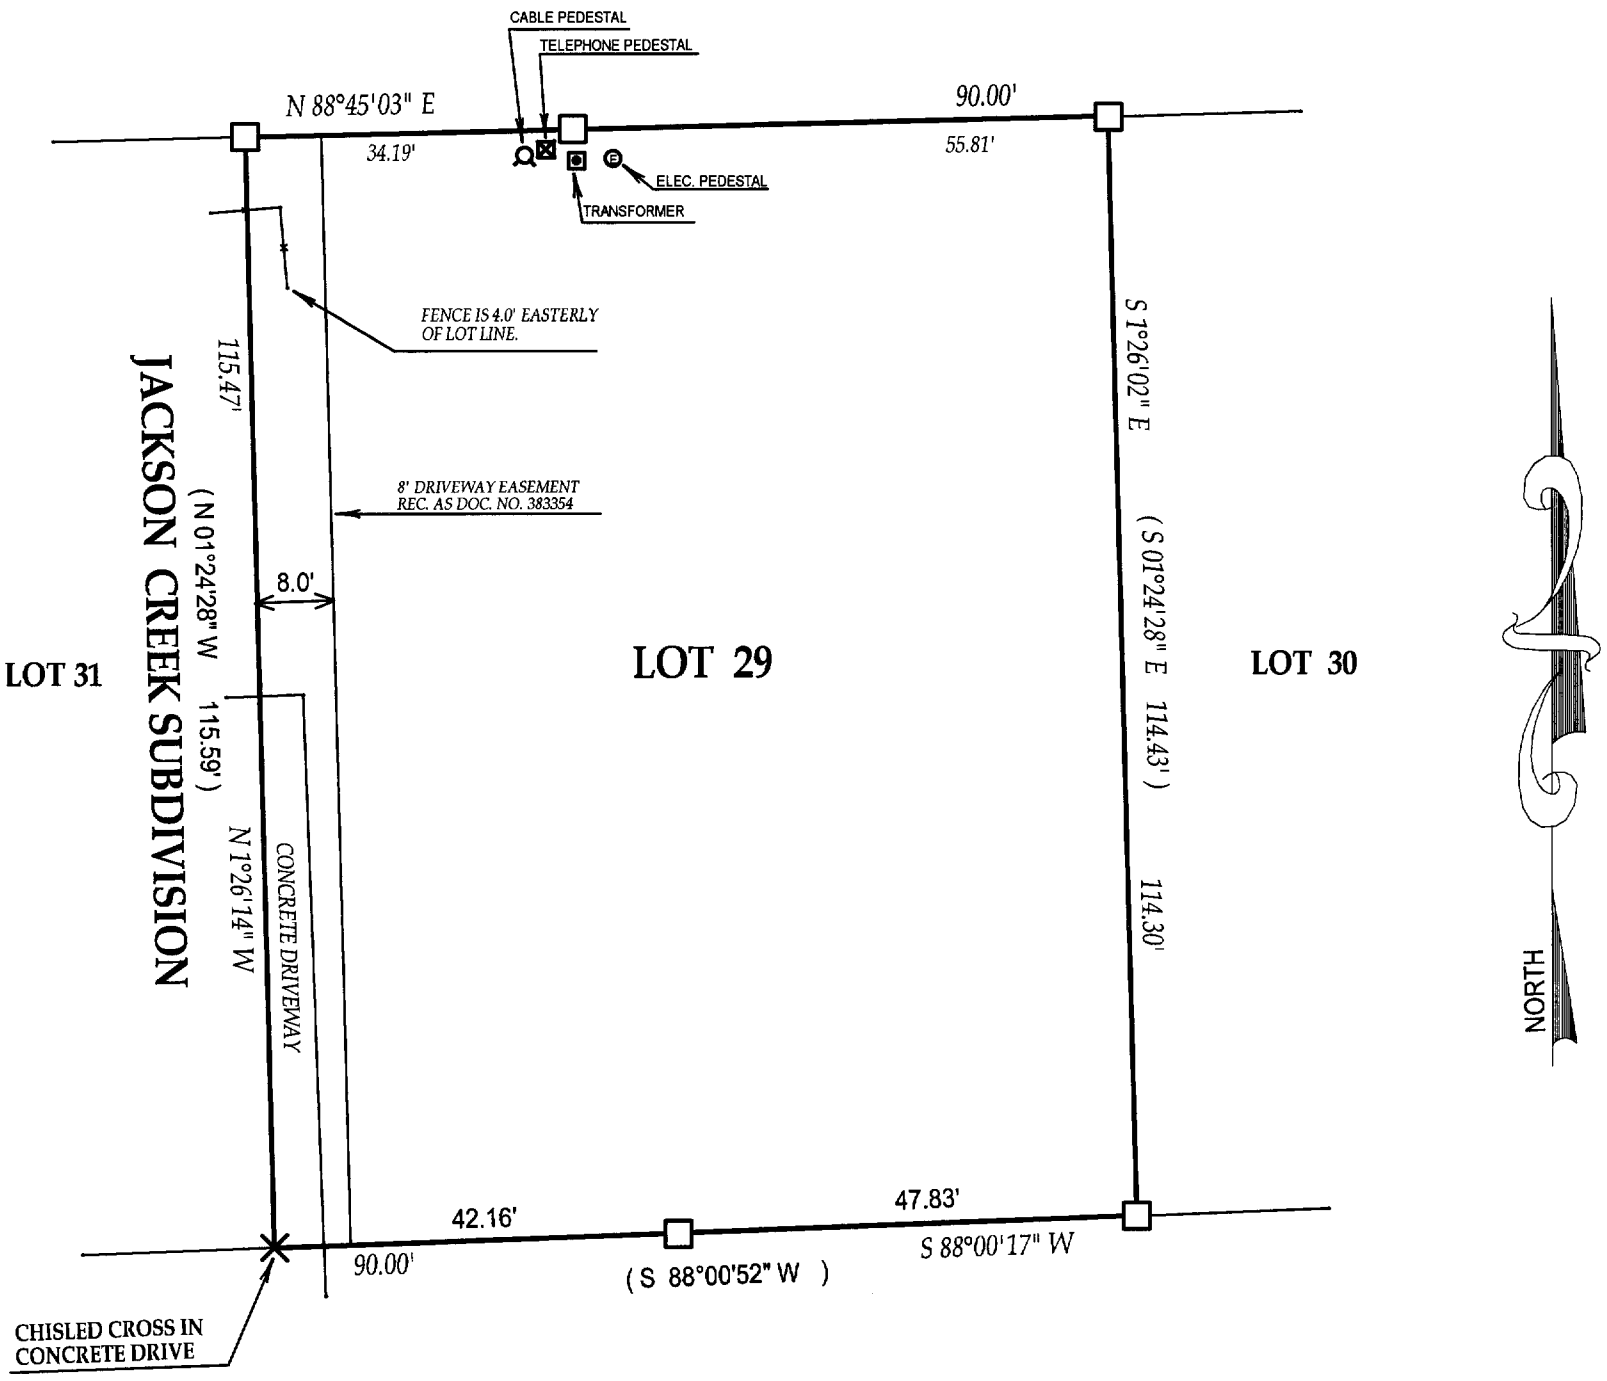

C.L. GRANT STREET

(66' WIDE)

( )= recorded as

□ = found iron bar

○ = found iron pipe

● = set iron pipe

■ = set iron bar

SCALE 1" = 20'

JOB # 04-148

TAX ID # YJCE00029

COMPARE LEGAL DESCRIPTION ABOVE AND DRAWING WITH DEED. FOR BUILDING RESTRICTIONS AND EASEMENTS NOT SHOWN,REFER TO DEED, ABSTRACT SOURCES AND LOCAL MUNICIPAL CODES. NOTIFY THE SURVEYOR IMMEDIATELY OF ANY DISCREPANCY.

"I hereby certify that I have surveyed the above described property and that the above map is a true representation thereof and shows the size and location of all visible structures, apparent easements and encroachments if any."
This survey is made for the present owners of the property, and those who purchase, mortgage, or guarantee the title thereto, within one year from the date hereof.

DATED THIS 29th, DAY OF APRIL , 2004

RECEIVED
AUG

WISCONSIN
JOHN P. KROTT S-2258 LAKE GENEVA, WIS.
LAND SURVEYOR

JOHN KROTT S - 2258
Wisconsin Registered Land Surveyor
(original if signed in red)

004-1755