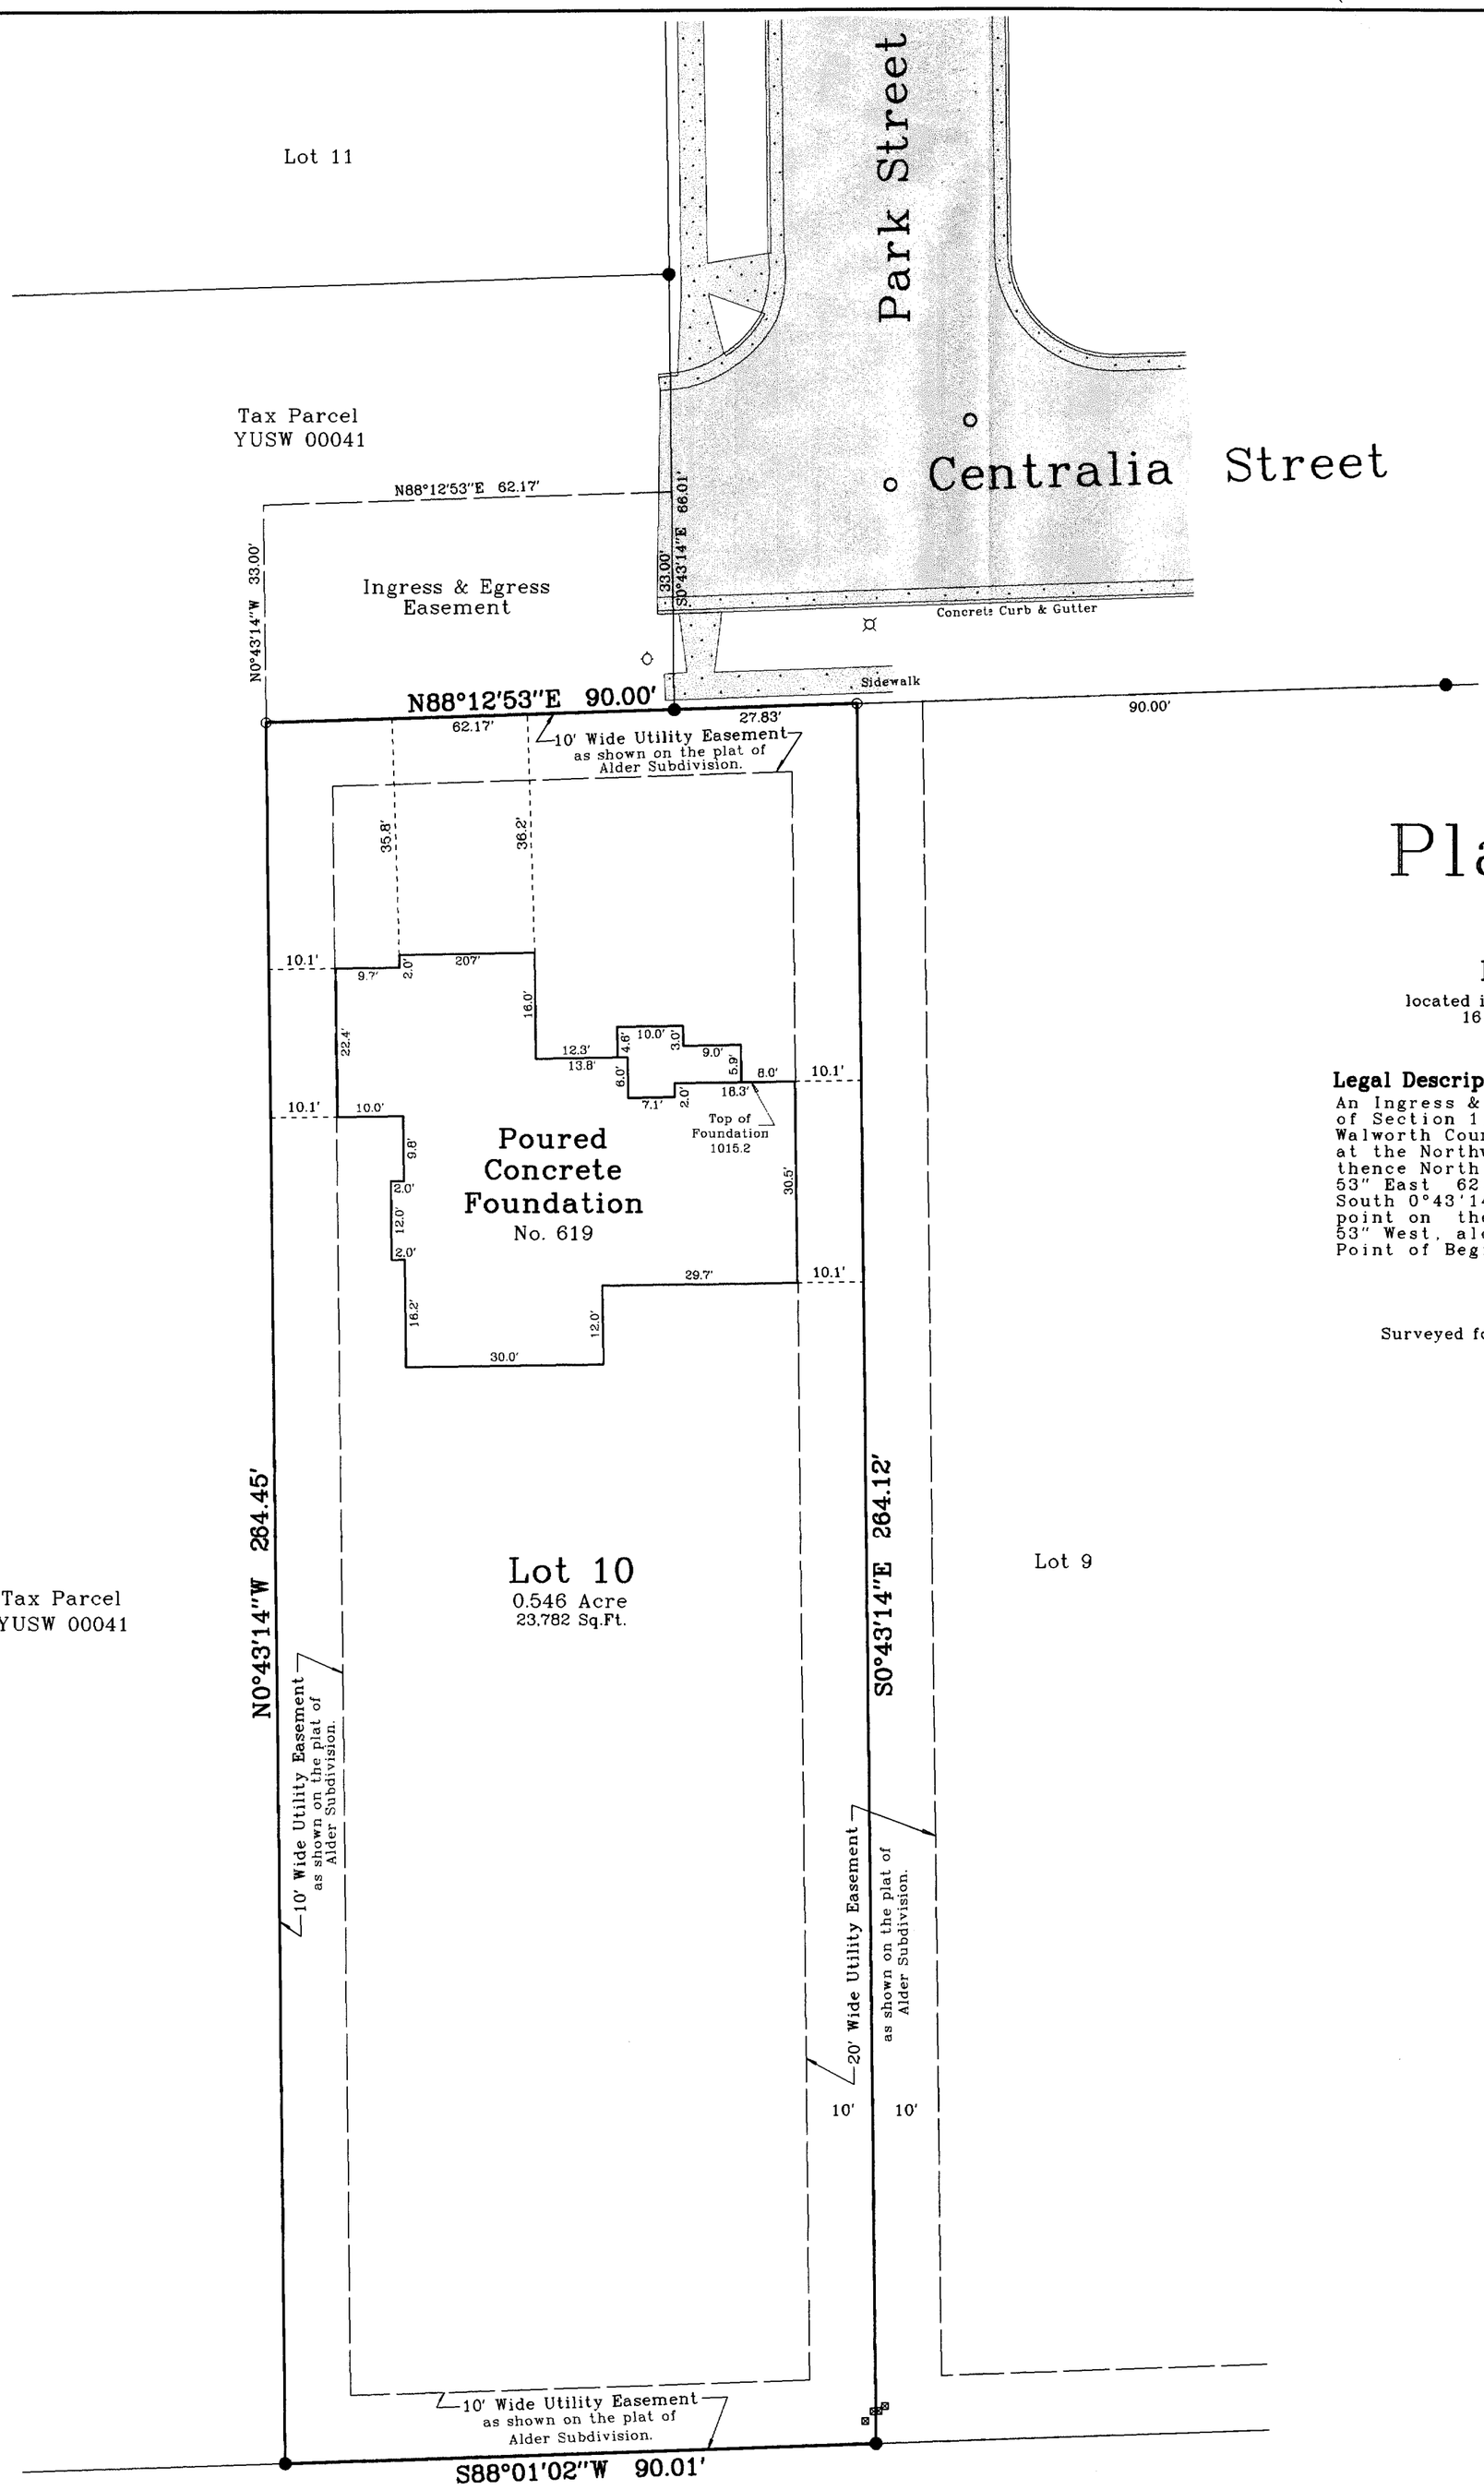


Plat of Survey

of

Lot 10 of Alder Subdivision,

located in the Northwest 1/4 of Section 1, Town 2 North, Range 16 East, City of Elkhorn, Walworth County, Wisconsin.

Legal Description of Ingress & Egress Easement

An Ingress & Egress Easement located in the Northwest 1/4 of Section 1, Town 2 North, Range 16 East, City of Elkhorn, Walworth County, Wisconsin, described as follows: Begin at the Northwest corner of Lot 10 of Alder Subdivision; thence North 0°43'14" West 33.00 feet; thence North 88°12' 53" East 62.17 feet to the West line of Park Street; thence South 0°43'14" East, along said West line, 33.00 feet to a point on the North line of said Lot 10; thence South 88°12' 53" West, along said North line of Lot 10, 62.17 feet to the Point of Beginning.

Surveyed for: **Chad Greving**
N5814 Bowers Road
Elkhorn, Wisconsin. 53121

Bearings referenced to the plat of Alder Subdivision.

DOUGLAS G. OLSON S-2093 ELKHORN

Not Certified Unless Stamped in Red.

RECEIVED OCT - 8 2004

Notes: 1) This survey plat is not certified unless signed and sealed in red ink.

2) This survey is subject to Wisconsin lien laws. This Plat of Survey is the notice of intent to file lien. Lien waiver required.

Copyright c 2004 by Jensen & Olson Land Surveying, LLC.

All rights reserved. No part of this survey plat may be reproduced or transmitted in any form by any means - graphic, electronic, or mechanical, including photocopying, tracing, or information storage and retrieval systems - without permission in writing from Douglas G. Olson, Jensen & Olson Land Surveying, LLC.

I, Douglas G. Olson, Wisconsin Registered Land Surveyor, do hereby certify that this survey was performed by me or under my direction in full compliance with the owner's/agent's instructions and Chapter A-E 7 of the Wisconsin Administrative Code "Minimum Standards for Property Surveys"; and that this map is an accurate representation thereof to the best of my knowledge and belief.

Douglas G. Olson
Wisconsin Registered Land Surveyor - 2093

YALD 00010

2003.205

Sheet 1 of 1 Sheets

Job Reference Number
2003.205

Legend
- Found Iron Rod
- Set Iron Rod, 3/4" dia.
- Set Wood Stake
- ( ) Recorded Information
- Utility Pedestal ☼ Hydrant
- Asphalt Surface ☼ Light Pole
- Concrete Surface

Jensen & Olson Land Surveying, LLC
45 South Wisconsin Street P.O. Box 322
Elkhorn, Wisconsin. 53121
Telephone (262) 723-3434
Facsimile (262) 723-8044

Scale in Feet
1" = 20'
0' 10' 20' 40'

Survey Date: December 18, 2003.
Revisions: No. 1 - Ingress & Egress Easement
No. 2 - Foundation

004-1788