
PLAT OF SURVEY

LOT 78, HARVEST POINTE, being a part of Lot 4 of Certified Survey Map No. 2083, and a part of the Northeast ¼, Northwest ¼, Southeast ¼ and the Southwest ¼ of the Southwest ¼ of Section 30, Town 3 North, Range 17 East, City of Elkhorn, Walworth County, Wisconsin.

Surveyed for: Bill McArdle

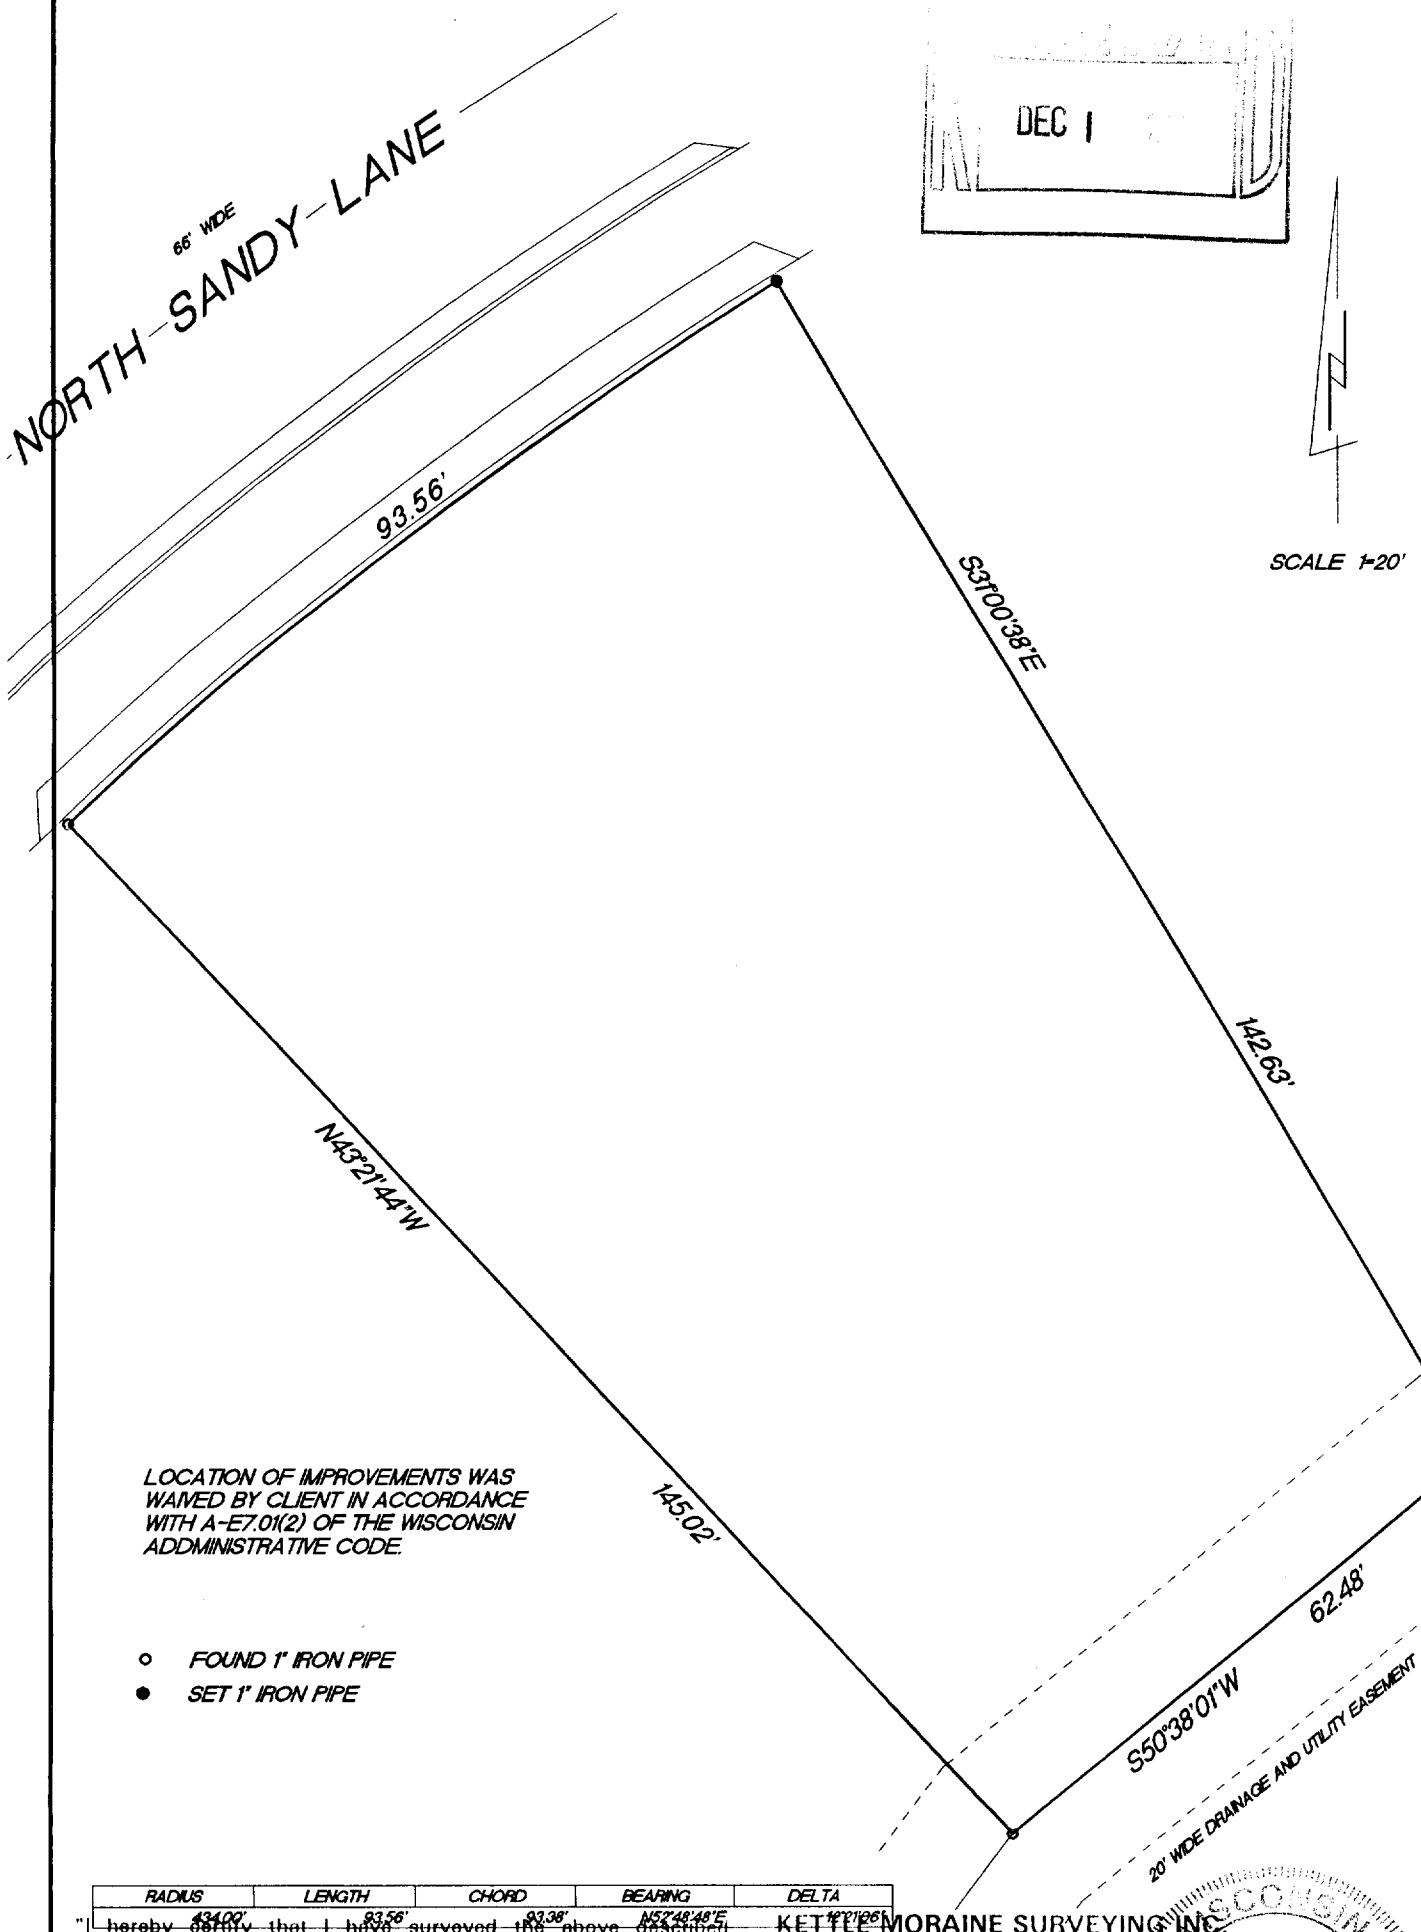

LOCATION OF IMPROVEMENTS WAS WAIVED BY CLIENT IN ACCORDANCE WITH A-E7.01(2) OF THE WISCONSIN ADDMINISTRATIVE CODE.

- ○ *FOUND 1" IRON PIPE*
- ● *SET 1" IRON PIPE*

RADIUS	LENGTH	CHORD	BEARING	DELTA
434.00'	93.56'	93.36'	N52°48'48"E	12°21'06"

"I hereby certify that I have surveyed the above described property and that the above map is a true representation thereof and shows the size and location of the property, its exterior boundaries, the location of all visible structures and dimension of all principal buildings thereon, boundary fences, apparent easements, roadways and encroachments if any."

"This survey is made for the use of the present owners of the property, and also those who purchase, mortgage or guarantee the title thereto within one year from date hereof."

KETTLE MORAINE SURVEYING INC.
W356 S9050 Godfrey Lane
Eagle Wisconsin 53119
P.O. Box 357
(262) 594-3484
Terrance E. Pisarek R.L.S.

WISCONSIN
TERRANCE E. PISAREK
S-1830
EAGLE
WISCONSIN
LAND SURVEYOR

THIS IS NOT AN ORIGINAL SURVEY UNLESS THE SEAL IS RED.

9/14/04	TEP/DW	TEP	04169
DATE	FIELD WORK BY	DRAWN BY	JOB NUMBER

YHP 00078

004-1795