

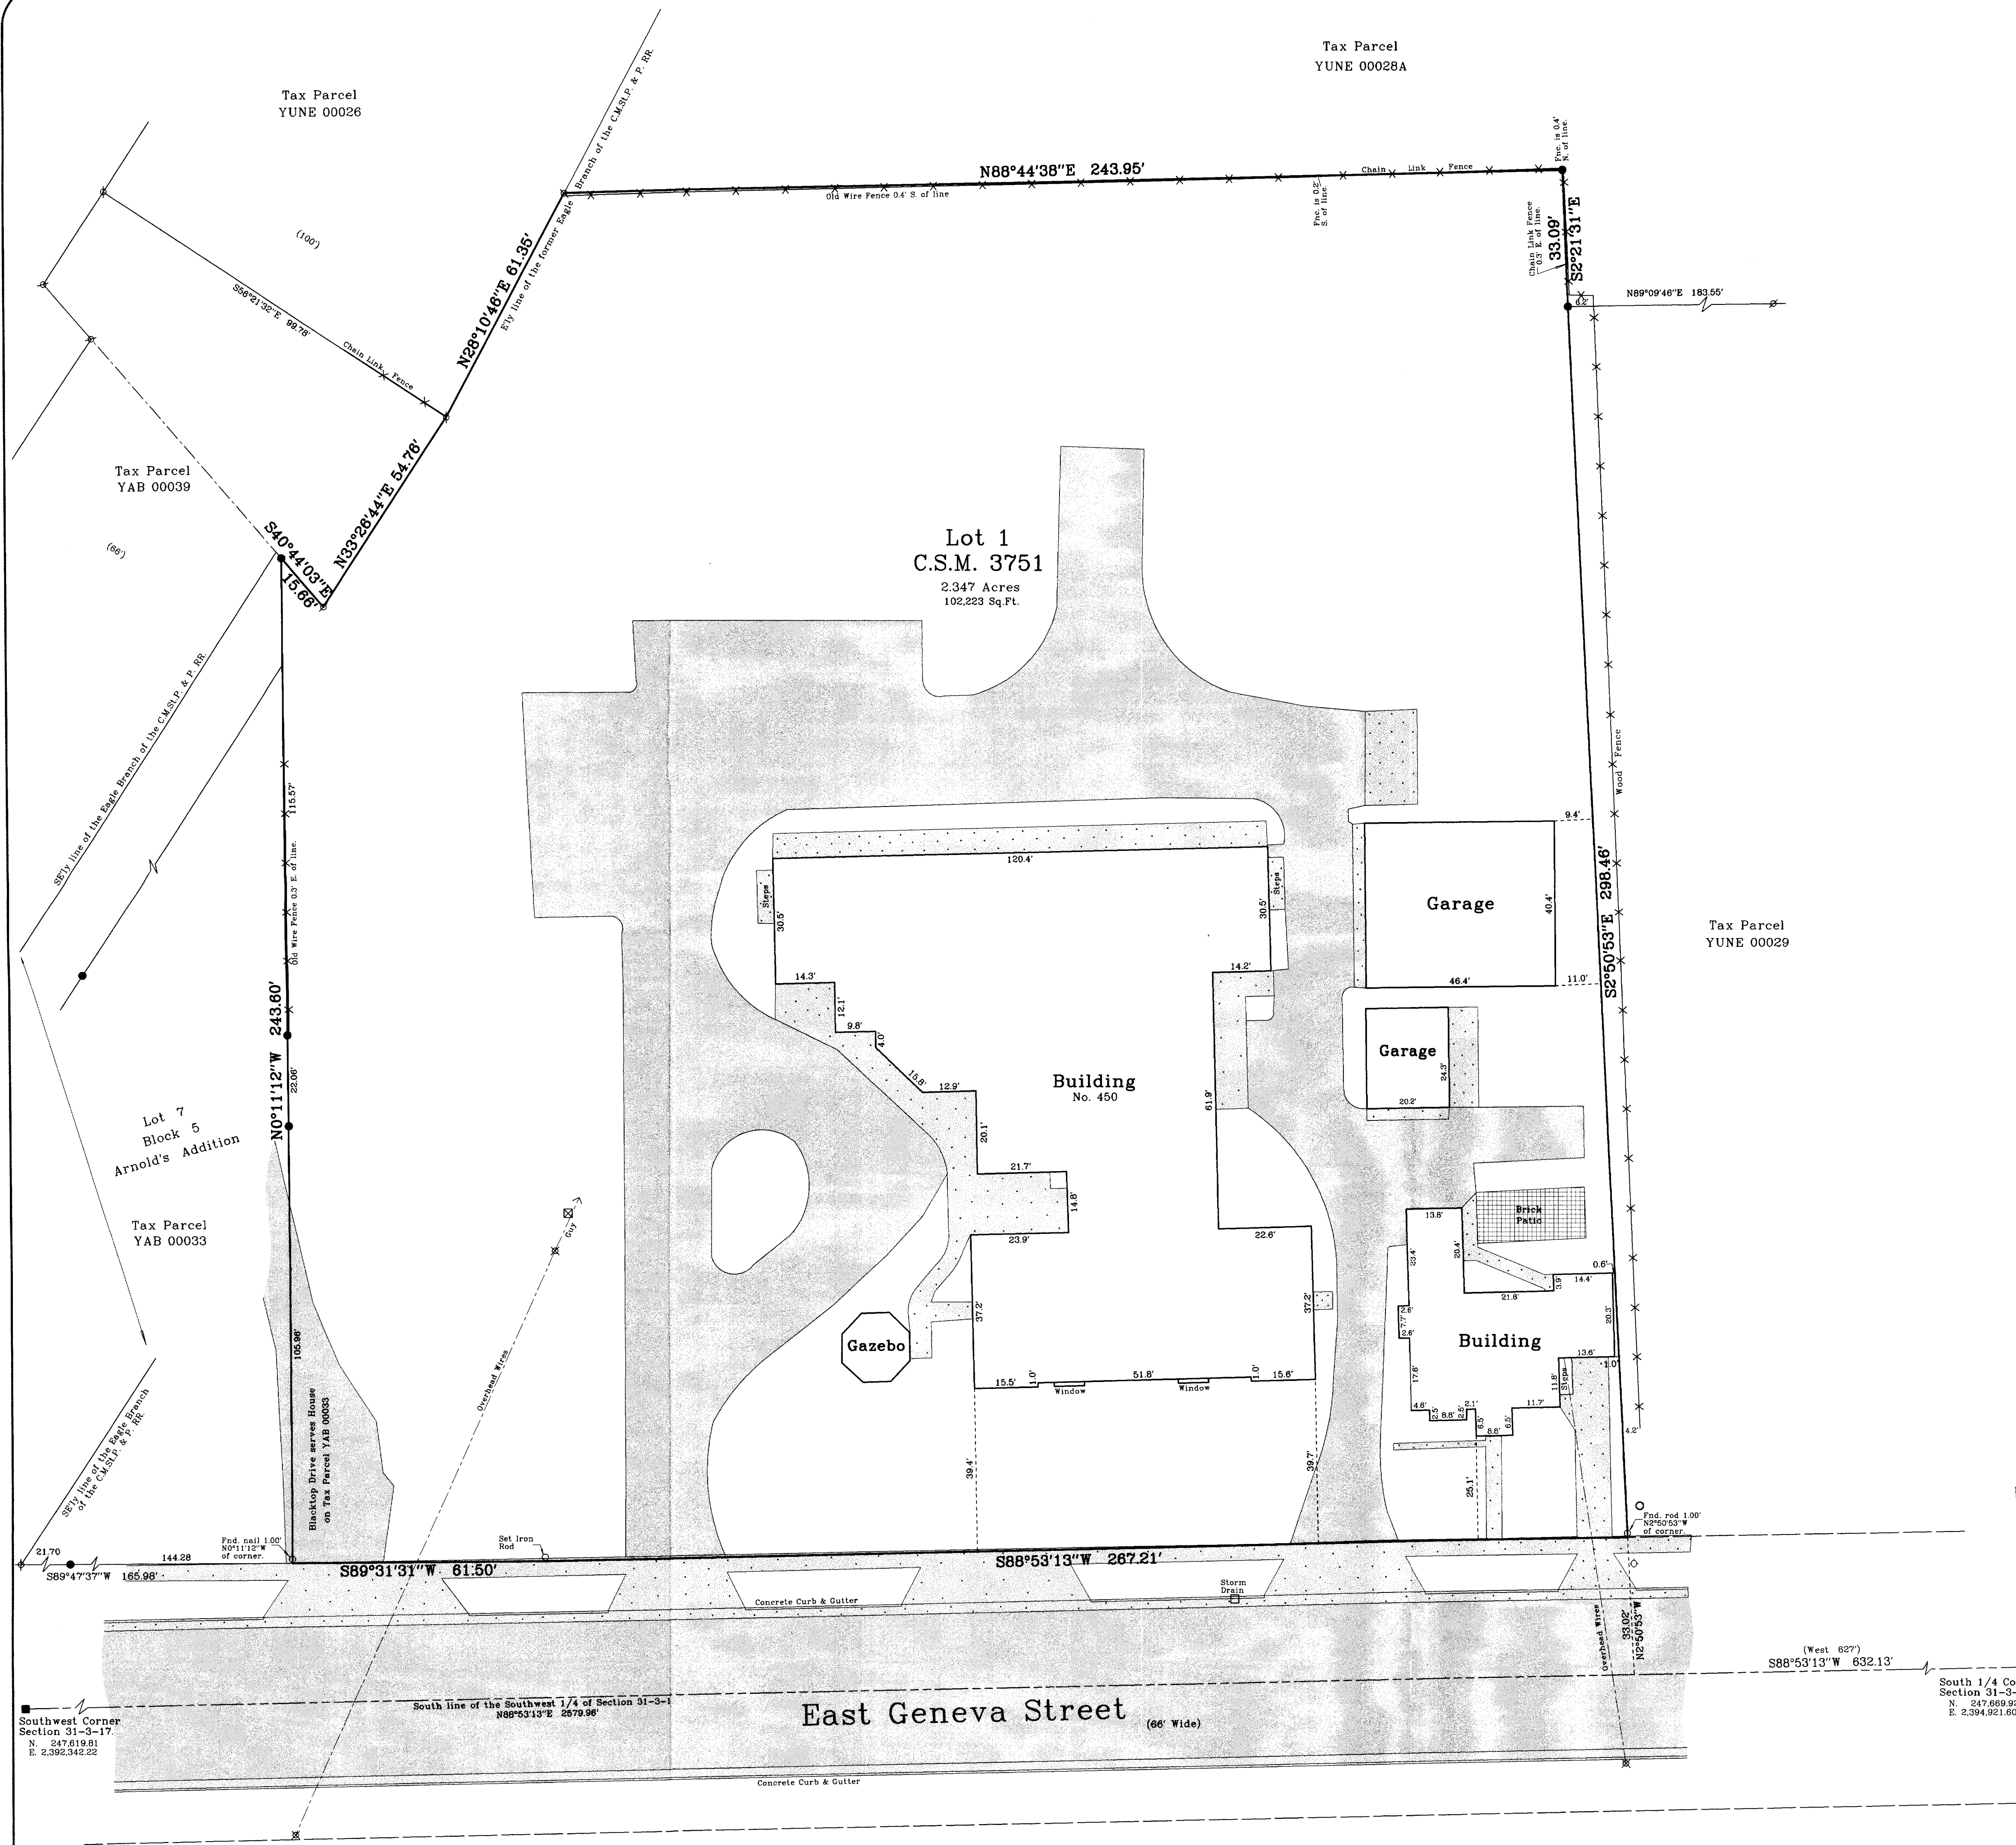


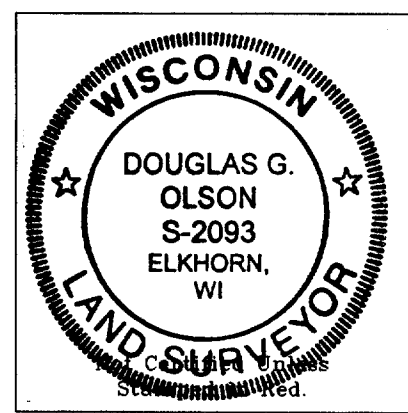

Plat of Survey

of
Lot 1 of Certified Survey Map No. 3751,
recorded in Vol. 22 of Certified Survey Maps of Walworth County
on Page 259 and located in the Southwest 1/4 of Section 31, Town
3 North, Range 17 East, City of Elkhorn, Walworth County, Wisconsin.

Surveyed for: **Kindred Hearts**
17 Applegate Court • Suite 200
Madison, Wisconsin. 53713

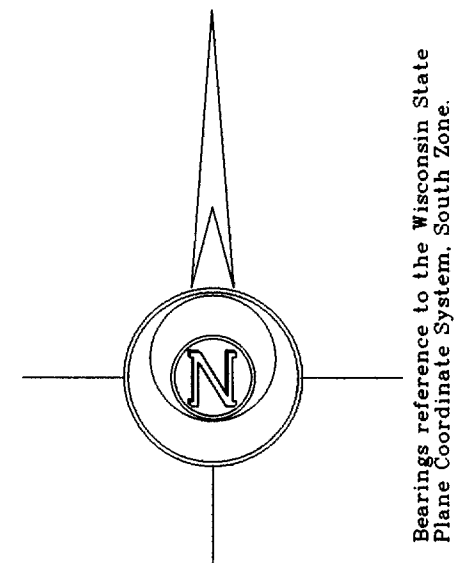


Notes: 1) This survey plat is not certified unless signed and sealed in red ink.
2) This survey is subject to Wisconsin lien laws. This Plat of Survey is the notice of intent to file lien. Lien waiver required.

Copyright © 2004 by Jensen & Olson Land Surveying, LLC.
All rights reserved. No part of this survey plat may be reproduced or transmitted in any form by any means - graphic, electronic, or mechanical, including photocopying, tracing, or information storage and retrieval systems - without permission in writing from Douglas G. Olson, Jensen & Olson Land Surveying, LLC.

I hereby certify that I have surveyed the above described property and the map hereon is correct to the best of my professional knowledge and belief and shows the size and location of the property, its exterior boundaries, the location and dimensions of all visible structures thereon, boundary fences, apparent easements and roadways and visible encroachments, if any.
This survey is made for the exclusive use of the present owners of property, and also those who purchase, mortgage or guarantee title thereto, within one year from the date hereof.

Douglas G. Olson
Wisconsin Registered Land Surveyor - 2093

Survey date: December 21, 2004.
Revisions:

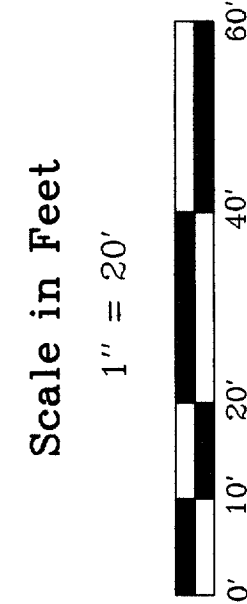

Jensen & Olson Land Surveying, LLC

45 South Wisconsin Street P.O. Box 322
Elkhorn, Wisconsin. 53121
Telephone: (262) 723-3434
Facsimile: (262) 723-8044

- Legend**
- Found County Section Corner
 - Found Iron Rod
 - Found Iron Nail
 - Set Iron Rod or Found Nail
 - Information
 - Utility Pole
 - Utility Box or Pedestal
 - Fire Hydrant
 - Asphalt Surface
 - Concrete Surface

Sheet 1 of 1 Sheets.

Job Reference Number
2004.205

2004.205

004-1821

2004.205