
GRID NORTH


WISCONSIN STATE PLANE COORDINATE SYSTEM
SOUTH ZONE
N. LINE OF THE NW 1/4 OF SEC. 31-3-17
BEARS S 88°45'48" W

PLAT OF SURVEY

PART OF TAX PARCEL UNE-7

BEING LOTS 1 & 2
PROPOSED FAIR MEADOW SUBDIVISION
LOCATED IN SECTION 31
TOWN 3 NORTH, RANGE 17 EAST, CITY OF ELKHORN
WALWORTH COUNTY, WISCONSIN

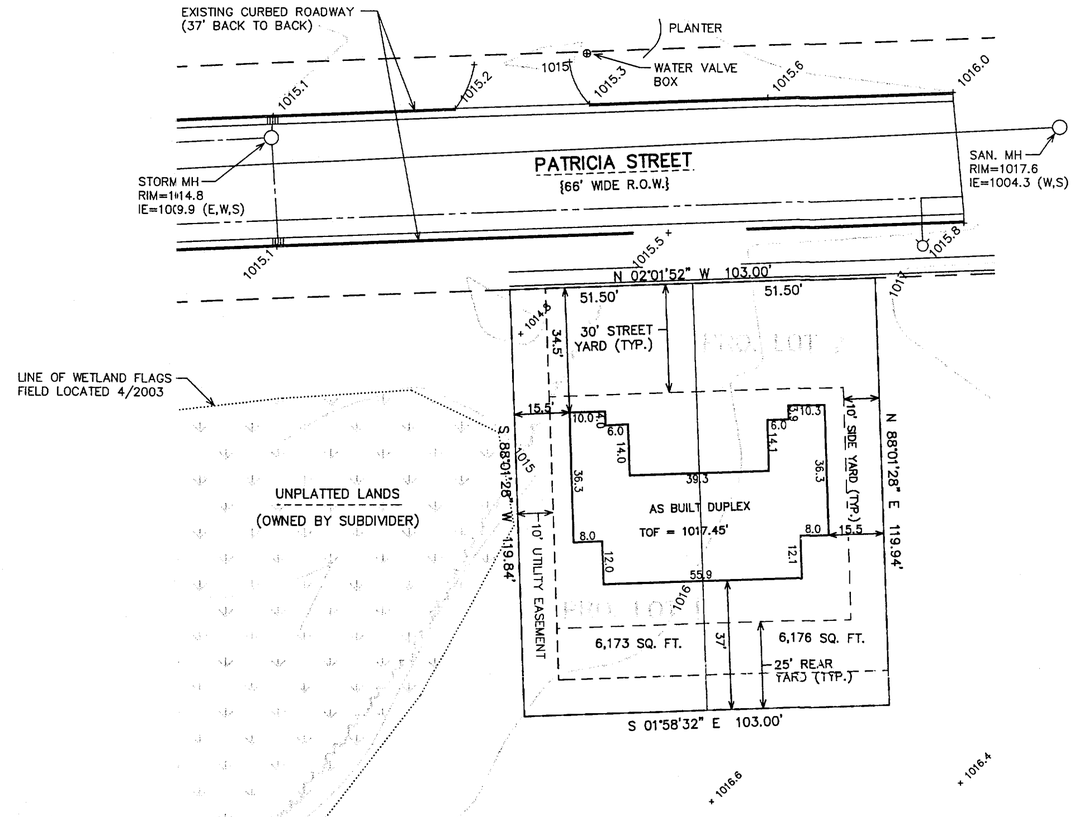

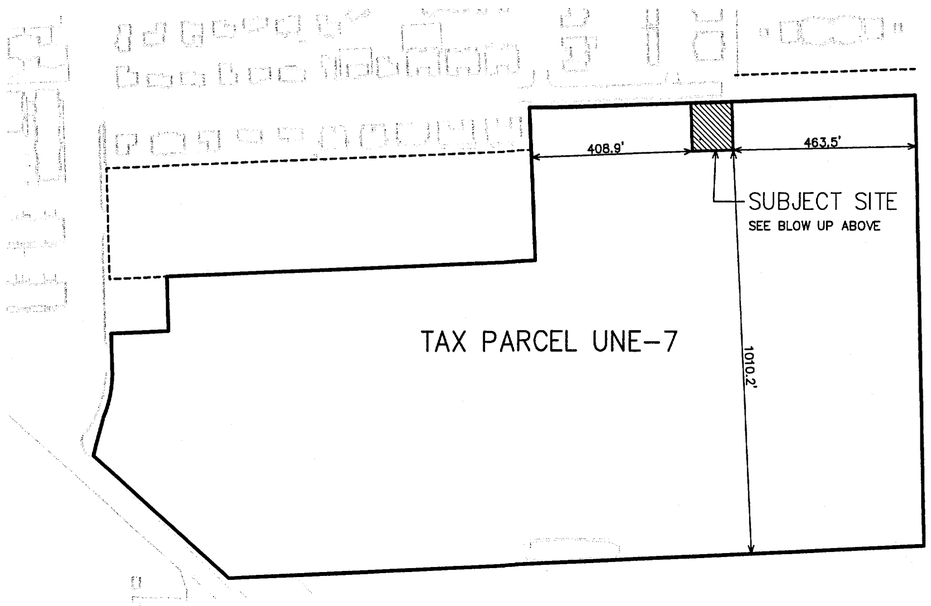

NOTE: PROPOSED LOTS 1 & 2 ARE PART OF TAX PARCEL UNE-7 BEING DIVIDED IN THE FUTURE. THIS PERMIT PLAT IS FOR 1 PROPOSED DUPLEX ON THE CURRENTLY VACANT UNE-7.

100 90 80 70 60 50 40 30 20 10 0 50 100
MAP SCALE IN FEET ORIGINAL 1" = 30'

NOTE: COPIES OF THIS MAP TO WHICH THE FOLLOWING CERTIFICATE WILL APPLY SHOW SURVEYOR'S ORIGINAL SEAL AND SIGNATURE IN RED INK. COPIES BY ANY OTHER MEANS MAY HAVE ALTERATIONS WHICH DO NOT REPRESENT THE SURVEYOR'S WORK PRODUCT.

I HEREBY CERTIFY THAT THE ABOVE DESCRIBED PROPERTY HAS BEEN SURVEYED UNDER MY DIRECTION AND THAT THE ABOVE MAP IS A TRUE REPRESENTATION THEREOF AND SHOWS THE SIZE AND LOCATION OF THE PROPERTY AND ITS EXTERIOR BOUNDARIES. THIS SURVEY IS MADE FOR THE USE OF THE PRESENT OWNERS OF THE PROPERTY, AND ALSO THOSE WHO PURCHASE, MORTGAGE, OR GUARANTEE THE TITLE THERETO WITHIN ONE YEAR FROM THE DATE HEREOF.

RECEIVED
MAY 23 2005

DATED: DECEMBER 23, 2004

REVISED 05-18-2005
TO SHOW SIZE & LOCATION
OF AS BUILT DUPLEX

PETER S. GORDON R.L.S. 2101

WORK ORDERED BY:
FARLEY NESHEK CORP.
PO BOX 75
ELKHORN, WI. 53121

FARRIS, HANSEN & ASSOCIATES, INC.
ENGINEERING - ARCHITECTURE - SURVEYING
7 RIDGWAY COURT P.O. BOX 437
ELKHORN, WISCONSIN 53121
OFFICE: (262) 723-2098 FAX: (262) 723-5886

REVISIONS
01/03/2005
MISC. REVISIONS

PROJECT NO.
6104.01

DATE:
12-23-04

SHEET NO.
1 OF 1

5/18/2005 X:\Projects\6104\INDIV_LOTS\LOTS_1_&_2\Lot1_2

MAY 17 2005

YFM 00001
YFM 00002

004-1863