
PLAT OF SURVEY

RSV
ENGINEERING, INC.
Engineers • Land Surveyors • Environmental Scientists
801 MAIN STREET MUKWONAGO, WISCONSIN 53149 (262)363-2004

RECERTIFICATION: 04/21/2005
DATE: 12/06/2004

FOR: INFINITY BUILDERS

DESCRIPTION: BEING ALL THAT PART OF LOT 140 THE PINES SUBDIVSION, LOCATED IN PART OF THE NW, NE, SW, AND SE1/4'S OF THE SW1/4 AND THE SW AND NW1/4'S OF THE SE1/4 OF SECTION 5, TOWN 2 NORTH, RANGE 17 EAST, CITY OF ELKHORN, WALWORTH COUNTY, WISCONSIN.

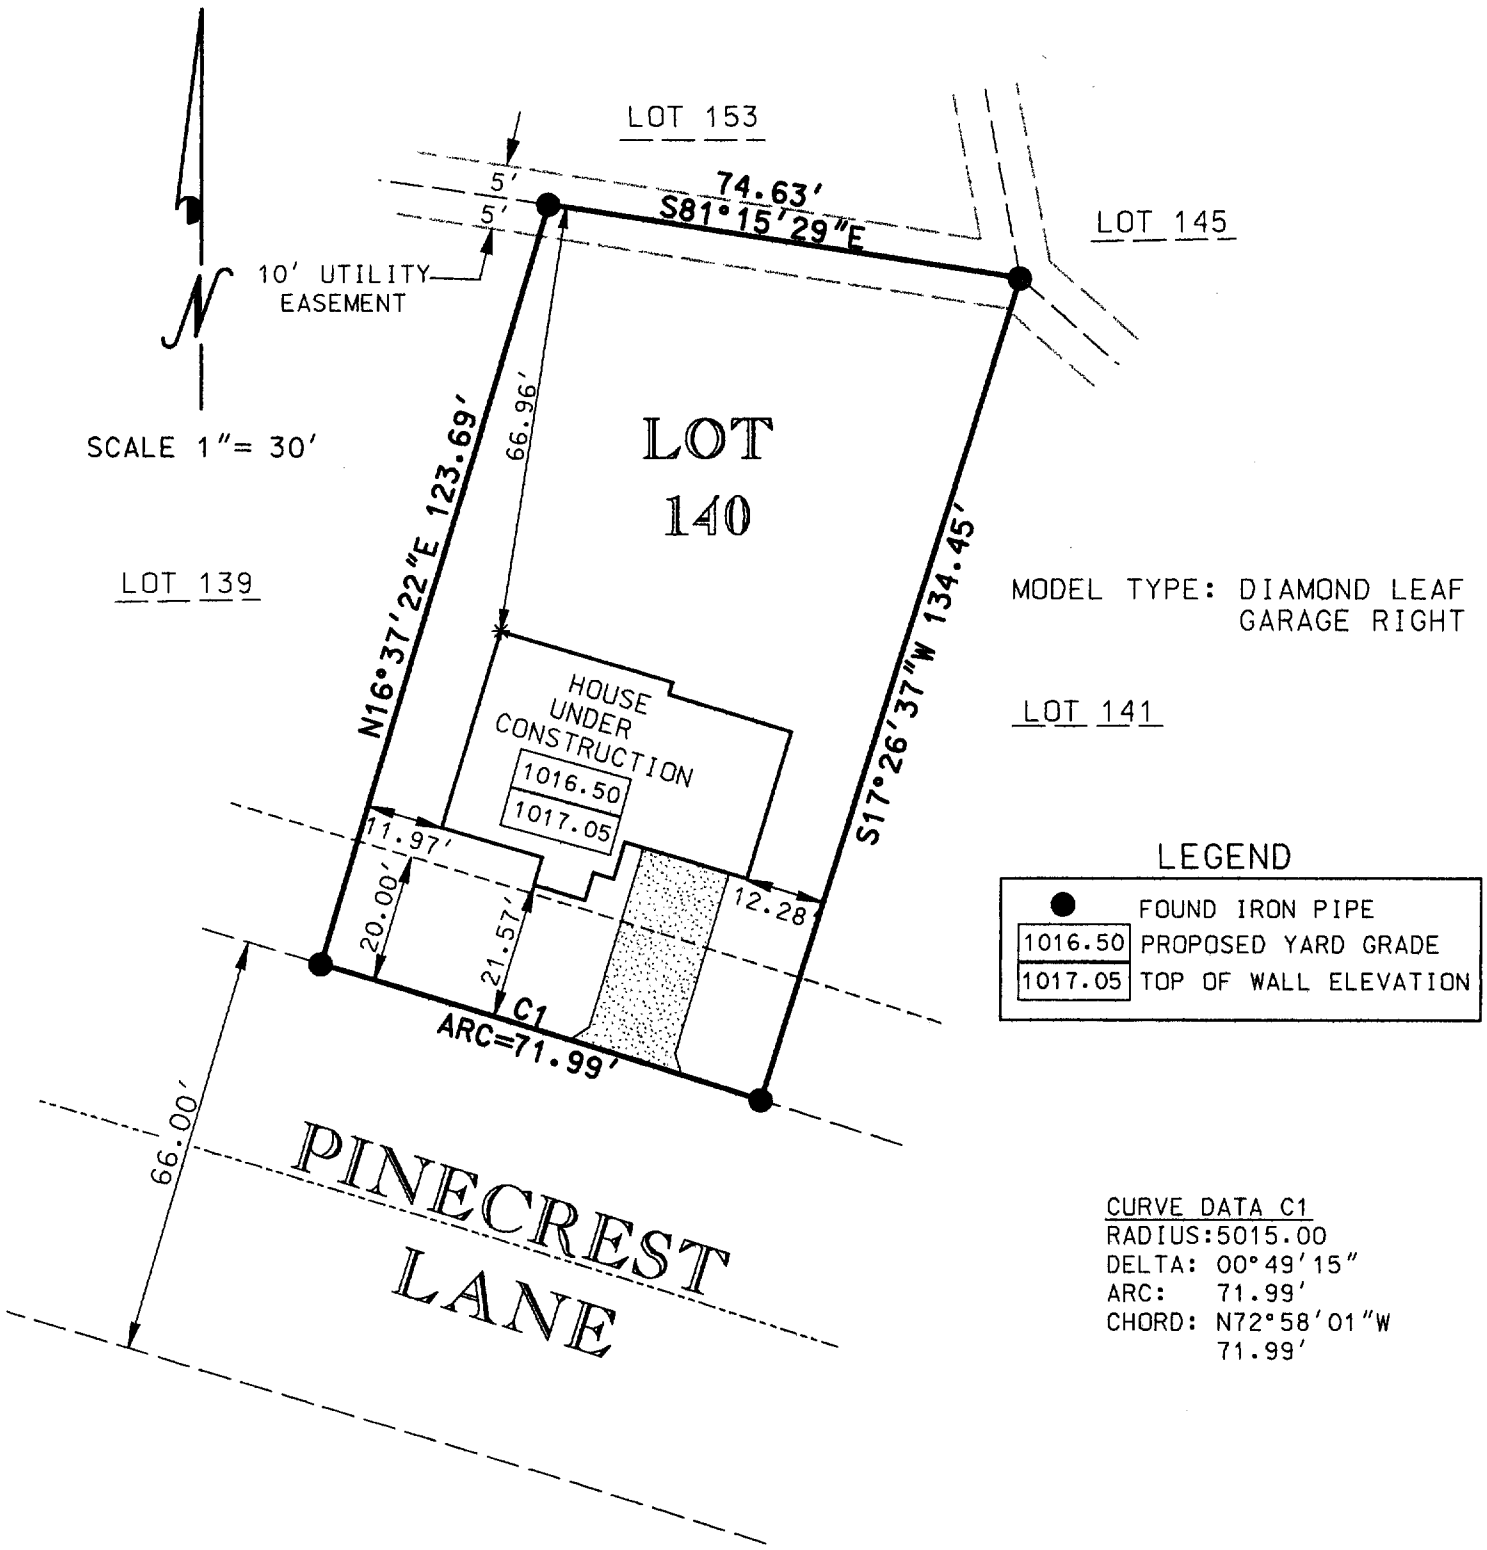

MODEL TYPE: DIAMOND LEAF
GARAGE RIGHT

LEGEND

●	FOUND IRON PIPE
1016.50	PROPOSED YARD GRADE
1017.05	TOP OF WALL ELEVATION

CURVE DATA C1
RADIUS: 5015.00
DELTA: 00°49'15"
ARC: 71.99'
CHORD: N72°58'01"W 71.99'

I PAUL H. VAN HENKELUM R.L.S. # 1931 HEREBY CERTIFY THAT THIS SURVEY WAS MADE IN ACCORDANCE WITH THE MINIMUM STANDARDS FOR PROPERTY SURVEYS (CHAPTER A-E7) STATE OF WISCONSIN AND HAS BEEN PREPARED UNDER MY DIRECTION AND CONTROL AND IS CORRECT TO THE BEST OF MY KNOWLEDGE AND BELIEF.

WISCONSIN
PAUL H.
VAN HENKELUM
S-1931
MUKWONAGO

4/25/05

PAUL H. VAN HENKELUM, R.L.S. # 1931
RSVDATA6/04'SURVEYS/J04279recrt.dgn

YPI 00140

004-1882