
52-18 (6)

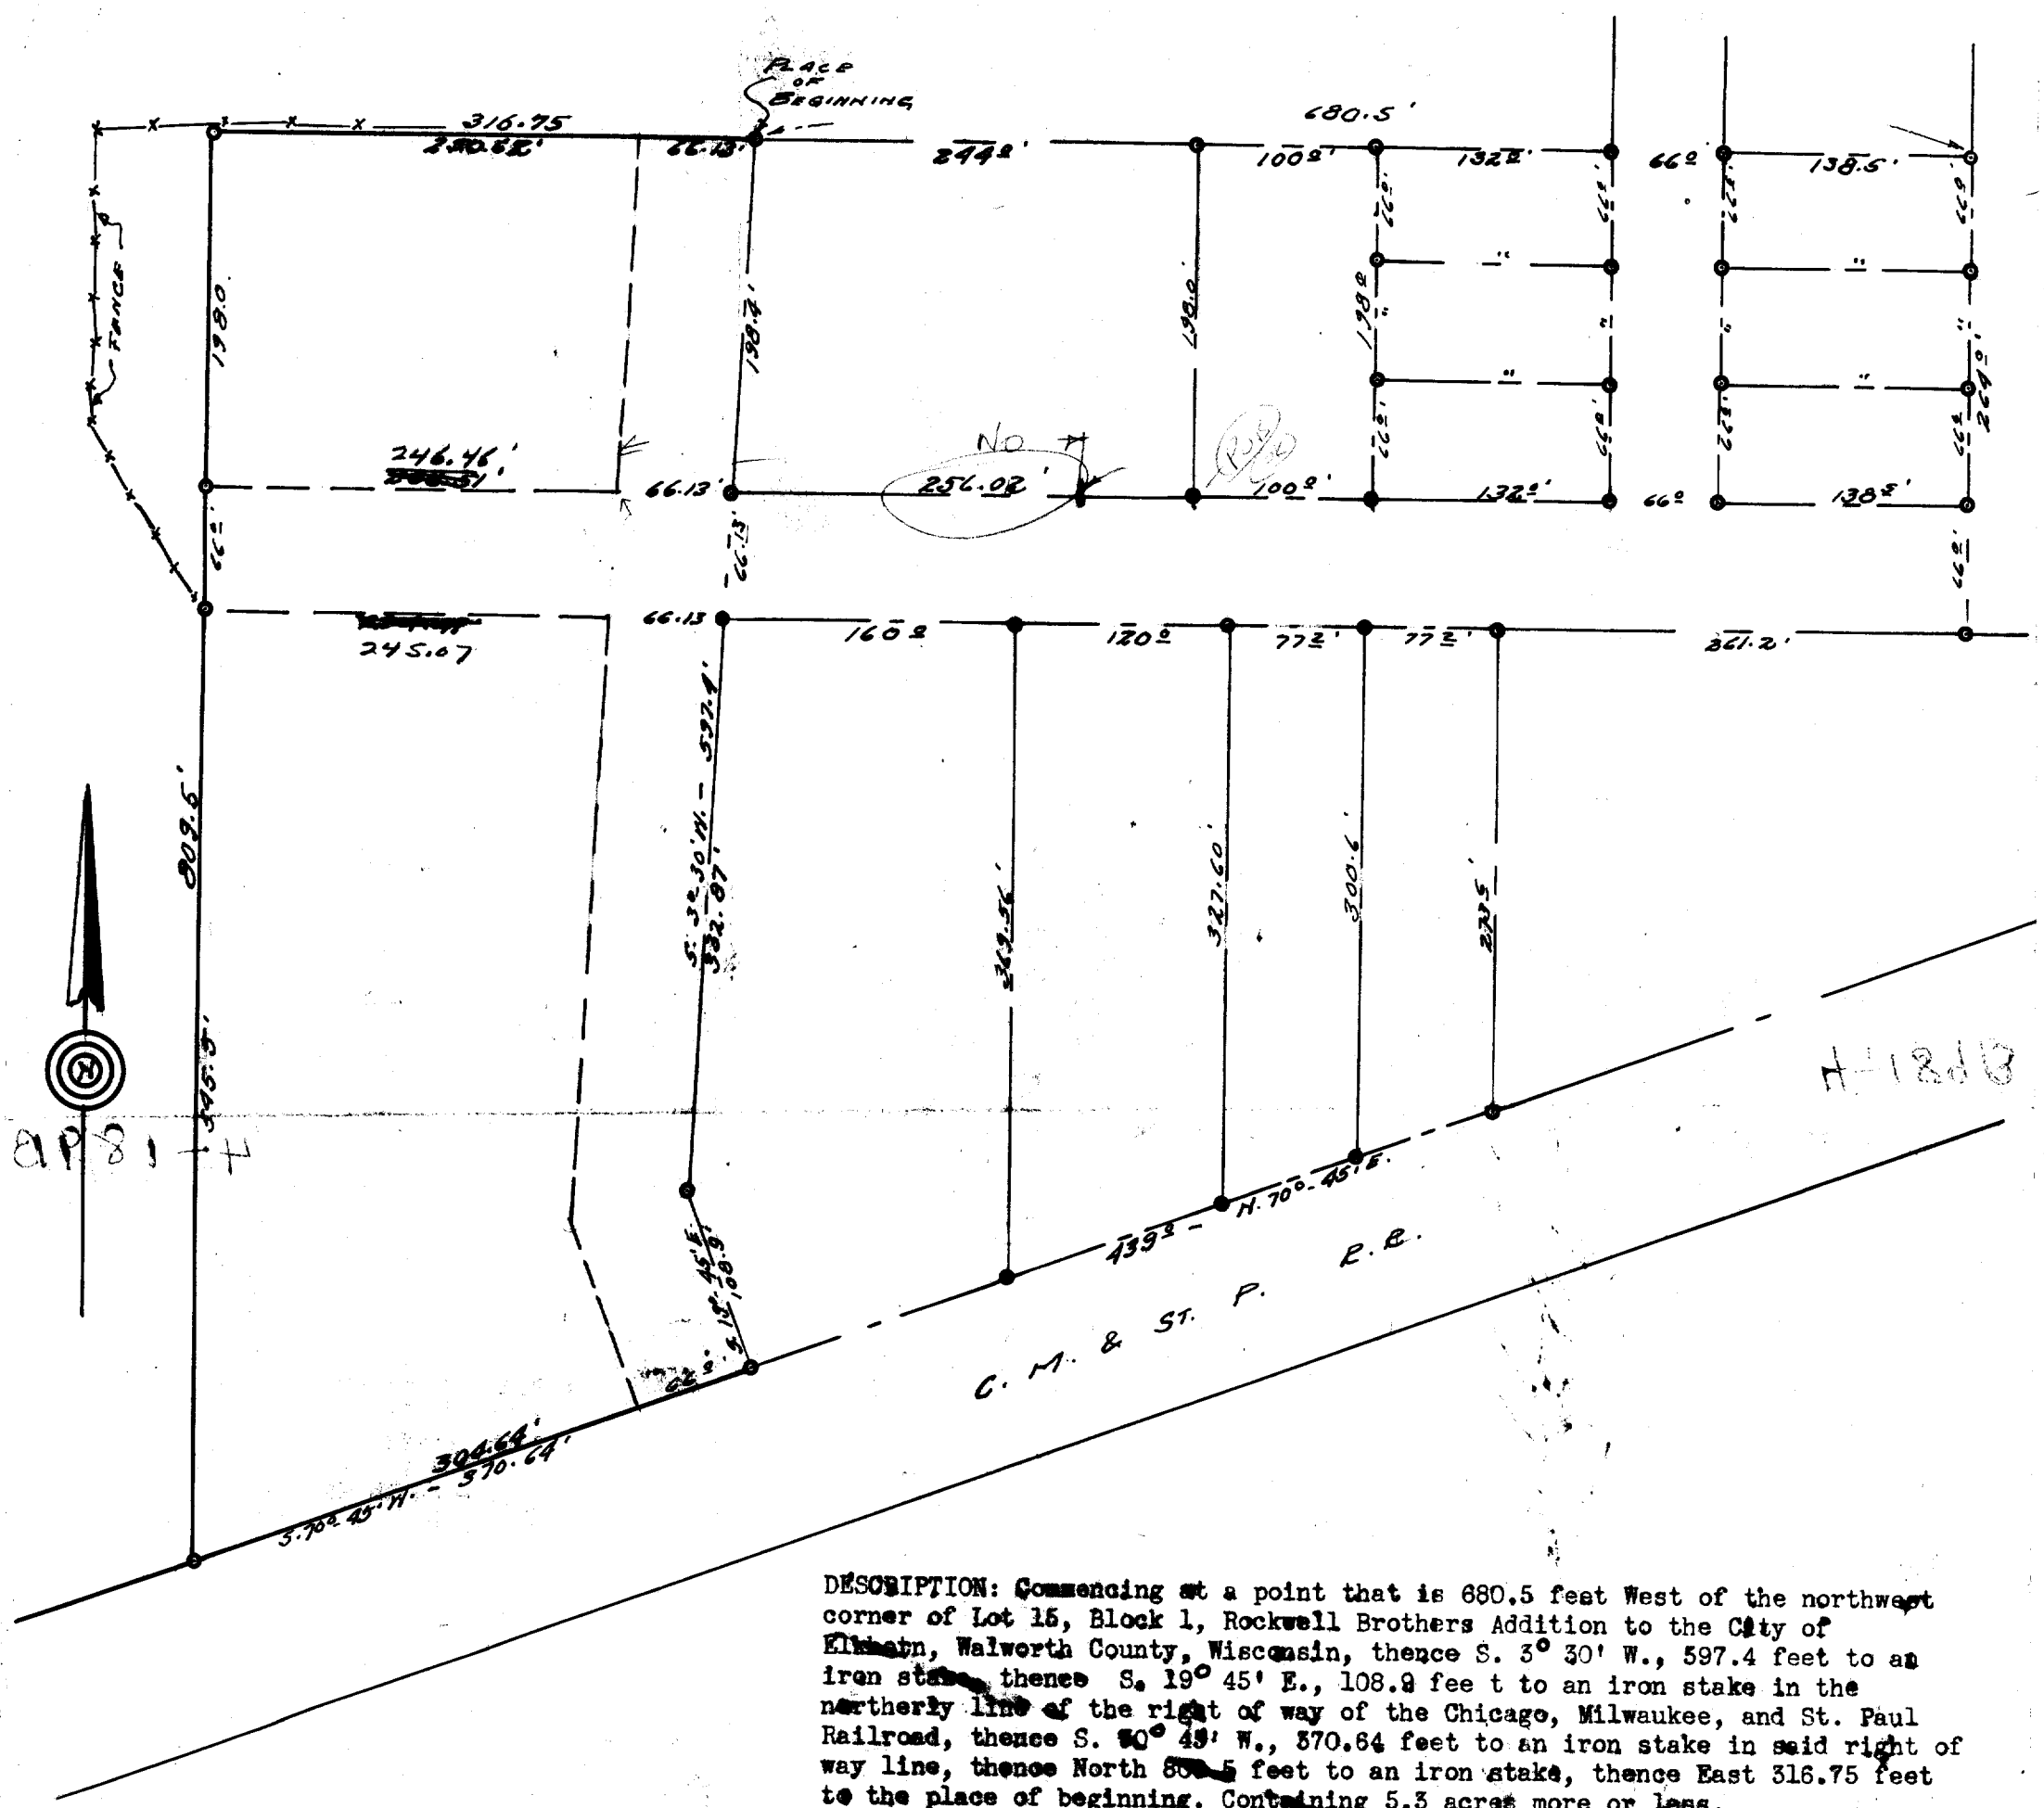

DESCRIPTION: Commencing at a point that is 680.5 feet West of the northwest corner of Lot 15, Block 1, Rockwell Brothers Addition to the City of Elkhorn, Walworth County, Wisconsin, thence S. 3° 30' W., 597.4 feet to an iron stake, thence S. 19° 45' E., 108.9 fee t to an iron stake in the northerly line of the right of way of the Chicago, Milwaukee, and St. Paul Railroad, thence S. 70° 45' W., 570.64 feet to an iron stake in said right of way line, thence North 802.6 feet to an iron stake, thence East 316.75 feet to the place of beginning. Containing 5.3 acres more or less.

CERTIFICATE: I, hereby certify that I have on this the 16th day of December 1952., surveyed the above described property, and the above plat of survey is a correct and accurate portrayal of said survey and that no encroachments exist.

SIGNED AND SEALED ON THIS THE EIGHTEENTH DAY OF DECEMBER 1952.

Joseph M. Biagi. Professional Engineer.
Elkhorn Wisconsin.

4-189

4USW-46C, 46O, 53F

4-SW-53B, 53A, 53C + 4-SW-46 80A, 50

4-189