
HOME OFFICE
116 E. CHESTNUT STREET
BURLINGTON, WISCONSIN 53105
PHONE: 414-763-2652
414-763-7834

**ROBERS & BOYD, INC.**
CONSULTING ENGINEERS
LAND SURVEYORS

BRANCH OFFICE
809 - 43RD STREET
KENOSHA, WISCONSIN 53140
PHONE: 414-658-4488

# PLAT OF SURVEY AND PROPOSED HOUSE LOCATION FOR SOUTHEASTERN WISCONSIN HOUSING CORPORATION OF

Lot 34 of Landmark Subdivision, Addition #1, City of Elkhorn, Walworth County, Wisconsin.

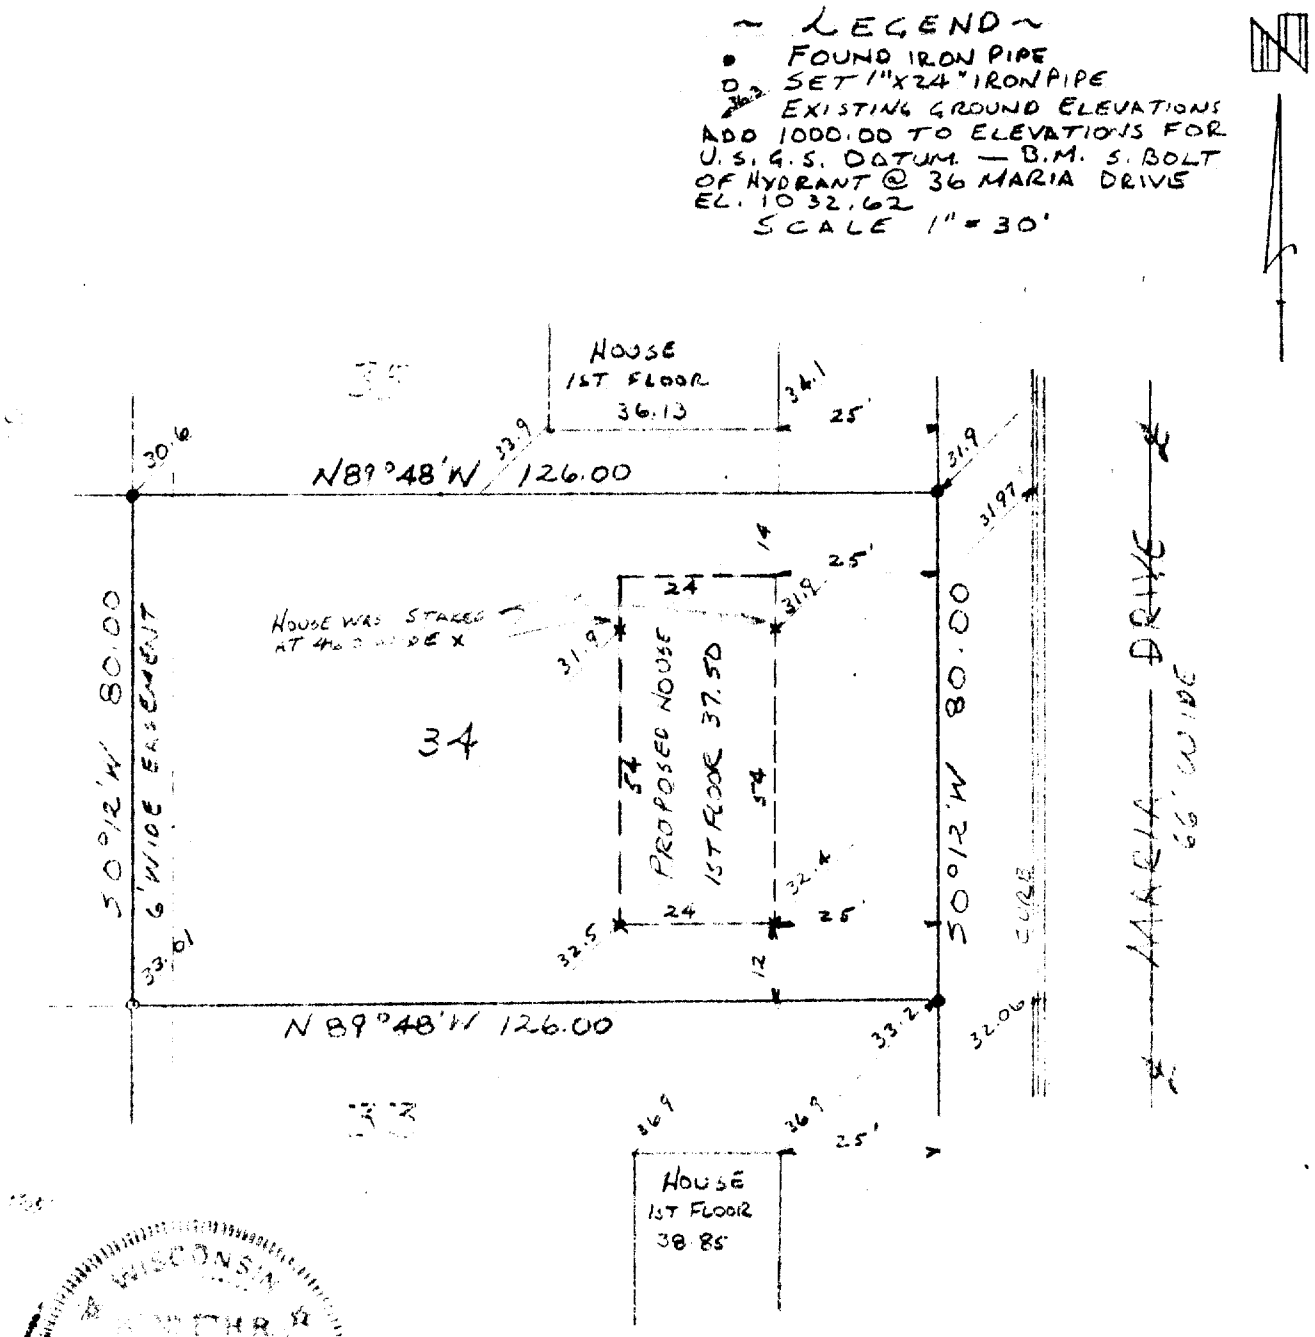


"I CERTIFY THAT I HAVE SURVEYED THE ABOVE DESCRIBED PROPERTY AND THAT THE ABOVE PLAT IS AN ACCURATE SURVEY AND A TRUE REPRESENTATION THEREOF AND CORRECTLY SHOWS THE EXTERIOR BOUNDARY LINES AND LOCATION OF BUILDINGS [redacted] ON SAID PROPERTY AND THE CORRECT MEASUREMENTS THEREOF."

Kimer R. Pearson
WISCONSIN REGISTERED LAND SURVEYOR

10/17/77
DATE

4-193
77240
JOB NUMBER

K & E 10-7155 250 YLSA-15

4-193