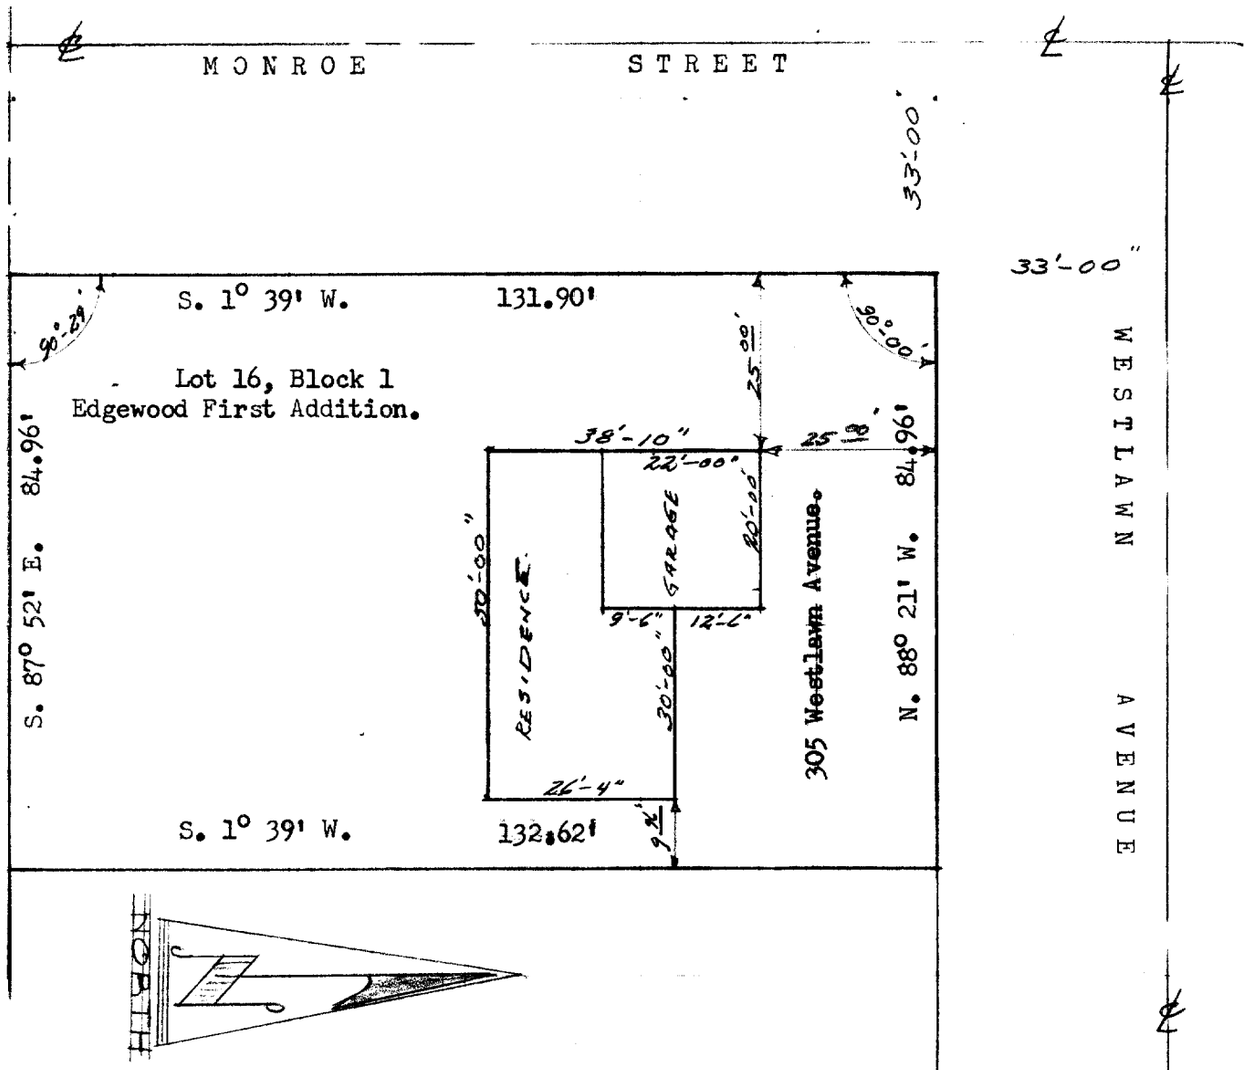

DESCRIPTION: Lot 16 Block 1, Edgewood First Addition to the City of Elkhorn, ~~Walworth County, Wisconsin.~~

CERTIFICATE: I, James F. Biagi, Surveyor do hereby certify that I have surveyed the property hereon described on this the 16th day of December, 1965.

James F. Biagi

James F. Biagi, RLS 272
Elkhorn, ~~Wisconsin~~

Dated: December 16th 1965.

WISCONSIN
JAMES F.
BIAGI
MILWAUKEE,
WIS.
LAND SURVEYOR

YEA L-18

4-18