PREPARED FOR:


DEBBIE SARNA
REMAX SOUTHERN LAKES
12 ELIZABETH LANE
GENOA CITY, WI
53128

PLAT OF SURVEY

- OF -

LOT 35 , BLOCK 1, ELKHORN ESTATES , LOCATED IN SECTION 1, TOWN 2 NORTH , RANGE 16 EAST , CITY OF ELKHORN, WALWORTH COUNTY, WISCONSIN.

PATHFINDER SURVEYING INC.
UNIT D W2888 KRUGER RD.
LAKE GENEVA WI. 53147

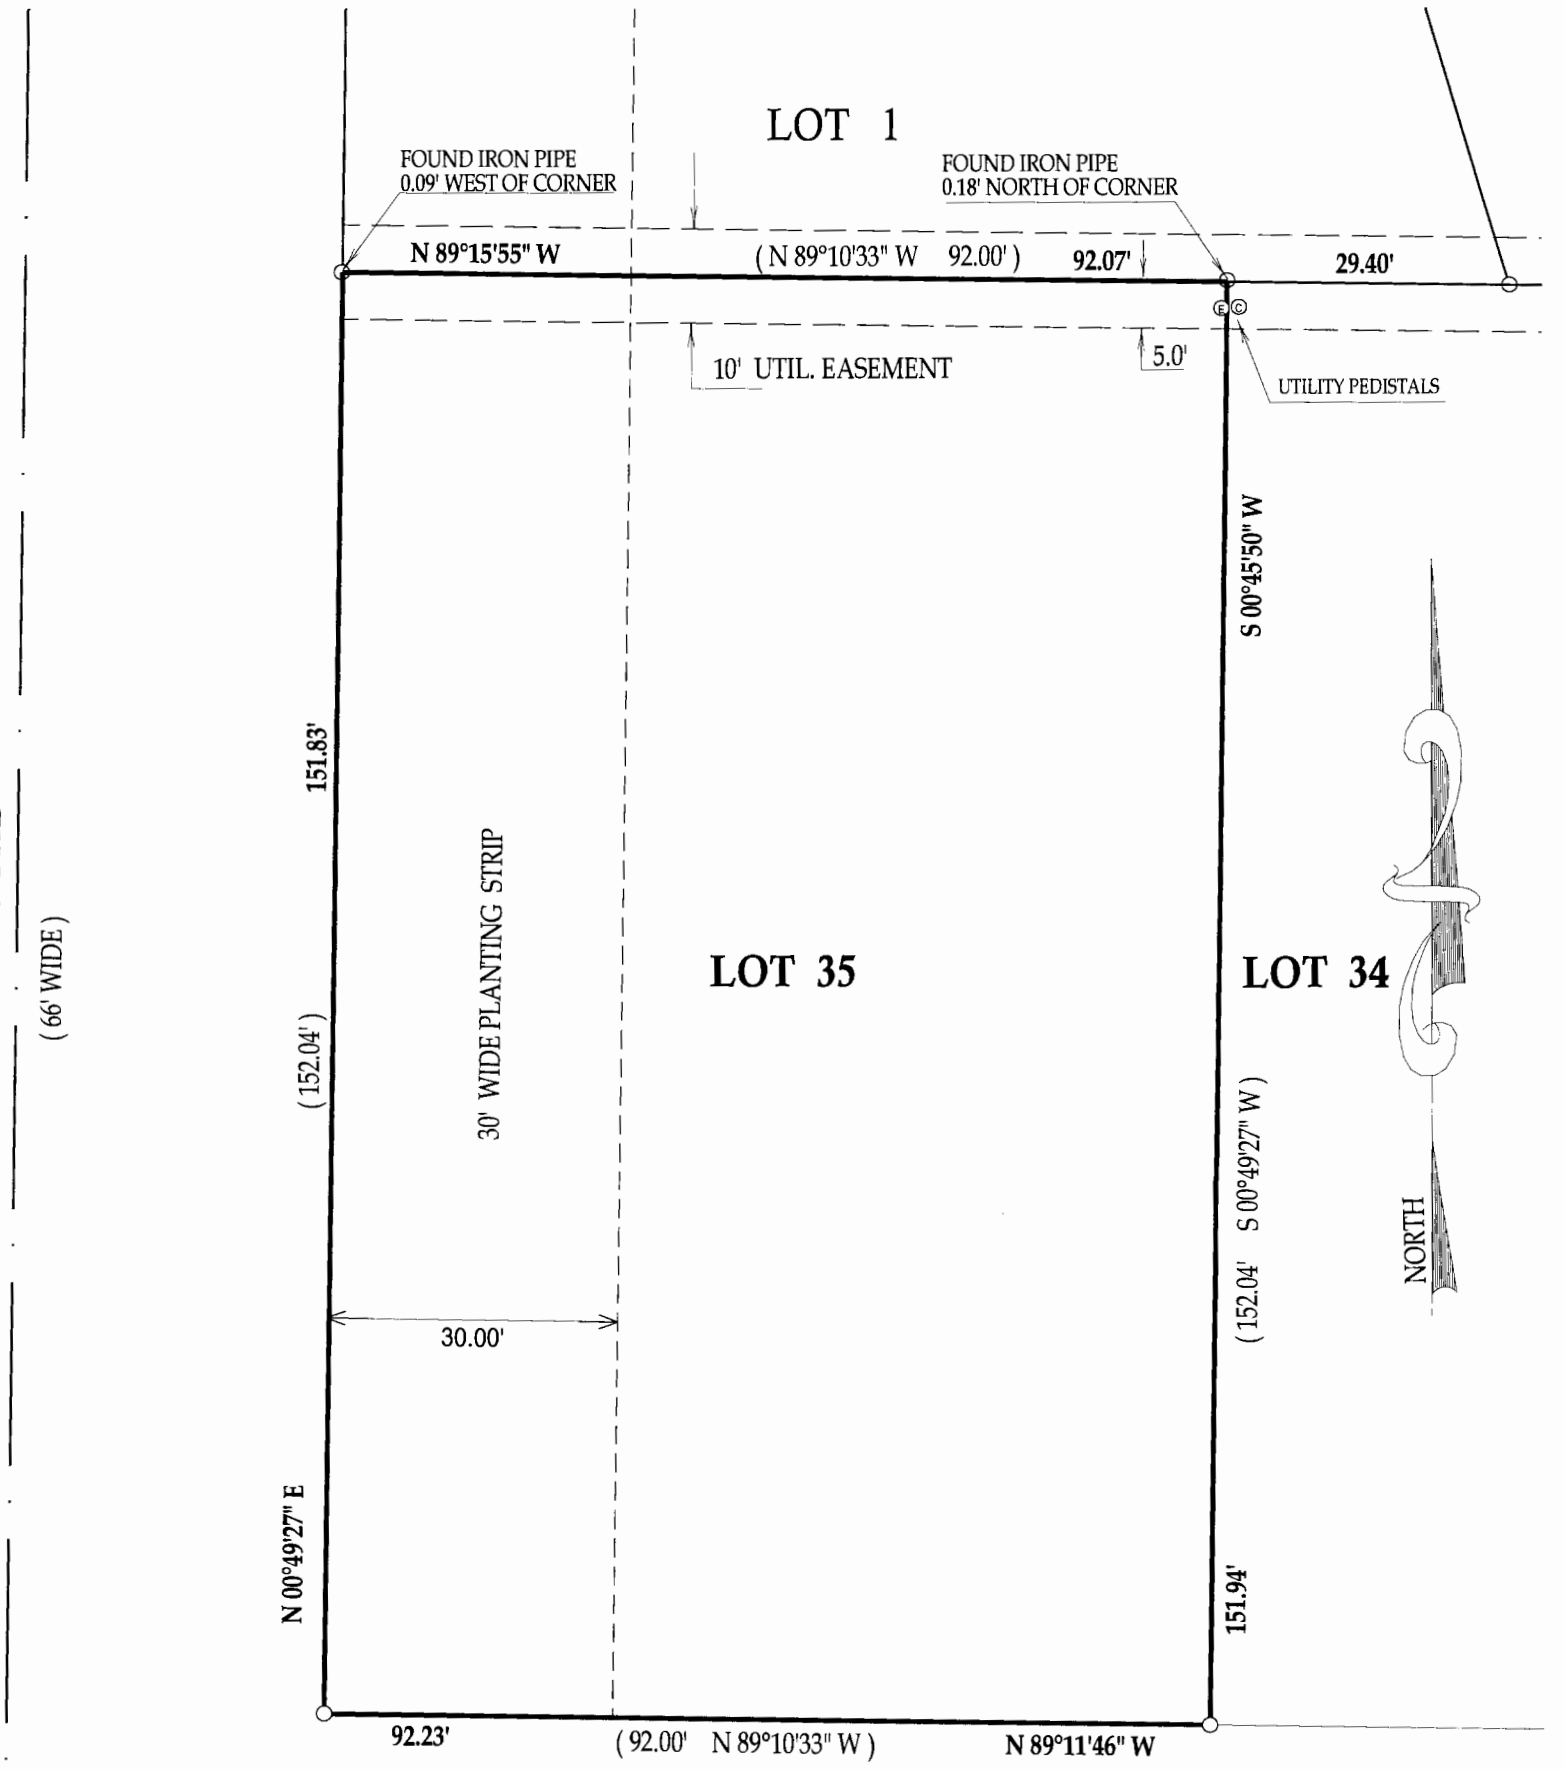

C.L. MARSH ROAD
(66' WIDE)

C.L. SUNNYSIDE DRIVE
(66' WIDE)

RECEIVED
JUL 28 2006

( )= recorded as
□ = found iron bar
○ = found iron pipe
● = set iron pipe
■ = set iron bar

COMPARE LEGAL DESCRIPTION ABOVE AND DRAWING WITH DEED. FOR BUILDING RESTRICTIONS AND EASEMENTS NOT SHOWN,REFER TO DEED, ABSTRACT SOURCES AND LOCAL MUNICIPAL CODES. NOTIFY THE SURVEYOR IMMEDIATELY OF ANY DISCREPANCY.

"I hereby certify that I have surveyed the above described property and that the above map is a true representation thereof and shows the size and location of all visible structures, apparent easements and encroachments if any."
This survey is made for the present owners of the property, and those who purchase, mortgage, or guarantee the title thereto, within one year from the date hereof.

WISCONSIN
JOHN P.
KROTT
S-2258
LAKE GENEVA
WIS.
LAND SURVEYOR

SCALE 1" = 20'

JOB # 06-294

TAX ID # YEE00035

DATED THIS 12th, DAY OF JUNE , 2006

JOHN KROTT S - 2258
Wisconsin Registered Land Surveyor
(original if signed in red)

004-2055