
#184-68

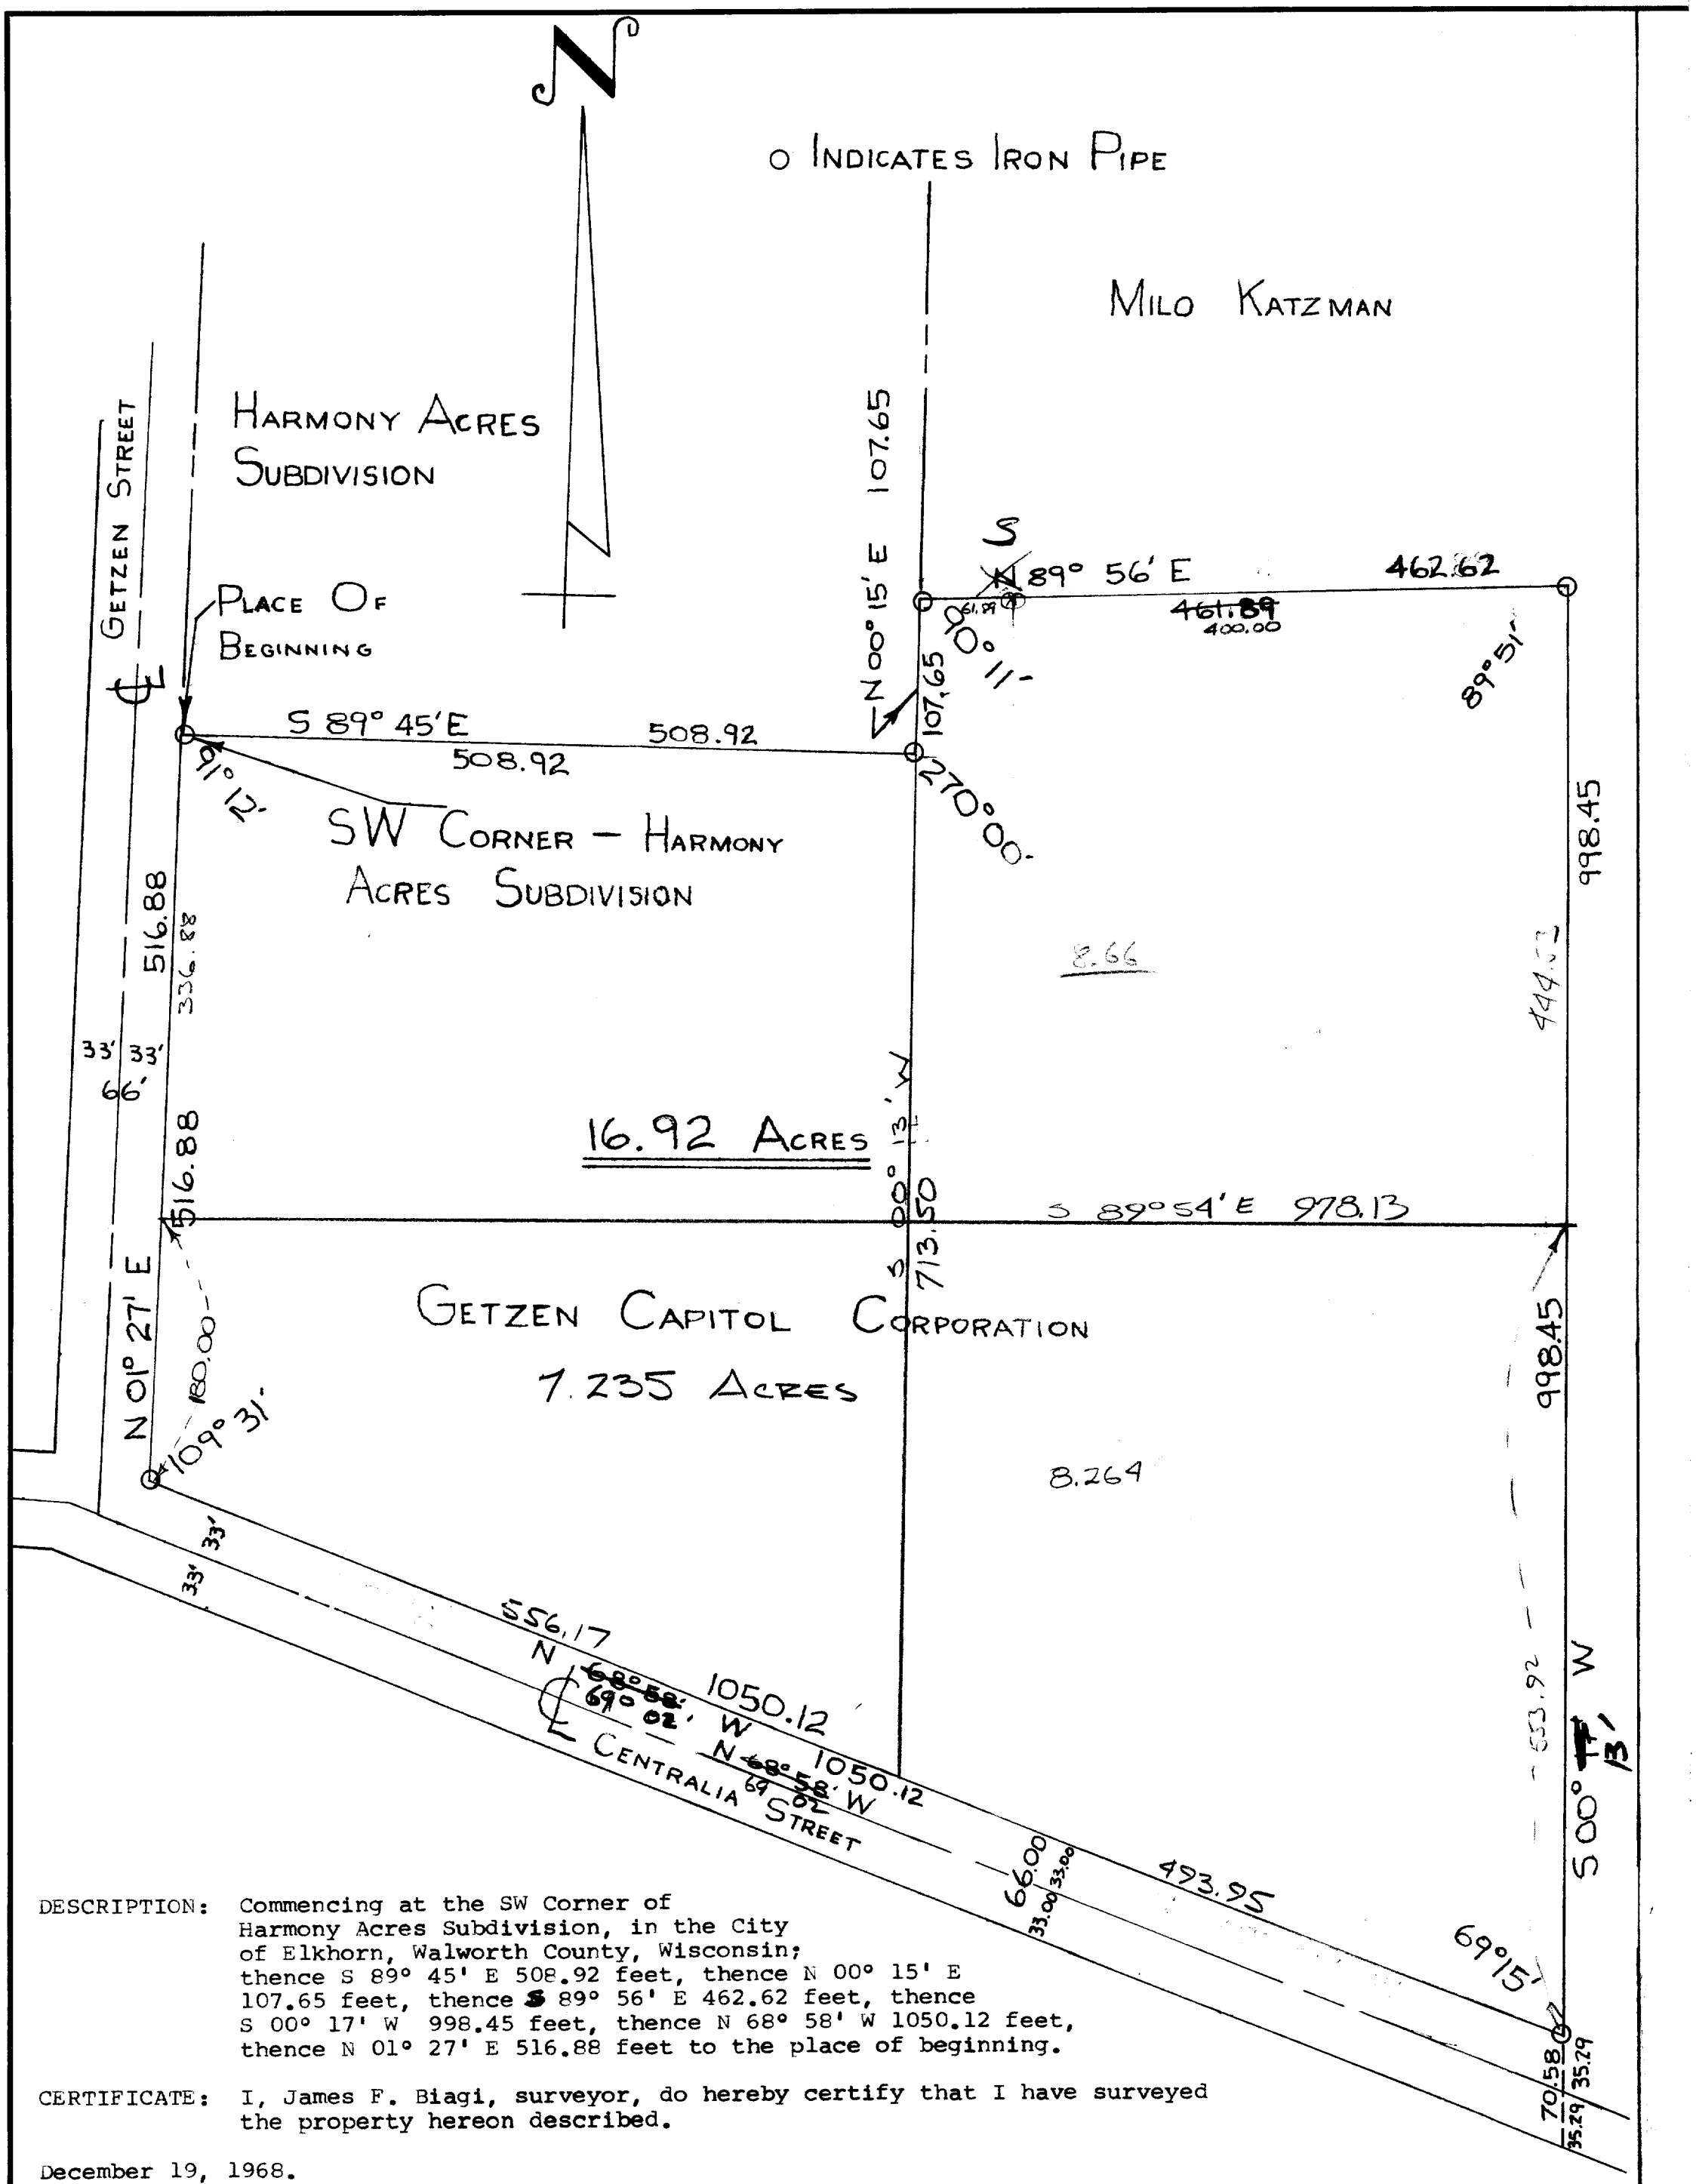

DESCRIPTION: Commencing at the SW Corner of Harmony Acres Subdivision, in the City of Elkhorn, Walworth County, Wisconsin; thence S 89° 45' E 508.92 feet, thence N 00° 15' E 107.65 feet, thence S 89° 56' E 462.62 feet, thence S 00° 17' W 998.45 feet, thence N 68° 58' W 1050.12 feet, thence N 01° 27' E 516.88 feet to the place of beginning.

CERTIFICATE: I, James F. Biagi, surveyor, do hereby certify that I have surveyed the property hereon described.

December 19, 1968.

James F. Biagi

James F. Biagi RLS 272

POST NO. 175HP—18X24

V-SE-9, V-SE-9K, V-SE-9L & Harmony Acres 1st Add

4-205B