54-16

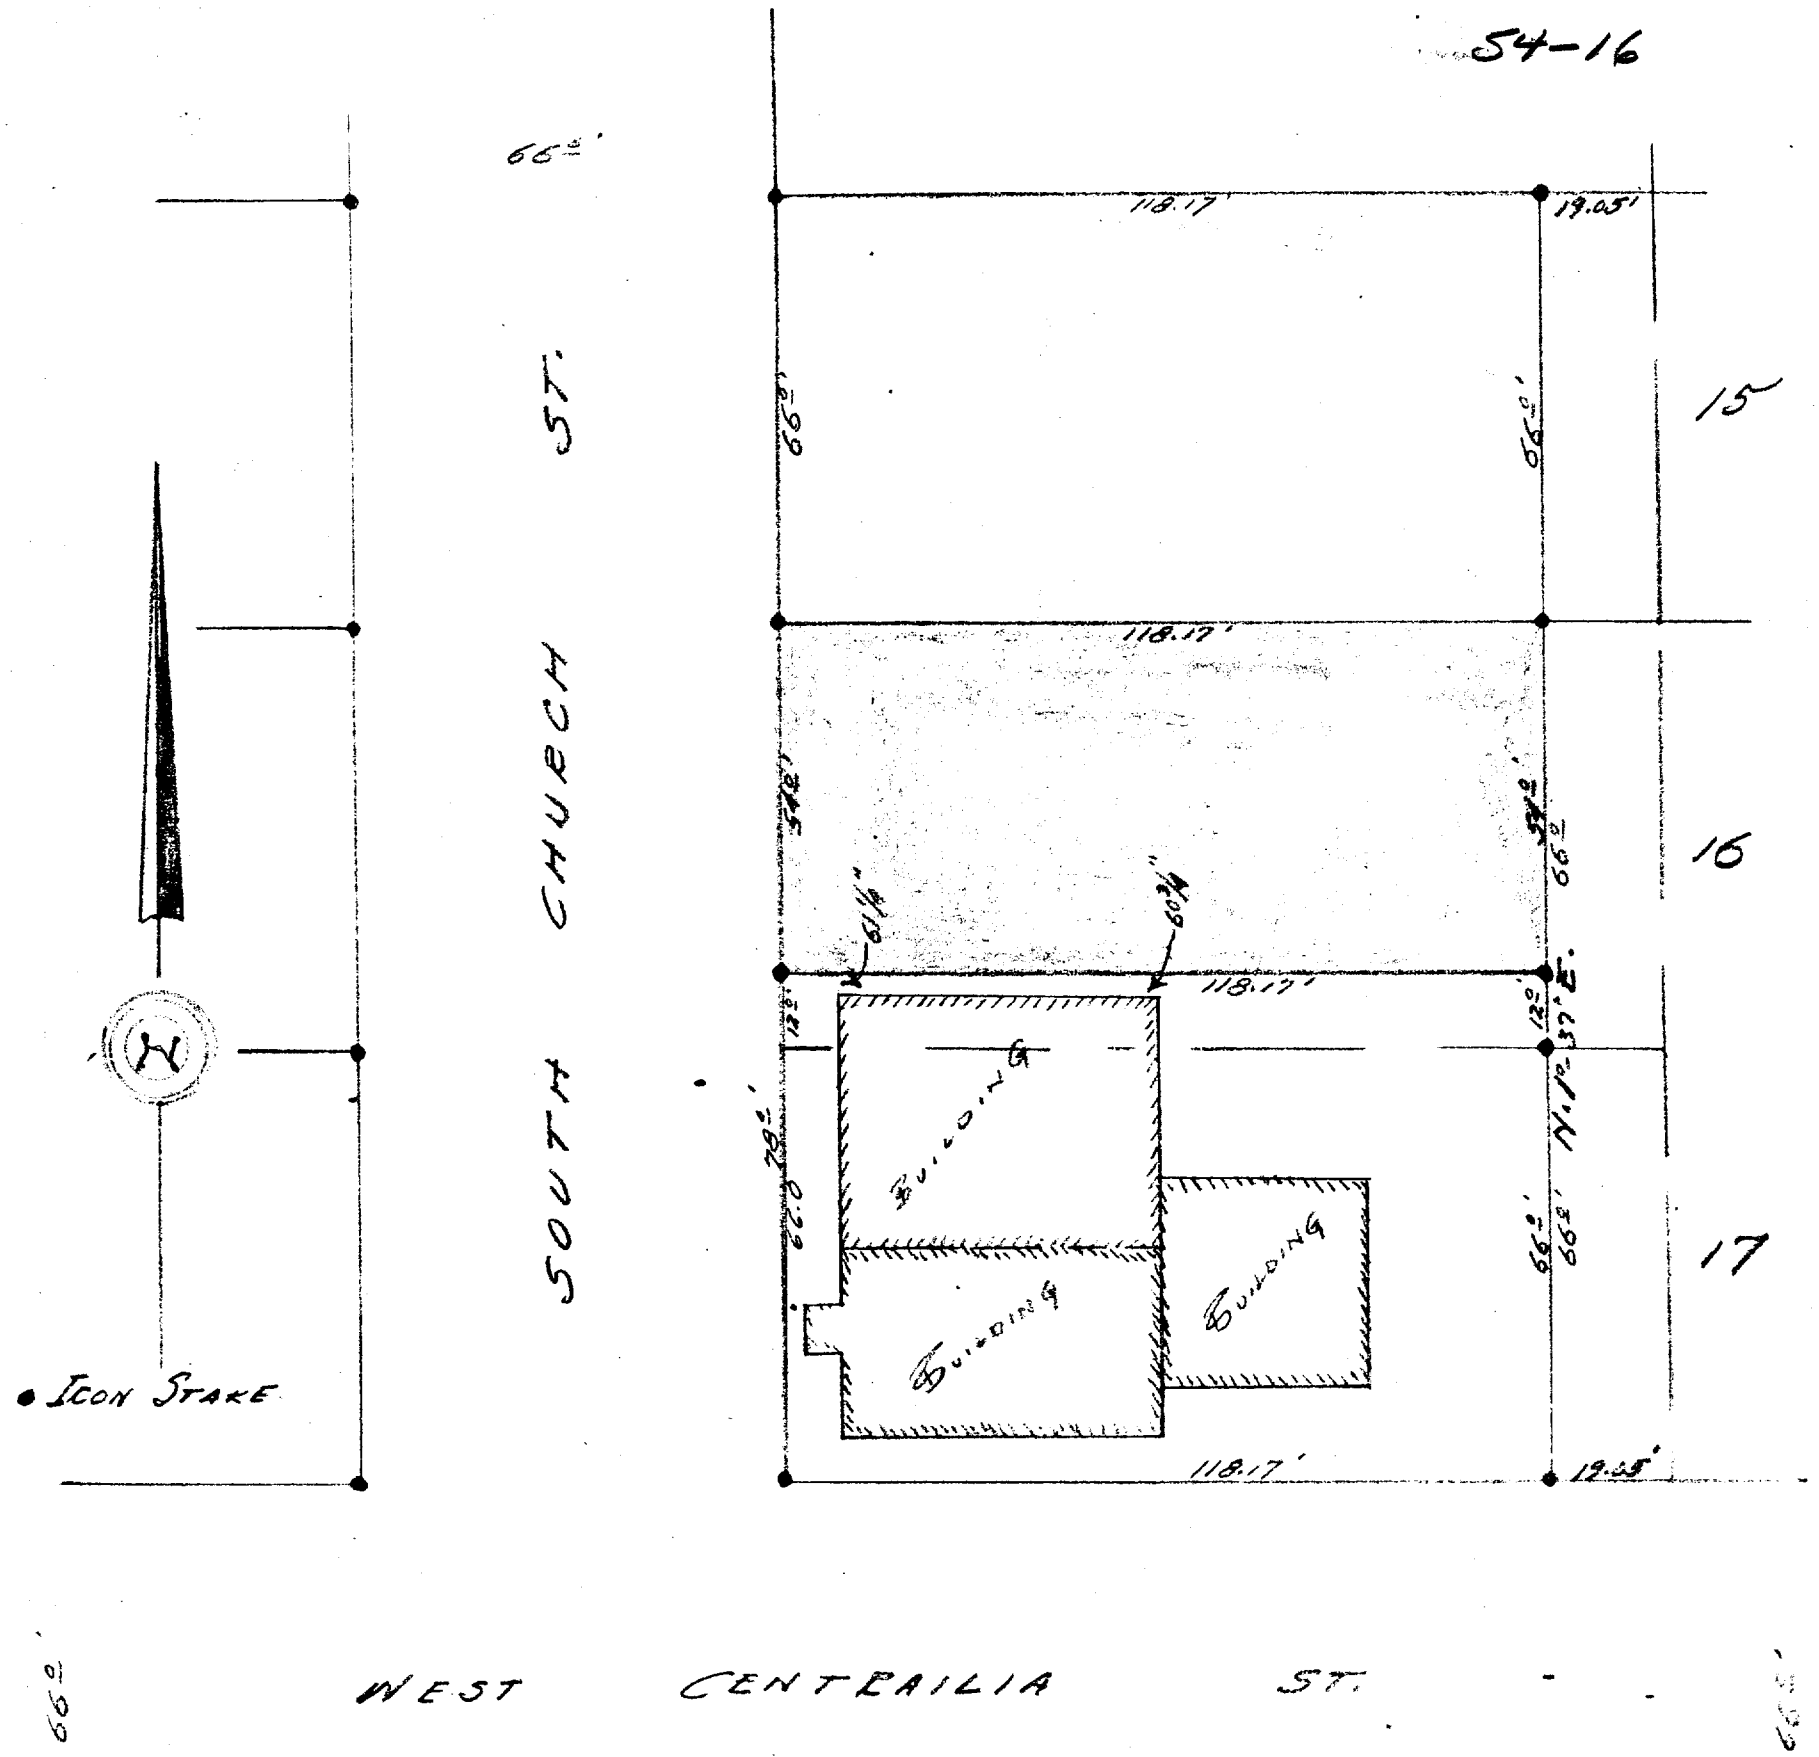

DESCRIPTION: Commencing at an iron stake in the east line of South Church Street, of the City of Elkhorn, Walworth County, Wisconsin; that is 78.0 feet north of the north line of West Centrailia Street of said city, thence East parallel with the north line of West Centrailia Street, 118.17 feet to an iron stake, thence North parallel with the east line of South Church Street 54.0 feet to an iron stake, thence West parallel with the north line of West Centrailia Street 118.17 feet to an iron stake in the east line of South Church Street, thence South in the east line of South Church Street 54.0 feet to the place of beginning.

CERTIFICATE: I, hereby certify that I have on this the 2nd day of January 1954, surveyed the above described property according to the official records on file in the office of the Recorder of Deeds in and for Walworth County, Wisconsin, and find that the measurements and bearings of the boundary lines of said property as taken at the site on this day substantially agree with those in said official record and that no encroachments exist and that the relative position and location of all buildings on the adjacent property, as of this date are exactly as shown above.

SIGNED AND SEALED ON THIS THE 4TH DAY OF JANUARY 1954.

Joseph M. Biagi. Professional Engineer
Elkhorn Wisconsin.

U-SW-484

4-219B