
59-24

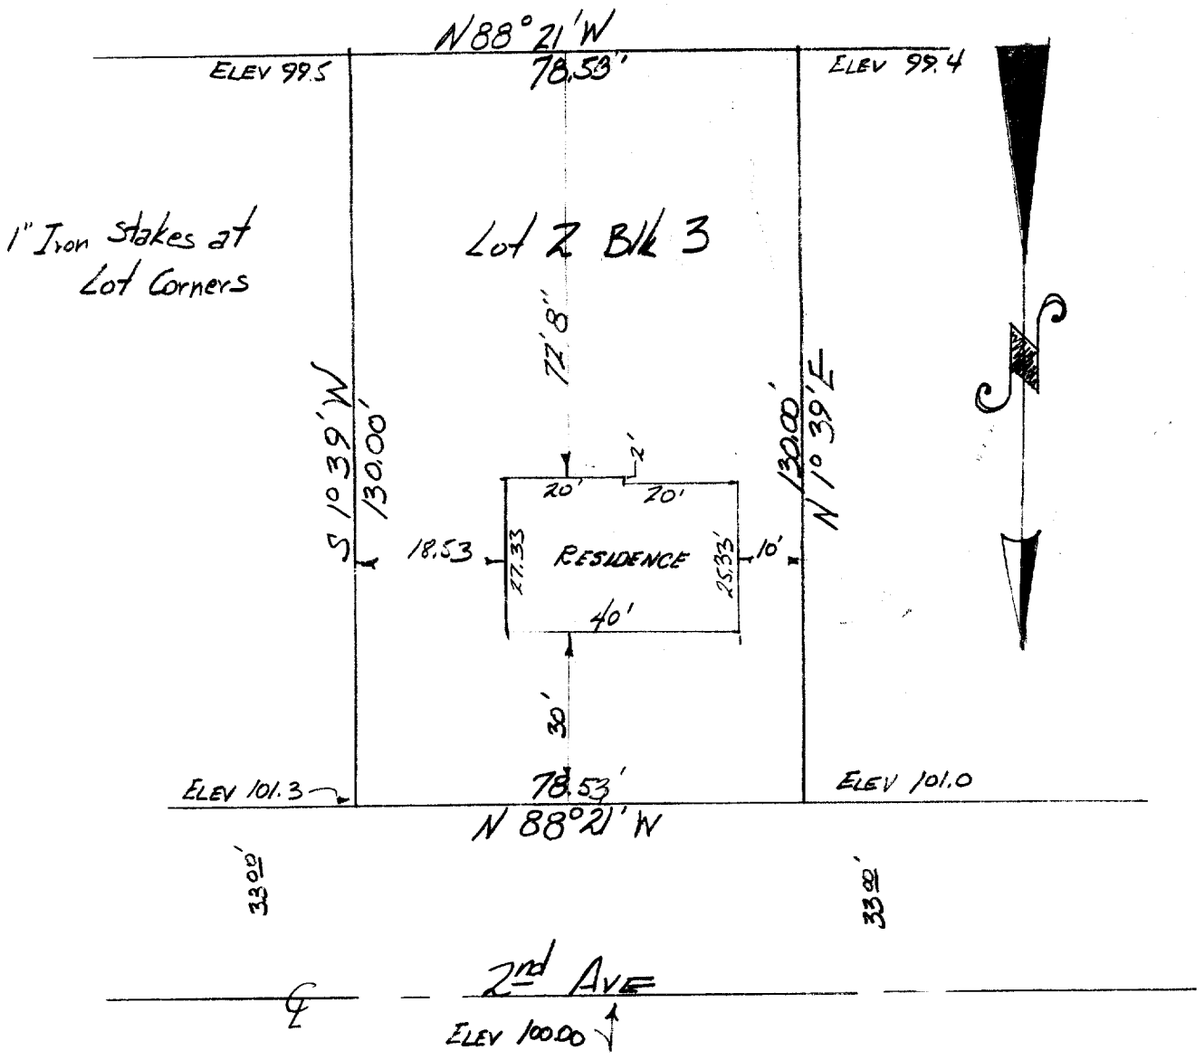


DESCRIPTION: Lot 2 Block 3 of Edgewood Subdivision, in the City of Elkhorn, Wisconsin.

CERTIFICATE: I James F. Biagi, Surveyor, do hereby certify that I have surveyed the property hereon described and that the locations of the improvements are as shown on the drawing above.

SIGNED AND SEALED THIS 2ND DAY OF JUNE 1959.

WISCONSIN JAMES F. BIAGI MILWAUKEE WIS. LAND SURVEYOR

James F Biagi
SURVEYOR

Re-certified that as of this day July, 22nd 1959., buildings are located on the above described property as indicated hereon.

James F. Biagi, Surveyor.

YE-8

4-21B