
54-15

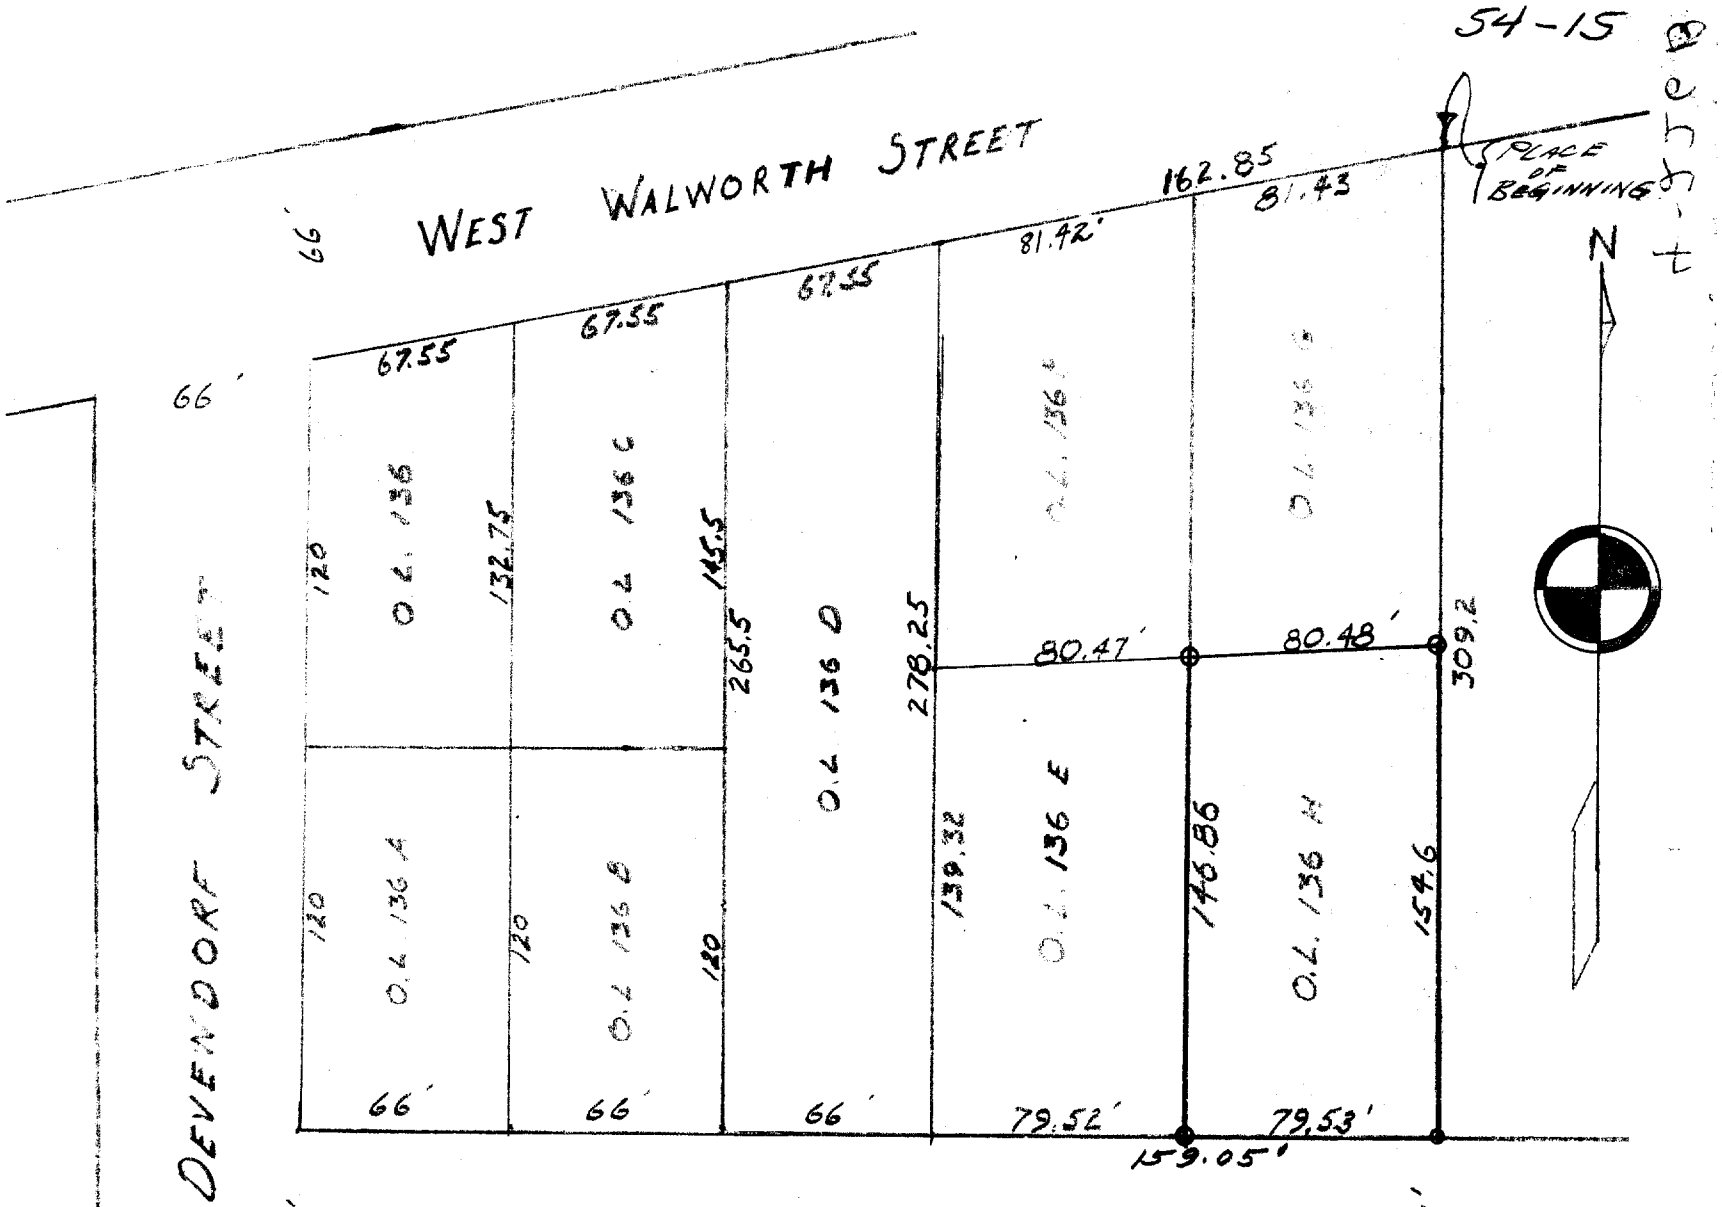

SCRIPTION: The east one half ½ of the south one half ½ of the following described property, commencing at a point in the southerly line of Plank Road (now known as West Walworth Street of the City of Elkhorn Walworth County, Wisconsin) at the northeast corner of Lot 3, Block 7, of the former Devendorf, Mallory, and Spencer Addition to the City of Elkhorn, Walworth County, Wisconsin, thence southwesterly along the southerly line of said Walworth Street, 162.85 feet to a point, thence South parallel with the east line of Devendorf Street of said city, 278.25 feet to an iron stake in the north line of West Geneva Street of said city, thence East along the north line of said West Geneva Street, 159.05 feet to an iron stak e thence North parallel with the east line of Devendorf Street, 309.2 feet to the place of beginning.

CERTIFICATE:

I, Joseph M. Biagi, hereby certify that I have on this the 2nd day of June 1954. surveyed the above described property according to the official records on file in the office of the Recorder of Deeds in and for Walworth County, Wisconsin, and find that the measurements and bearings of the boundary lines of saidproperty as taken at the site on this day, substantially agree with those in said official record and that no encroachments exist.

SIGNED AND SEALED ON THIS THE 10TH DAY OF JUNE 1954.

Joseph M. Biagi

Joseph M. Biagi. Professional Engineer.
Elkhorn Wisconsin.

Yunw-223

~~YW-224~~ thru 229

(Lot in SW¼ 36-3-16)

4-226 B