
Plat of Survey

of

Lot 9 of Ted's Addition to the City of Elkhorn,

a subdivision located in the Southeast 1/4 of Section 36, Town 3 North, Range 16 East, City of Elkhorn, Walworth County, Wisconsin.


Surveyed for: **Jeanette Jacobs**
205 Van Buren Street
Elkhorn, Wisconsin. 53121

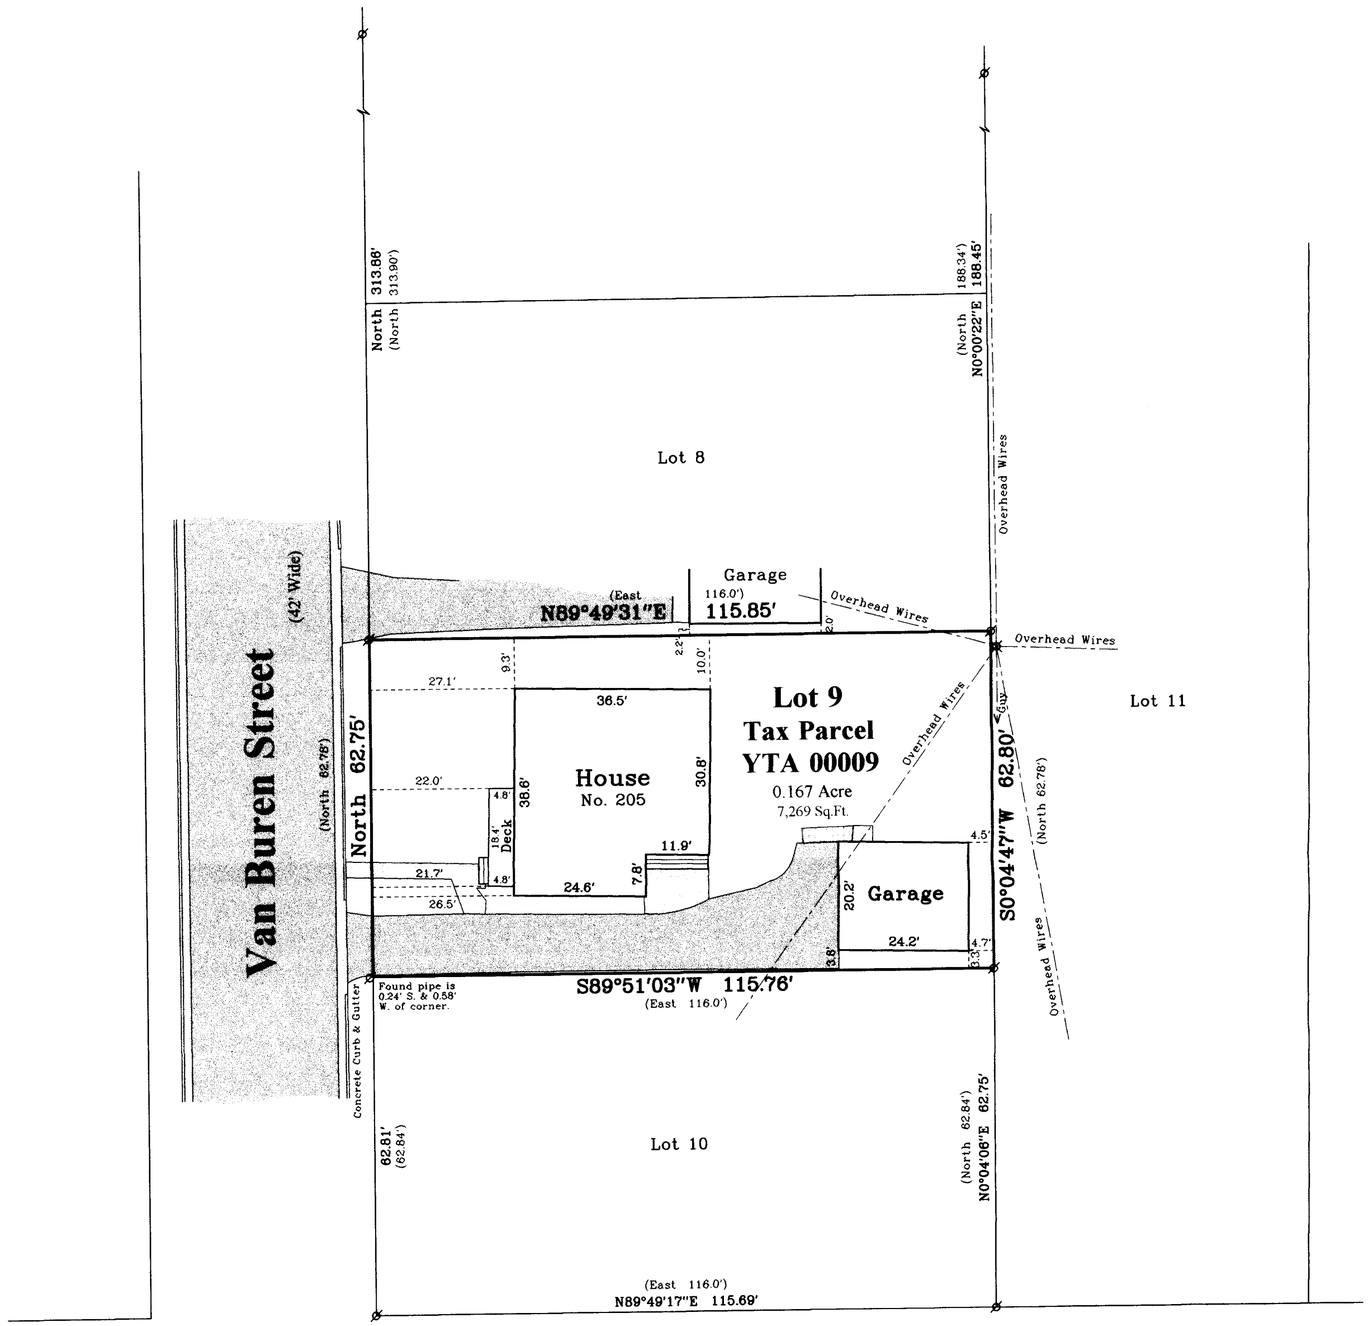

West Jefferson Street

(66' Wide)

Bearings referenced to the East line of Van Buren Street recorded as North on the plat of Ted's Addition to the City of Elkhorn.

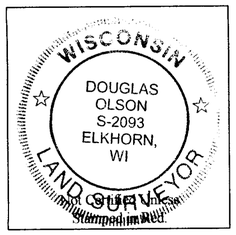

Notes:

1) This survey plat is not certified unless signed and sealed in red ink.
2) This survey is subject to Wisconsin lien laws. This Plat of Survey is the notice of intent to file lien. Lien waiver required.

RECEIVED
OCT 11 2010
By

Copyright 2010 by Jensen & Olson Land Surveying, LLC.

All rights reserved. No part of this survey plat may be reproduced or transmitted in any form by any means - graphic, electronic, or mechanical, including photocopying, tracing, or information storage and retrieval systems - without permission in writing from Douglas G. Olson, Jensen & Olson Land Surveying, LLC.

I, Douglas G. Olson, Wisconsin Registered Land Surveyor, do hereby certify that this survey was performed by me, or under my direction in full compliance with the owner's/agent's instructions and Chapter A-E 7 of the Wisconsin Administrative Code "Minimum Standards for Property Surveys"; and that this map is an accurate representation thereof to the best of my knowledge and belief.

Douglas G. Olson
Wisconsin Registered Land Surveyor - 2093

004-2299

YTA-9

Survey Date: Sept. 13, 2010.
Revisions:

Scale in Feet
1" = 20'
0' 10' 20' 40'

Jensen & Olson Land Surveying, LLC
45 South Wisconsin Street * P.O. Box 322 * Elkhorn, Wisconsin. 53121
Telephone: (262) 723-3434 * Facsimile: (262) 723-8044
Email: jensen.olson@elknet.net

Legend
- Found Iron Pipe
- () Recorded Information
- Utility Pole
- Asphalt Surface
- Concrete Surface
- Patio Blocks

Sheet 1 of 1 Sheets
Drawing Name: I:\srf\oc-2010088-20100887Plat.srcj
Job Reference Number
2010.088

2010.088