
PLAT OF SURVEY
–OF–

LOT 98, IN THE PINES, ACCORDING TO THE RECORDED PLAT THEREOF. SAID LAND BEING IN THE CITY OF ELKHORN, COUNTY OF WALWORTH, STATE OF WISCONSIN.

SURVEY FOR: SHOREWEST REALTORS

SURVEY ADDRESS: 1020 E. PINECREST LANE

RECEIVED
AUG 18 2011
By

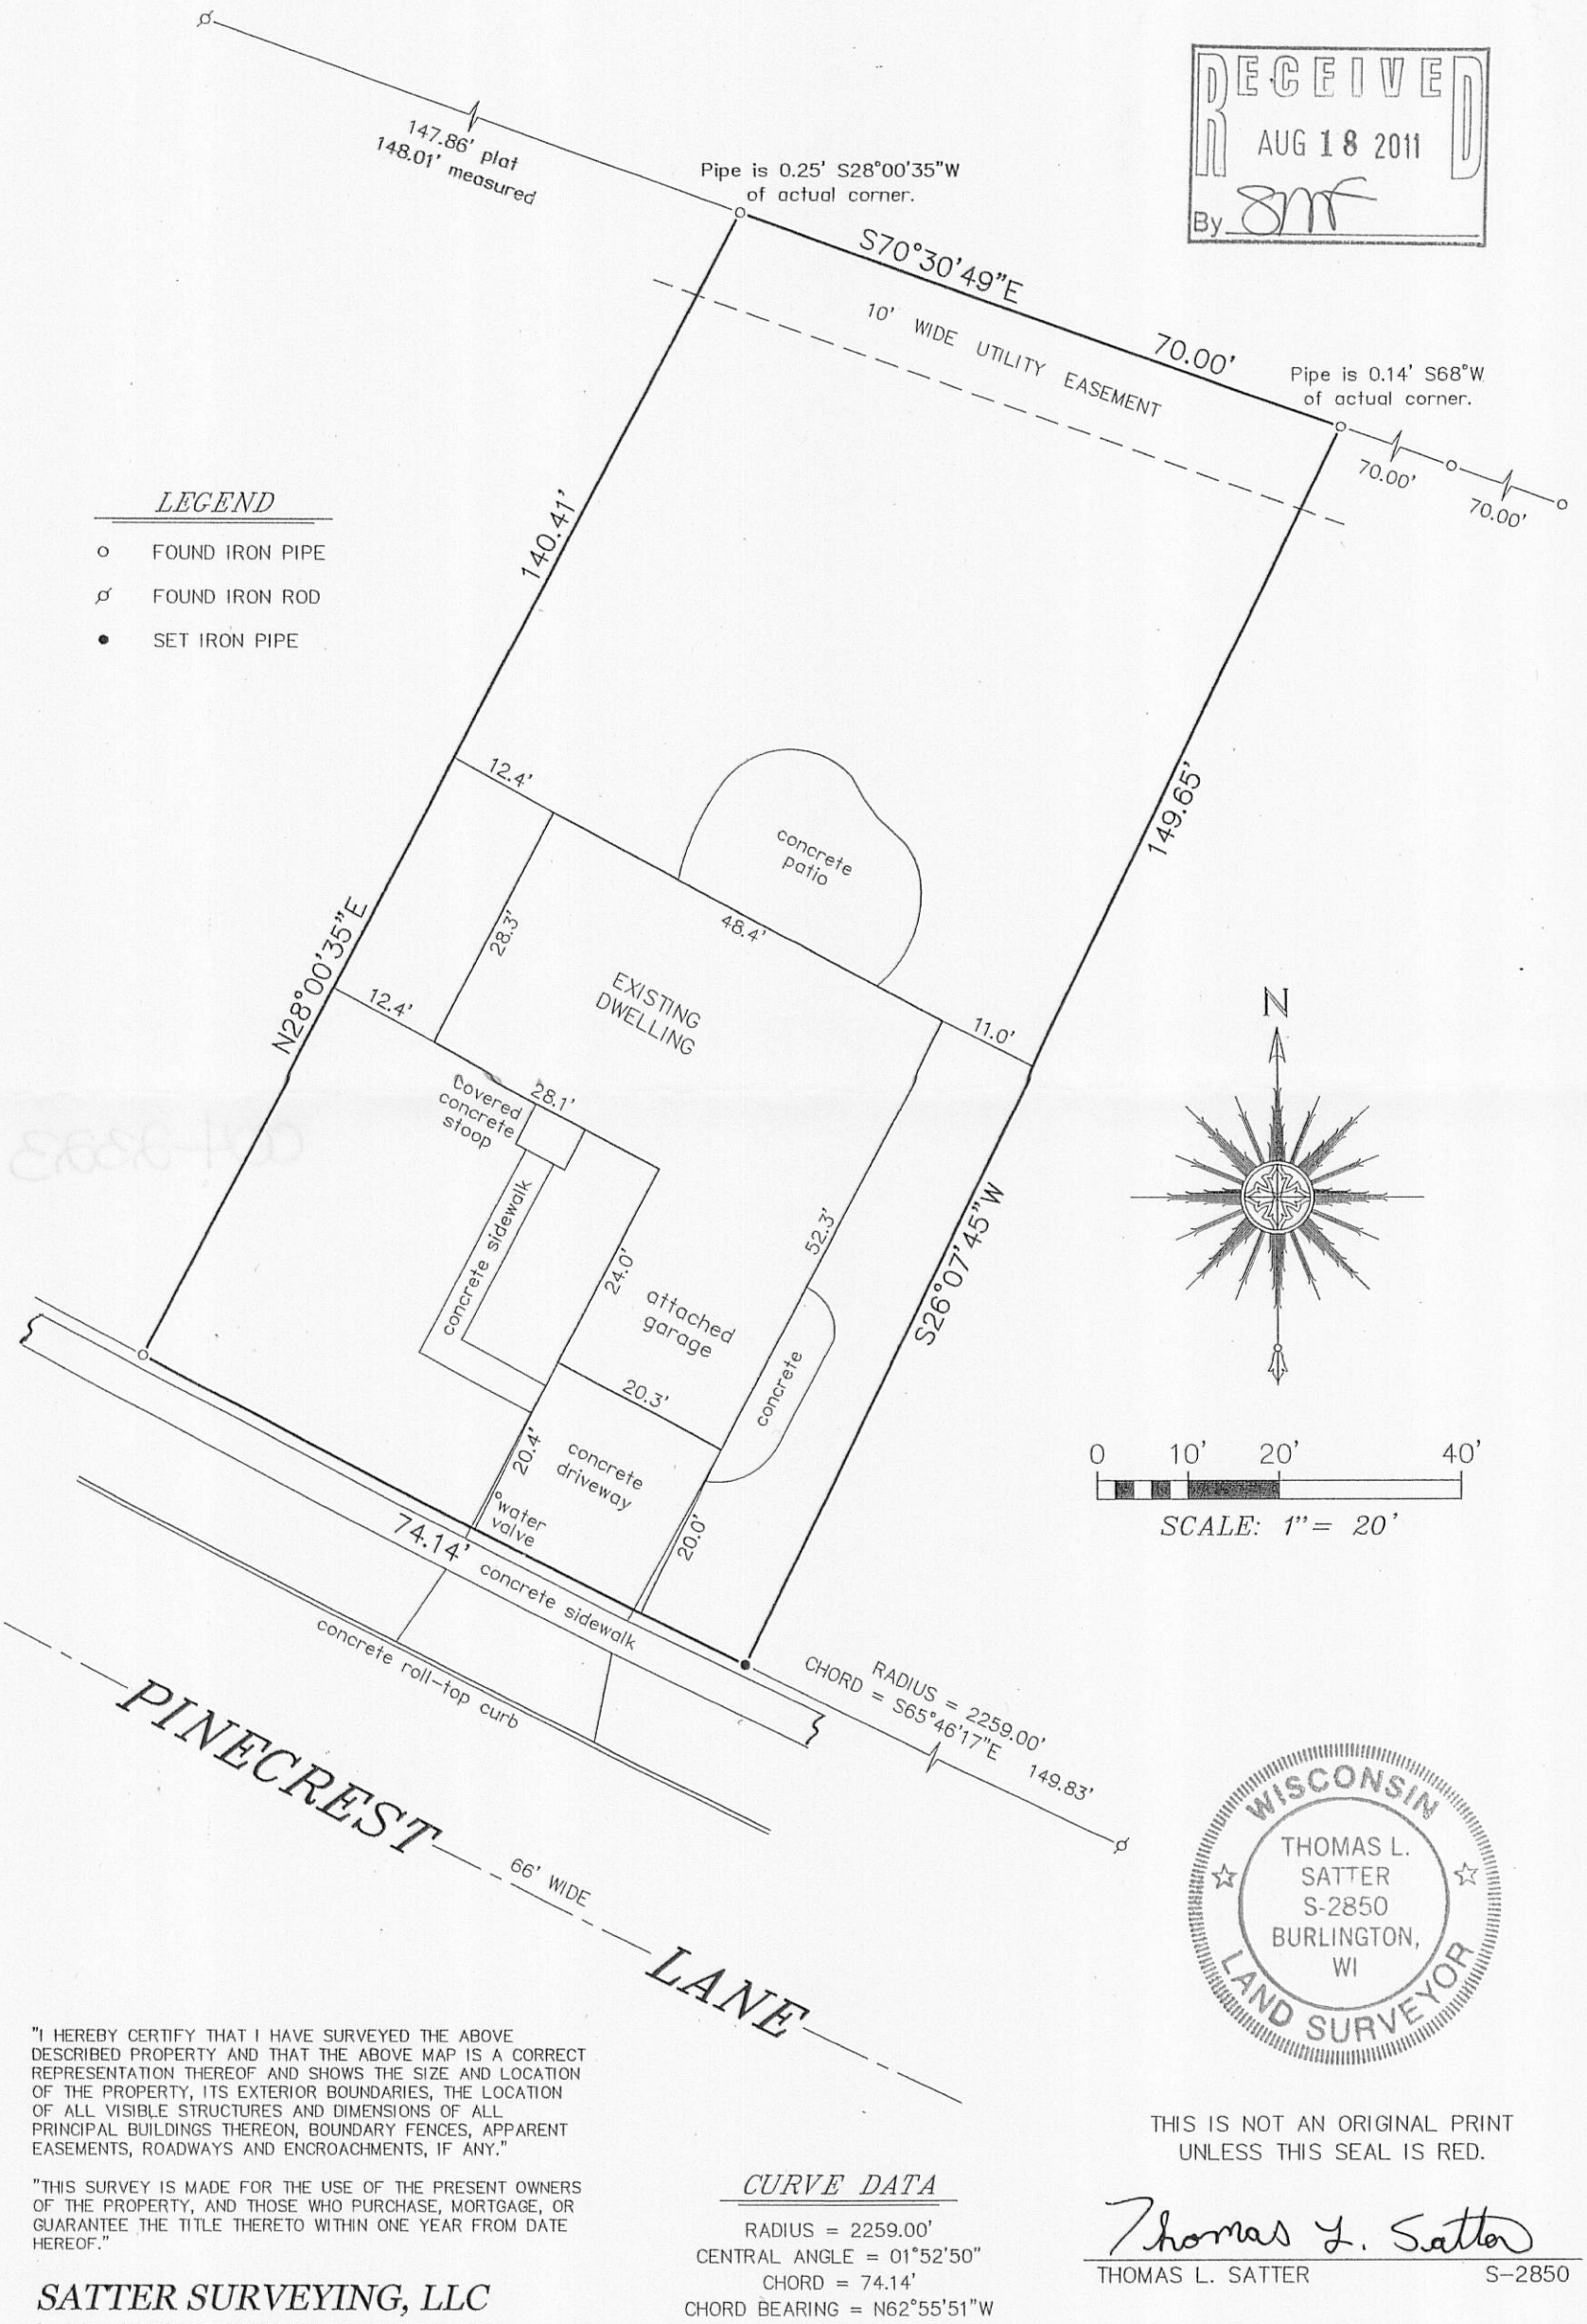

LEGEND

- o FOUND IRON PIPE
- ø FOUND IRON ROD
- • SET IRON PIPE

WISCONSIN
THOMAS L. SATTER
S-2850
BURLINGTON, WI
LAND SURVEYOR

"I HEREBY CERTIFY THAT I HAVE SURVEYED THE ABOVE DESCRIBED PROPERTY AND THAT THE ABOVE MAP IS A CORRECT REPRESENTATION THEREOF AND SHOWS THE SIZE AND LOCATION OF THE PROPERTY, ITS EXTERIOR BOUNDARIES, THE LOCATION OF ALL VISIBLE STRUCTURES AND DIMENSIONS OF ALL PRINCIPAL BUILDINGS THEREON, BOUNDARY FENCES, APPARENT EASEMENTS, ROADWAYS AND ENCROACHMENTS, IF ANY."

"THIS SURVEY IS MADE FOR THE USE OF THE PRESENT OWNERS OF THE PROPERTY, AND THOSE WHO PURCHASE, MORTGAGE, OR GUARANTEE THE TITLE THERETO WITHIN ONE YEAR FROM DATE HEREOF."

CURVE DATA

RADIUS = 2259.00'
CENTRAL ANGLE = 01°52'50"
CHORD = 74.14'
CHORD BEARING = N62°55'51"W

THIS IS NOT AN ORIGINAL PRINT UNLESS THIS SEAL IS RED.

Thomas L. Satter
THOMAS L. SATTER S–2850

SATTER SURVEYING, LLC
LAND SURVEYS, MAPPING AND PLANNING
272 ORIGEN STREET
BURLINGTON, WI 53105
262–661–4239

AUGUST 12, 2011 — DATE

071103 — JOB NUMBER

YP1 -98

004-2323