
#117-68

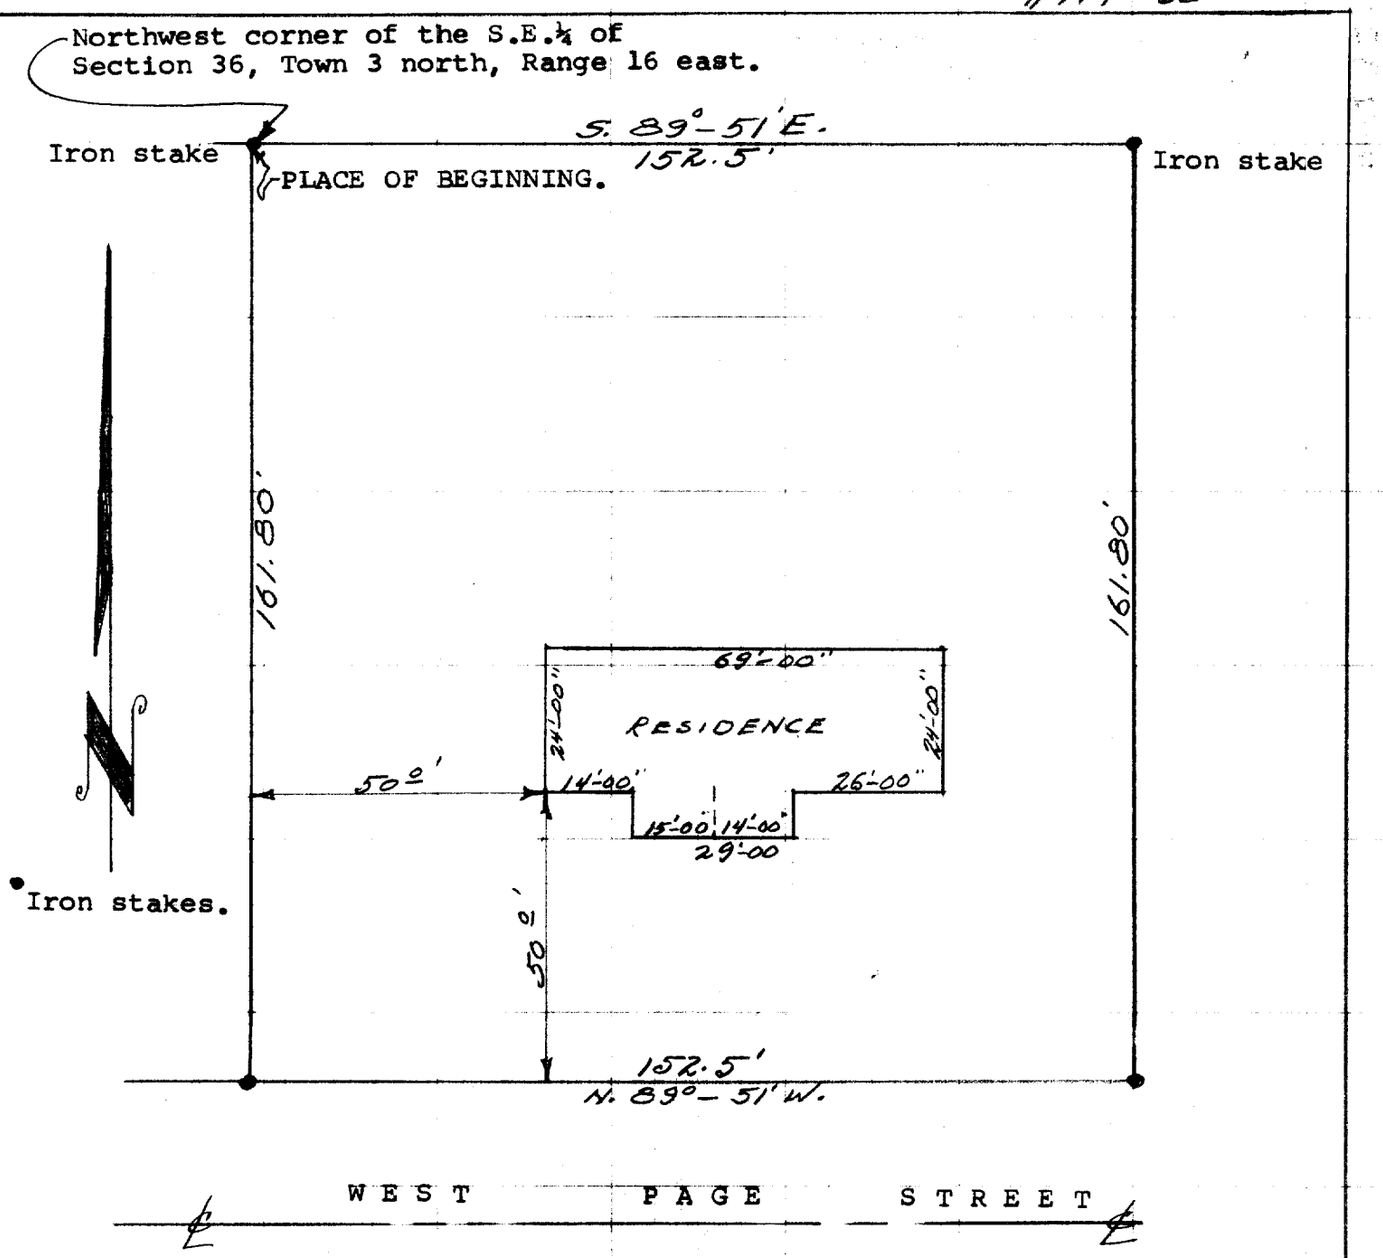


Description:

Commencing at the northwest corner of the S.E. ¼ of Section 36, Town 3 north, Range 16 east, City of Elkhorn, Walworth County, Wisconsin, thence S. 89° 51' E., 152.50 feet to an iron stake, thence South 161.80 feet to an iron stake in the north line of West Page Street, thence N. 89° 51' W. along said north line 152.50 feet to an iron stake, thence North 161.8 feet to the place of beginning.

CERTIFICATE:

I, James F. Biagi, surveyor, do hereby certify that I have surveyed the property hereon described on this the 9th day of September 1968.

James F. Biagi

James F. Biagi RLS 272
Elkhorn, Wisconsin.

Dated this 9th day of September 1968.

U-NW-71 (RVD)

4-232B