LAND-MARK SURVEYING
Mark L. Miritz
Wisconsin Registered Land Surveyor S-2582


N9330 Knuteson Drive
Whitewater, WI 53190
Phone:(262)495-3284
FAX : (262) 495-8421
LAND-MARKSURVEYING.COM

PLAT OF SURVEY

LOT 5, BLOCK 3 OF STANFORD'S ADDITION TO THE VILLAGE, NOW CITY OF ELKHORN, WALWORTH COUNTY, WISCONSIN

ORDERED BY: CONNIE POGGENSEE
RAULAND AGENCY
118 KENOSHA ST.
WALWORTH, WI 53184

RECEIVED
DEC - 6 2011
By

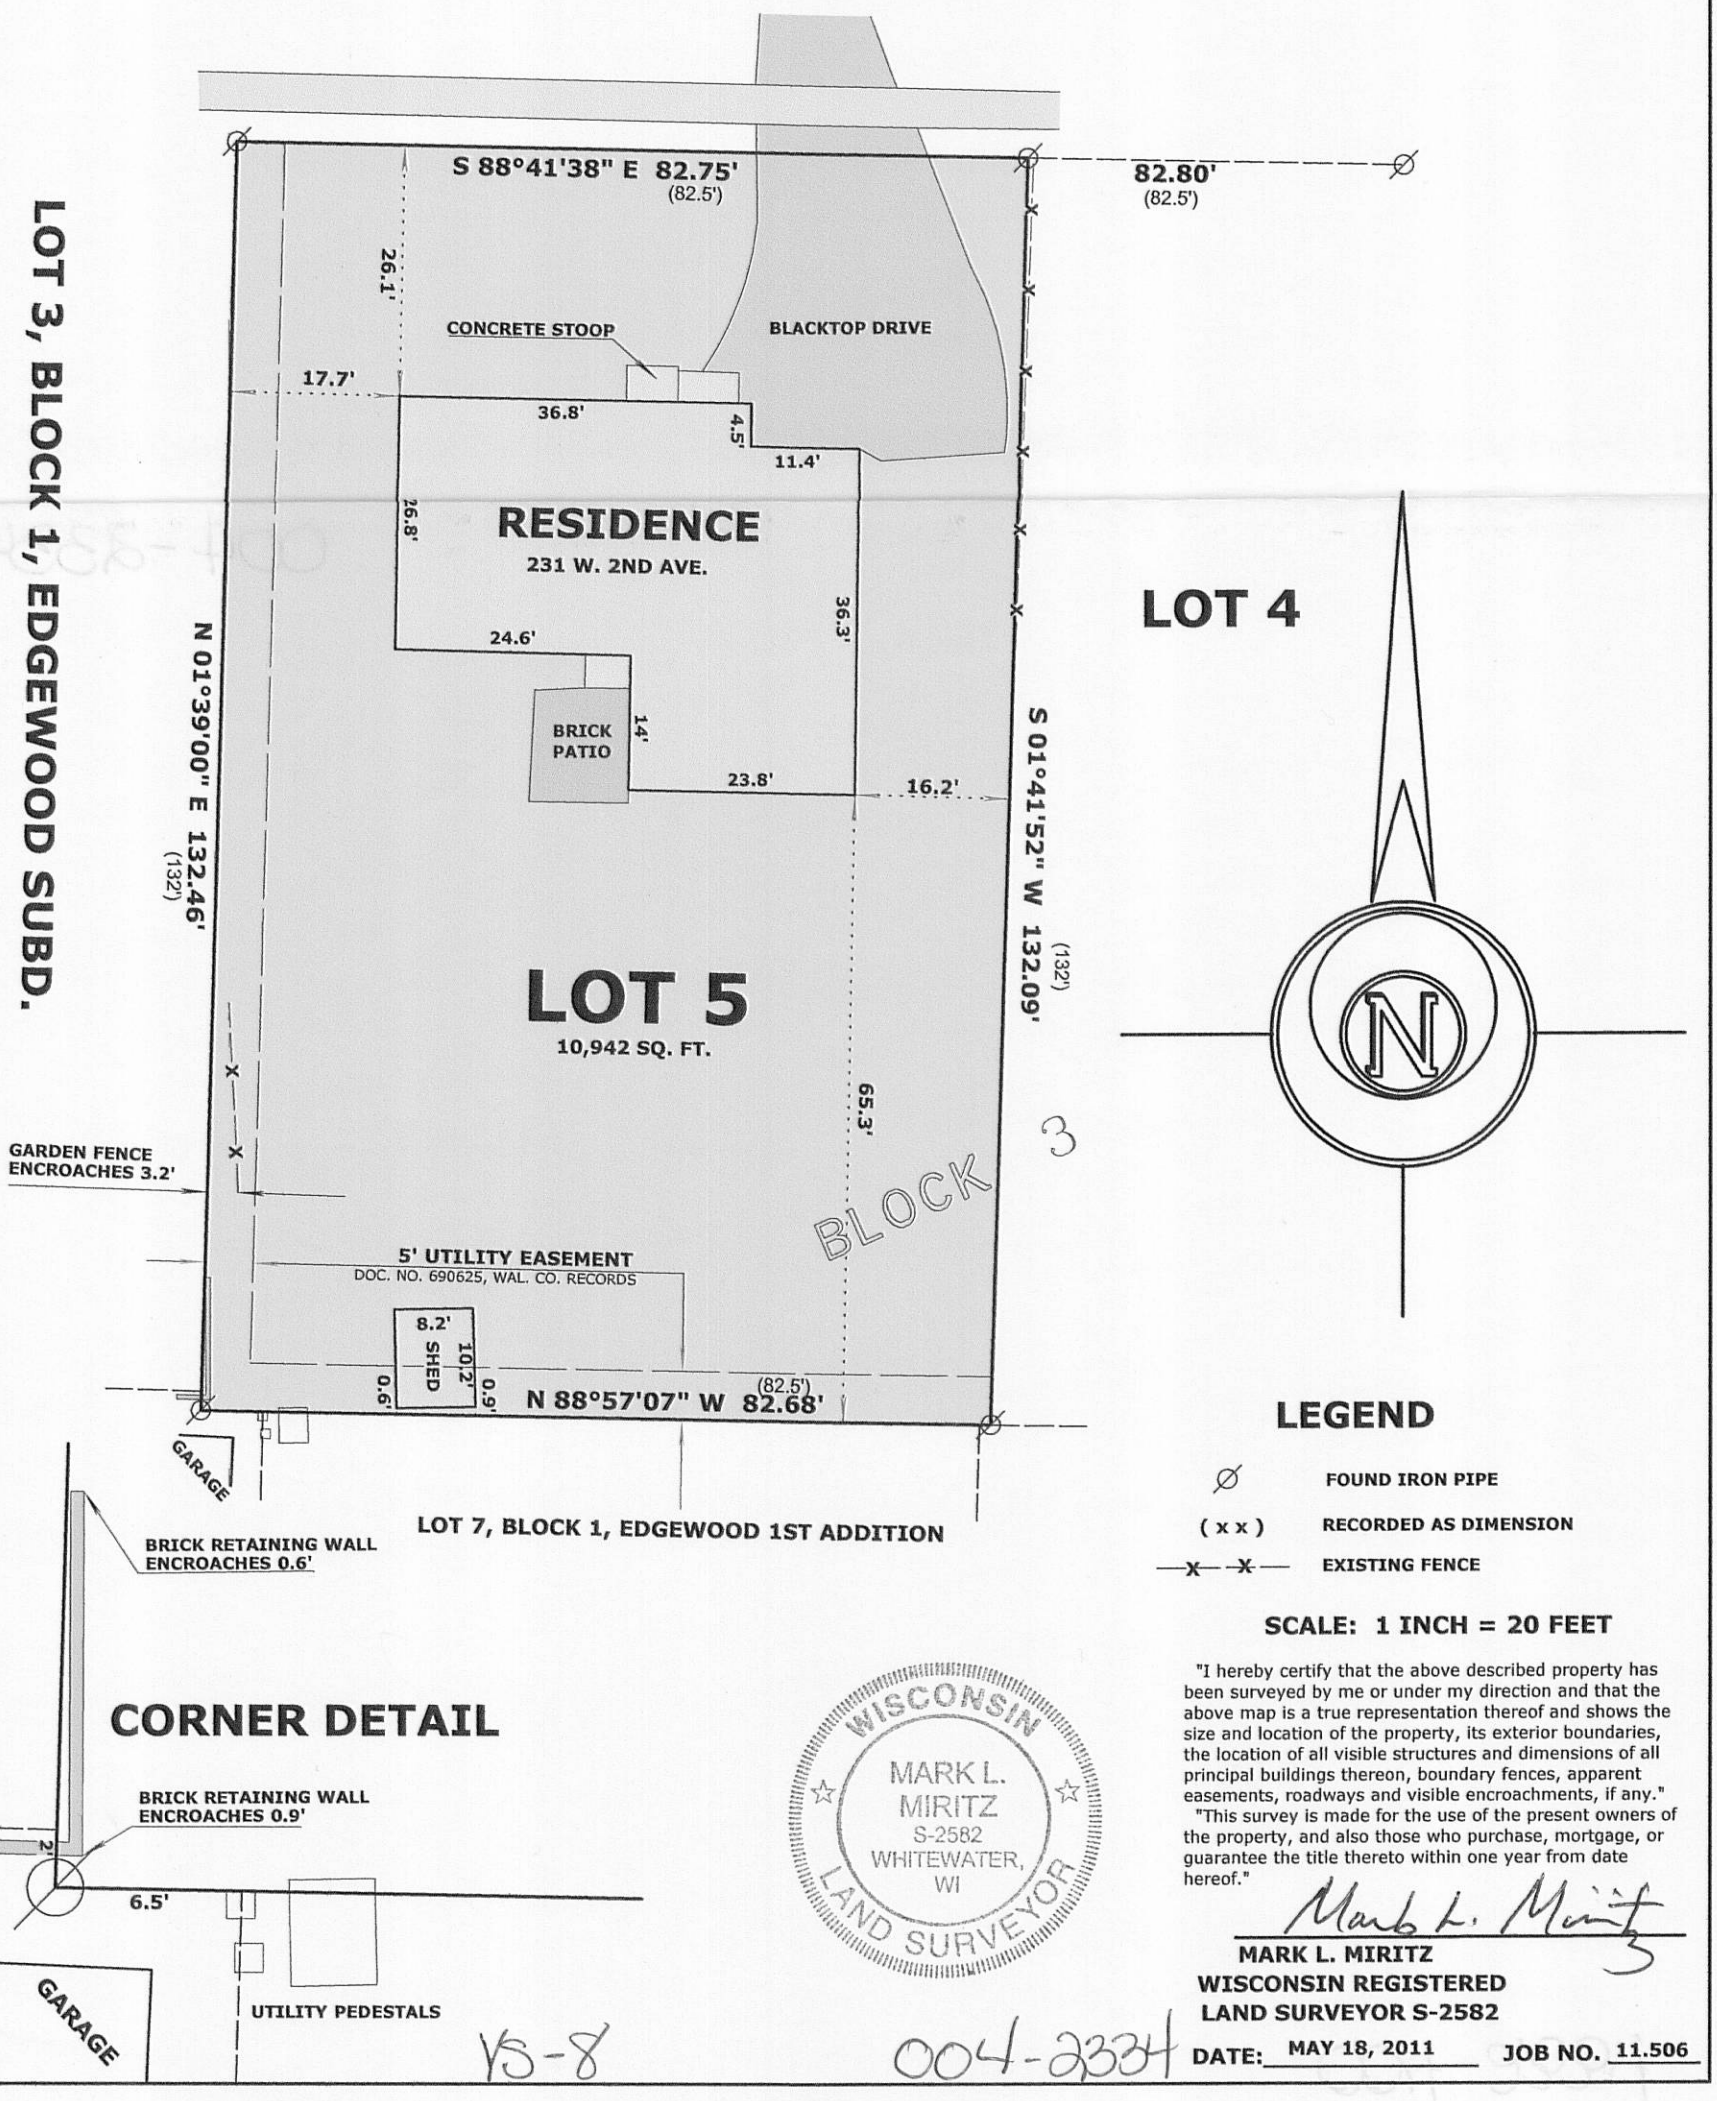

LEGEND

∅	FOUND IRON PIPE
(x x)	RECORDED AS DIMENSION
—x—x—	EXISTING FENCE

SCALE: 1 INCH = 20 FEET

"I hereby certify that the above described property has been surveyed by me or under my direction and that the above map is a true representation thereof and shows the size and location of the property, its exterior boundaries, the location of all visible structures and dimensions of all principal buildings thereon, boundary fences, apparent easements, roadways and visible encroachments, if any."

"This survey is made for the use of the present owners of the property, and also those who purchase, mortgage, or guarantee the title thereto within one year from date hereof."

Mark L. Miritz

MARK L. MIRITZ
WISCONSIN REGISTERED
LAND SURVEYOR S-2582

DATE: MAY 18, 2011 **JOB NO.** 11.506

VS-8

004-2334