
# FARRIS, HANSEN & ASSOCIATES, INC.


ENGINEERING – ARCHITECTURE – SURVEYING
7 RIDGWAY COURT – P.O. BOX 437 – ELKHORN, WISCONSIN 53121
PHONE: (262) 723–2098 FAX: (262) 723–5886

## PLAT OF SURVEY

LOT 40 OF JACKSON CREEK EAST SUBDIVISION
LOCATED IN THE SW & SE 1/4'S OF THE SW 1/4 SEC. 7
TOWN 2 NORTH, RANGE 17 EAST
CITY OF ELKHORN, WALWORTH COUNTY, WI.

– WORK ORDERED BY –
ROBERT SPUHLER
403 GRANT STREET
ELKHORN, WI. 53121

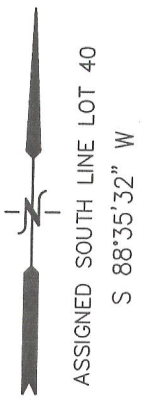

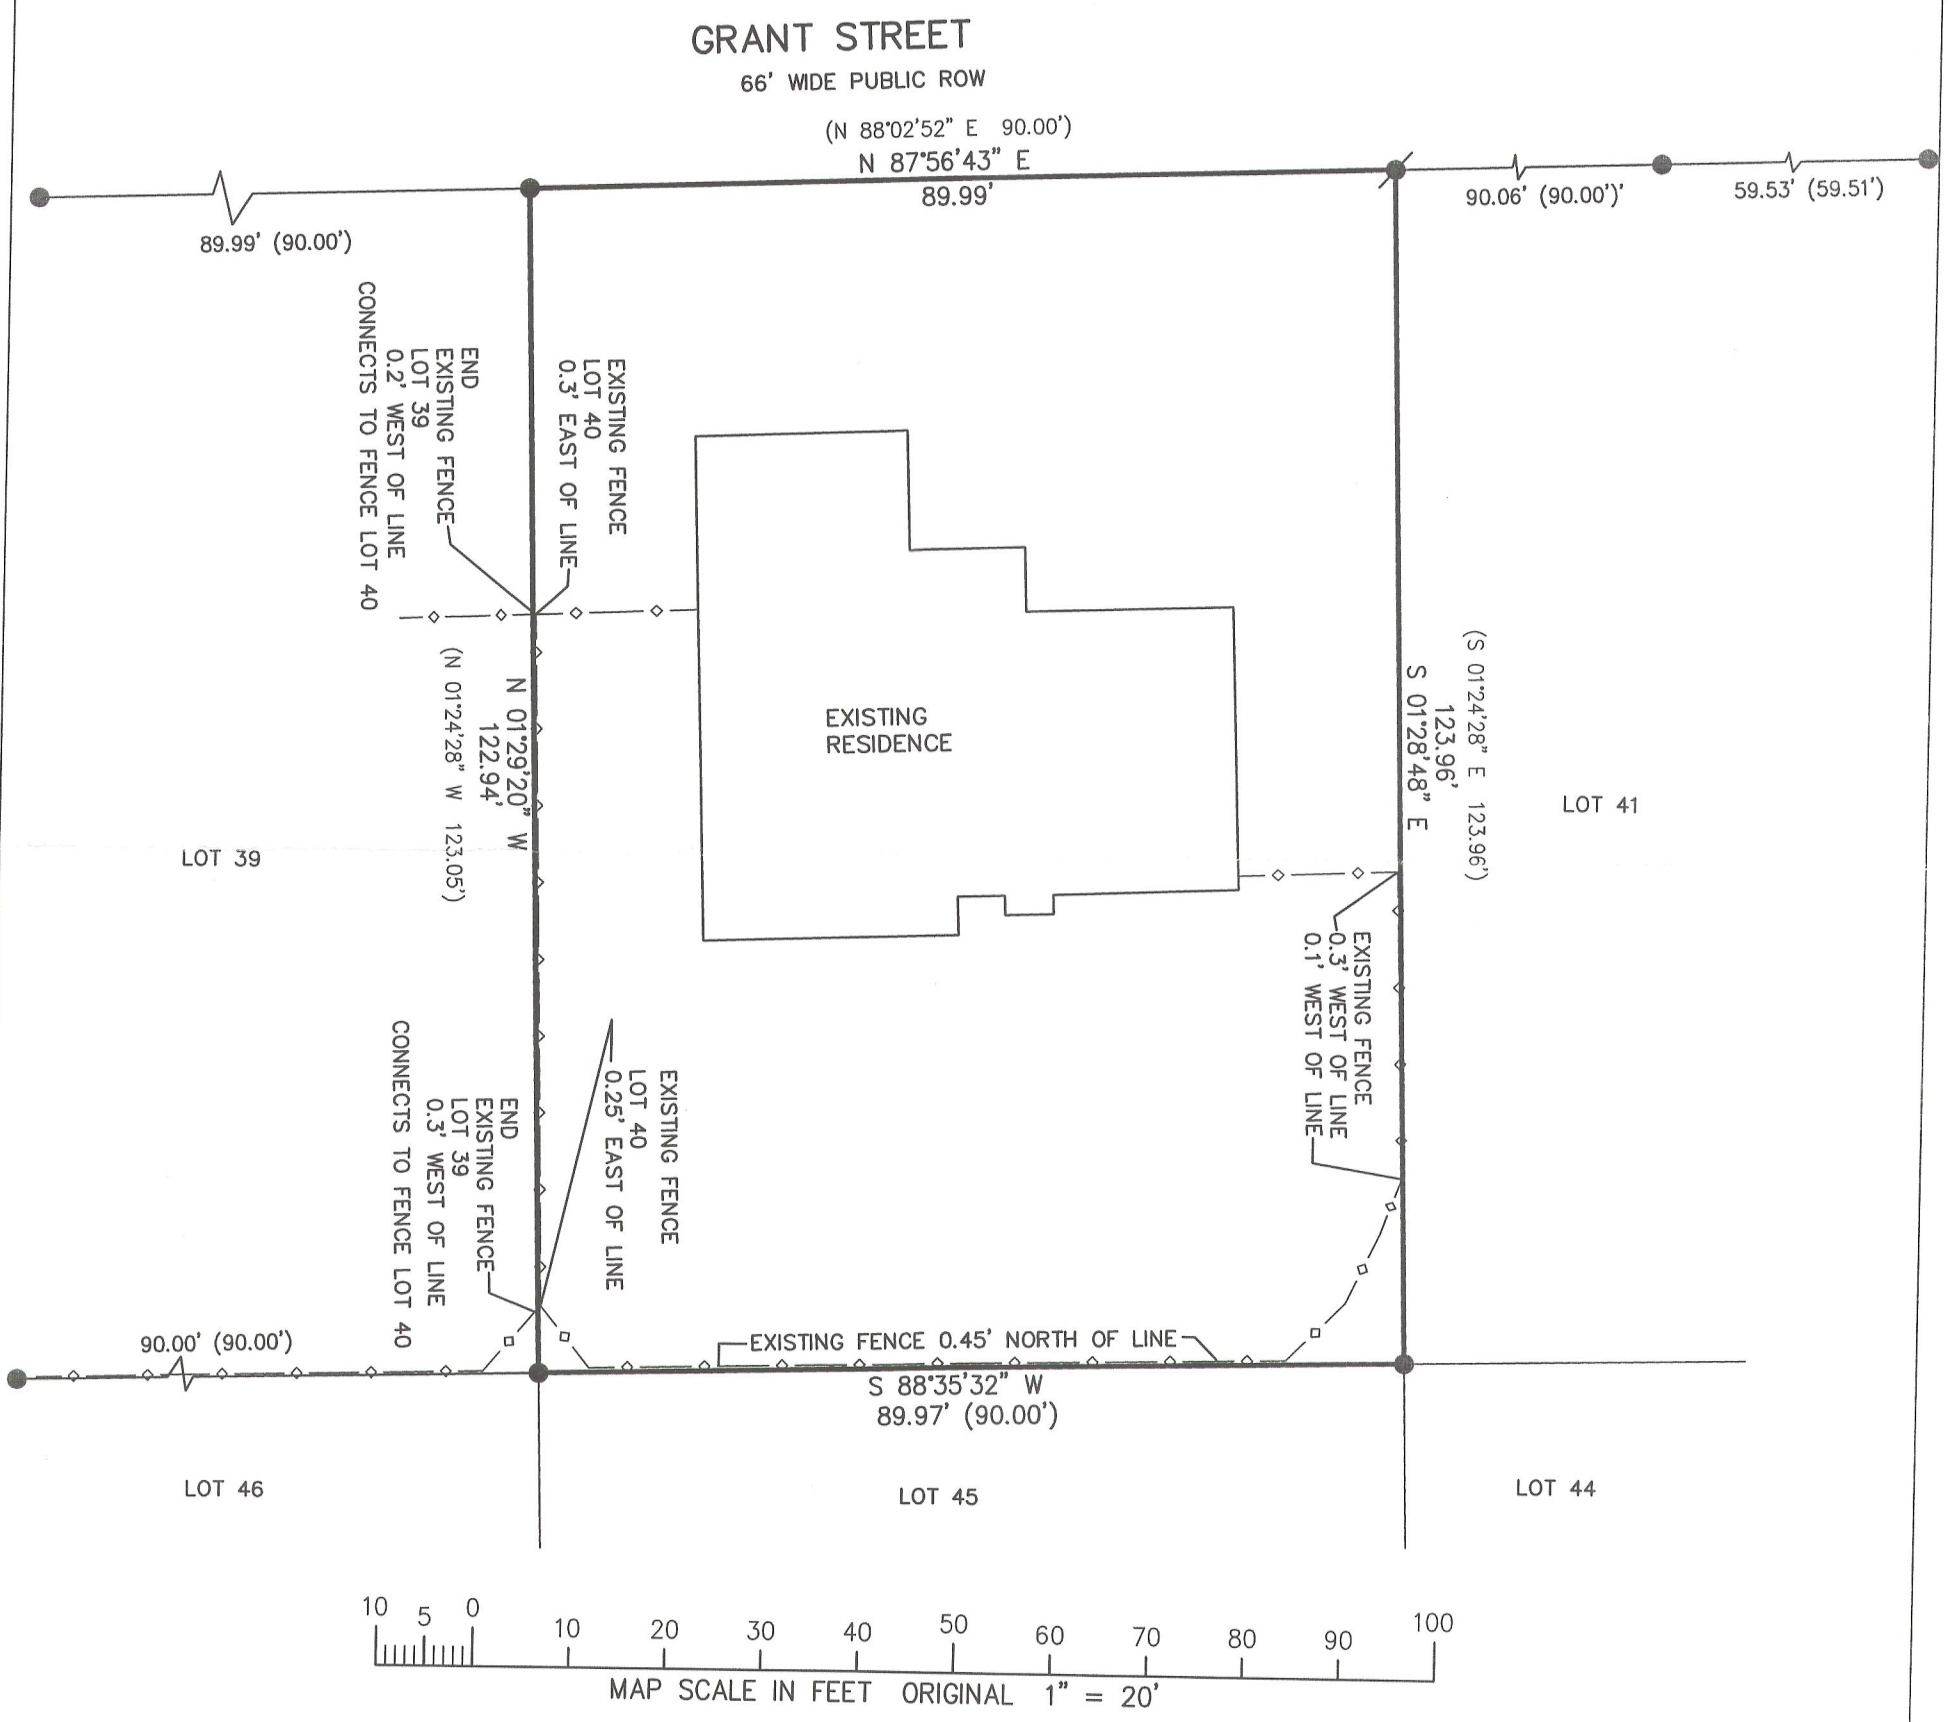
NOTE: COPIES OF THIS MAP TO WHICH THE FOLLOWING CERTIFICATE WILL APPLY SHOW THE SURVEYOR'S ORIGINAL SEAL AND SIGNATURE IN RED INK. COPIES BY ANY OTHER MEANS MAY HAVE ALTERATIONS WHICH DO NOT REPRESENT THE SURVEYOR'S WORK PRODUCT.

I HEREBY CERTIFY THAT THE ABOVE DESCRIBED PROPERTY HAS BEEN SURVEYED UNDER MY DIRECTION AND THAT THE ABOVE MAP IS A TRUE REPRESENTATION THEREOF AND SHOWS THE SIZE AND LOCATION OF THE PROPERTY AND ITS EXTERIOR BOUNDARIES. THIS SURVEY IS MADE FOR THE USE OF THE PRESENT OWNERS OF THE PROPERTY, AND ALSO THOSE WHO PURCHASE, MORTGAGE, OR GUARANTEE THE TITLE THERETO WITHIN ONE YEAR FROM THE DATE HEREOF.

DATED: MAY 3, 2012

Peter S. Gordon

PETER S. GORDON R.L.S. 2101

LEGEND
● = FOUND IRON REBAR STAKE
◢ = FOUND IRON REBAR STAKE
(XXX) = RECORDED AS

WISCONSIN
PETER S. GORDON
S-2101
ELKHORN, WI
LAND SURVEYOR

RECEIVED
MAY 16 2012
By BMF

PROJECT: 4055.40
DATE: 05–03–2012
SHEET 1 OF 1

5/3/2012 X:\Projects\4055\EAST_INDIV_LOTS\LOT40

YJCE-40

CO4-2352