

Plat of Survey

of



Lot 10 of Alder Subdivision,

located in the Northwest 1/4 of Section 1, Town 2 North, Range 16 East, City of Elkhorn, Watworth County, Wisconsin.

Keefe Real Estate, Inc.

1040 North Wisconsin Street
Elkhorn, Wisconsin 53121

Surveyed for:

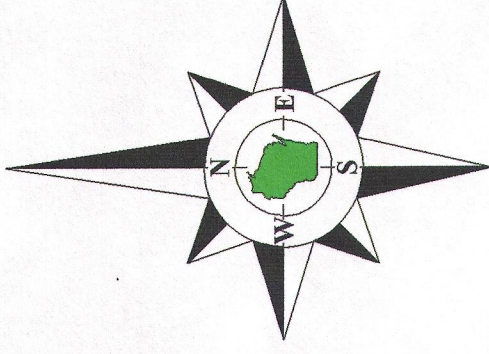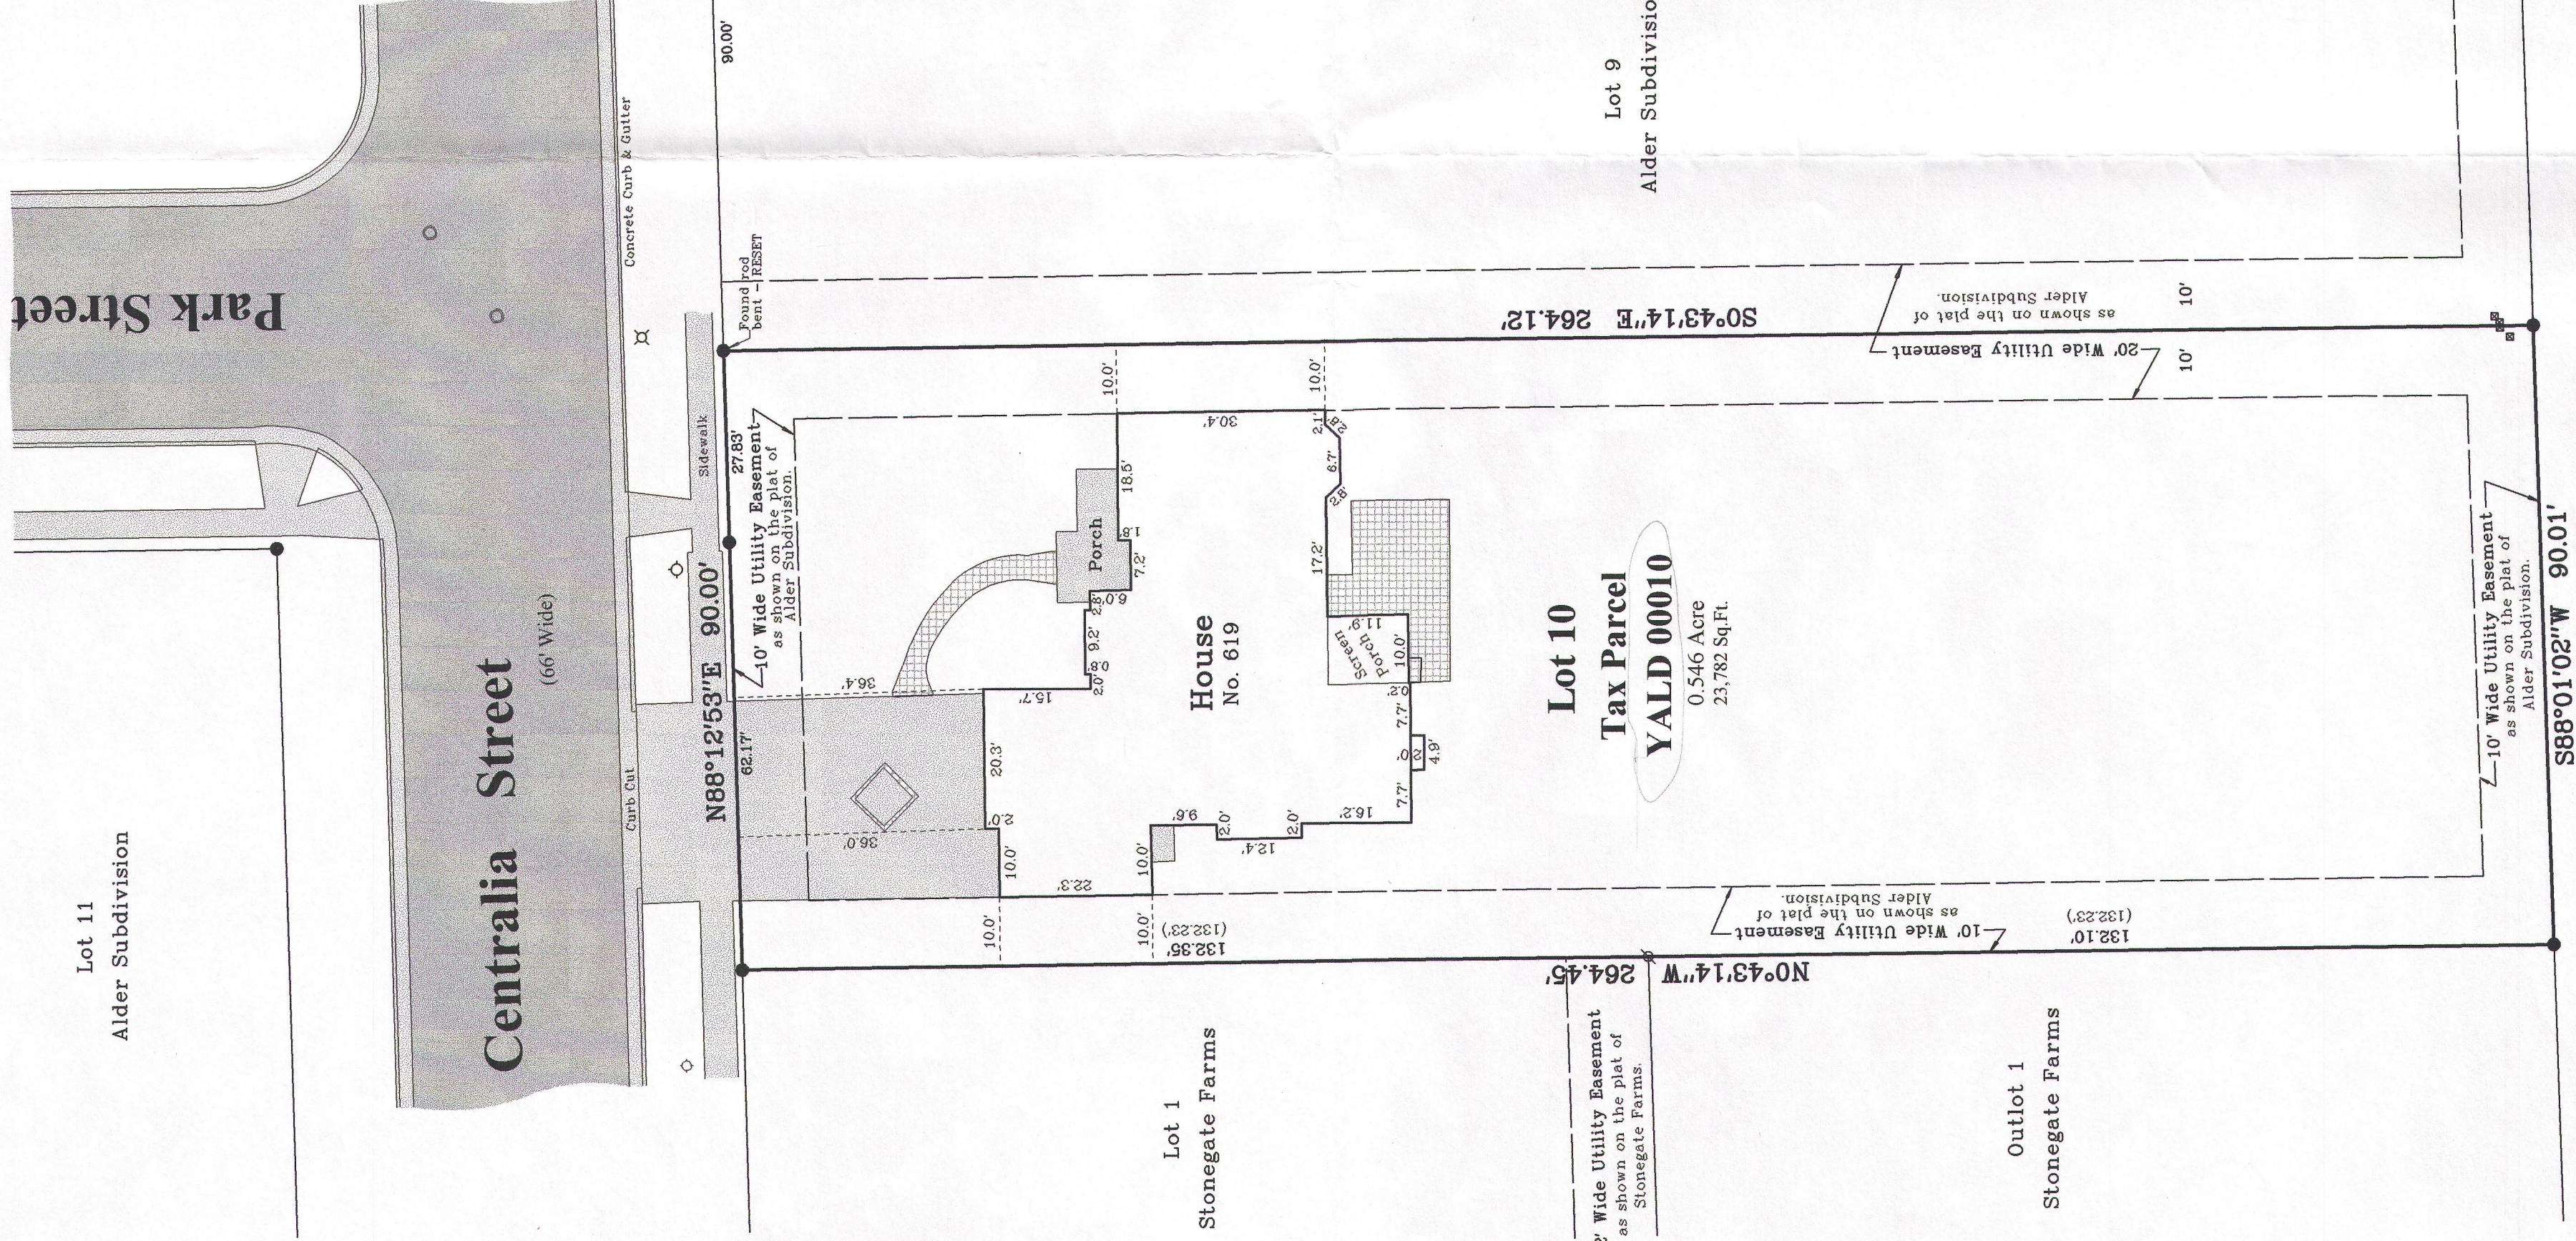

Bearings referenced to the
plat of Alder Subdivision.



Notes:

- 1) This survey plat is not certified unless signed and sealed in red ink.
- 2) This survey is subject to Wisconsin lien laws. This Plat of Survey is the notice of intent to file lien. Lien waiver required.

Copyright 2013 by Jensen & Olson Land Surveying, LLC.

All rights reserved. No part of this survey plat may be reproduced or transmitted in any form by any means - graphic, electronic, or mechanical, including photocopying, tracing, or information storage and retrieval systems - without permission in writing from Douglas G. Olson, Jensen & Olson Land Surveying, LLC.

I hereby certify that I have surveyed the above described property and the map hereon is correct to the best of my professional knowledge and belief and shows the size and location of the property, its exterior boundaries, the location and dimensions of all visible structures thereon, boundary fences, apparent easements and roadways and visible encroachments, if any.

This survey is made for the exclusive use of the present owners of the property, and also those who purchase, mortgage or guarantee title thereto, within one year from the date hereof.



Tax Parcel

Sheet 1 of 1 Sheets

Drawing Name: 12m (6c-2013)084-2013084(Plat.swg)

Job Reference Number

2013.084

Legend

- Found Iron Rod
- Recorded Information
- ⊗ Utility Pedestal
- ⊗ Manhole
- ⊗ Fire Hydrant
- ⊗ Light Pole
- ⊗ Asphalt Surface
- ⊗ Gas
- ⊗ Concrete Surface
- ⊗ Brick Pavers

Jensen & Olson Land Surveying, LLC

45 South Wisconsin Street * P.O. Box 322 * Elkhorn, Wisconsin. 53121

Telephone: (262) 723-3434 * Facsimile: (262) 723-8044

Email: jensen.olson@elknet.net

Survey Date: August 2, 2013.
Revisions:

Scale in Feet
1" = 20'



2013.084

004-2394