
60-20

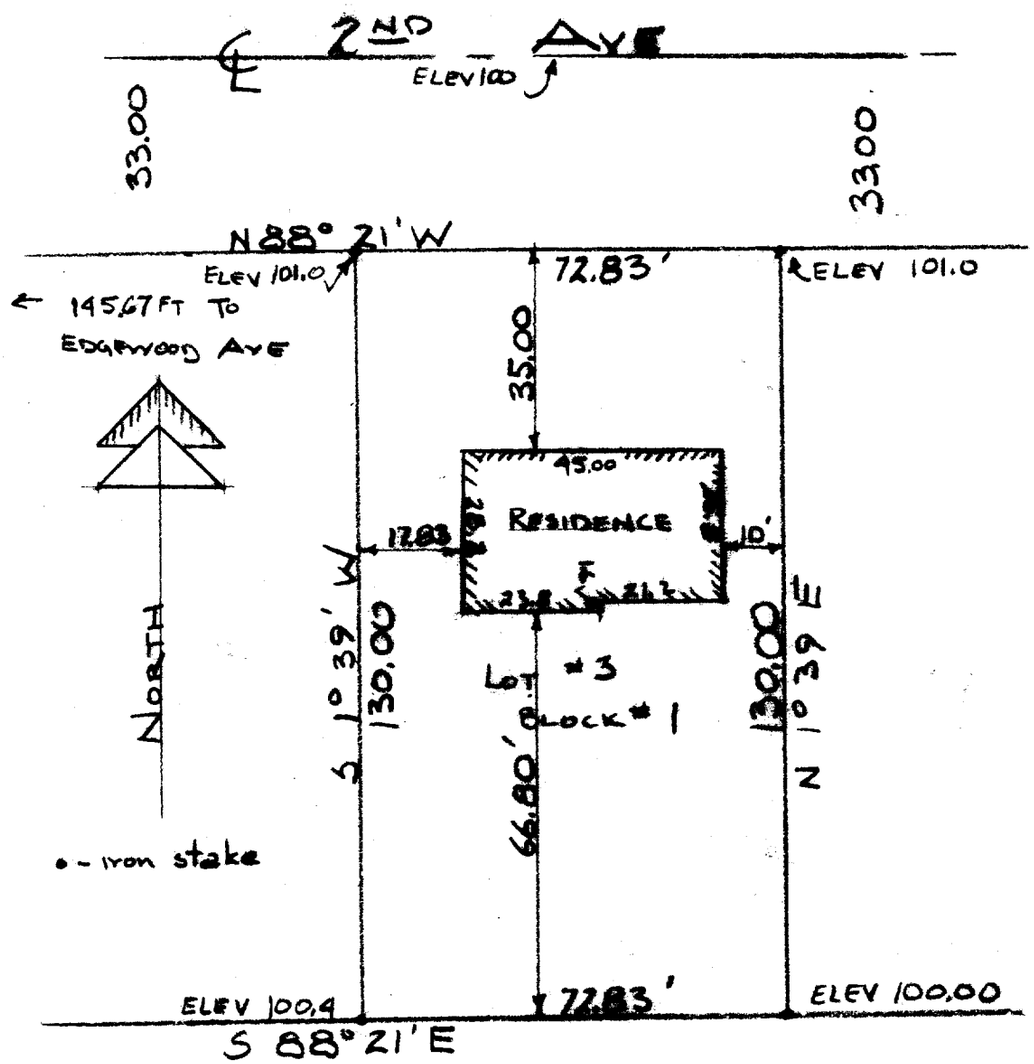

DESCRIPTION: Lot # 3 of Block # 1 of Edgewood Subdivision in the City of Elkhorn, Walworth County, Wisconsin.

CERTIFICATE: I hereby certify that I have surveyed the property hereon described and that the location of all the improvements are as shown hereon.

SIGNED AND SEALED ON OCTOBER 4TH 1960.

James F. Biagi (272 RLS)

YES