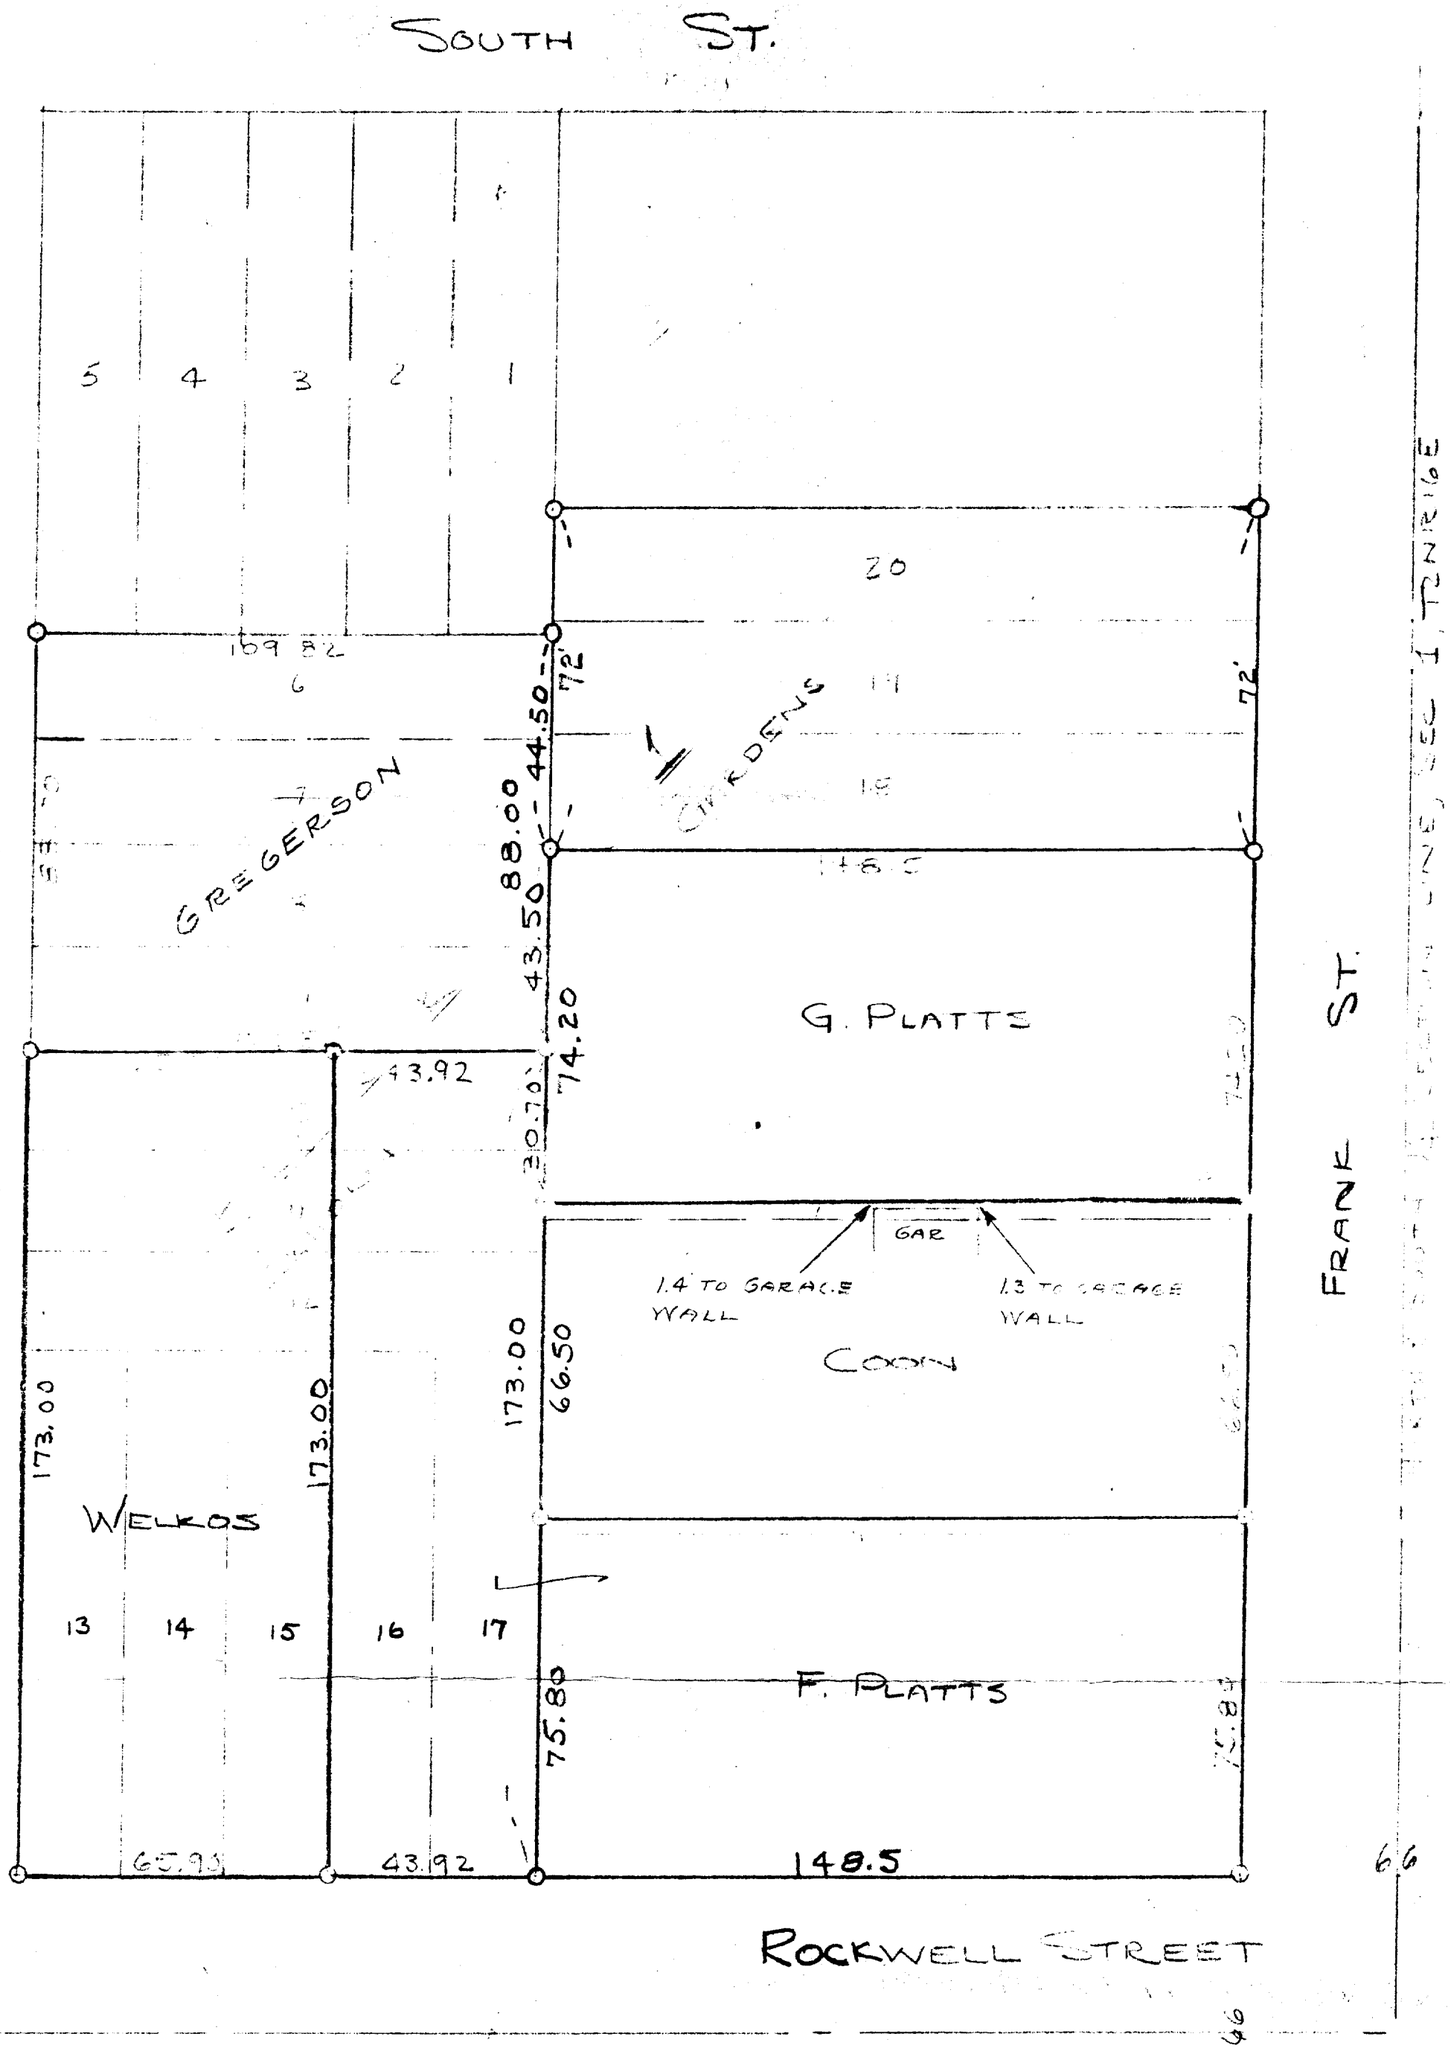

N

O = IRON PIPE
SCALE 1" = 30'

PLAT OF SURVEY OF LAND LOCATED IN THE CITY OF ELKHORN, WALWORTH COUNTY, WISCONSIN, WHICH LAND IS LOTS 6 THRU 17, INCL. OF BLOCK 1 OF ELKHORN GARDENS, AND UNPLATTED LAND BOUNDED BY SAID SUBDIVISION AND ROCKWELL AND FRANK STS.

AUGUST 1950

Floyd L. Jensen
COUNTY SURVEYOR

YEN-2, 2A, 3, 3A, 3B YU SW-8

4-23 J