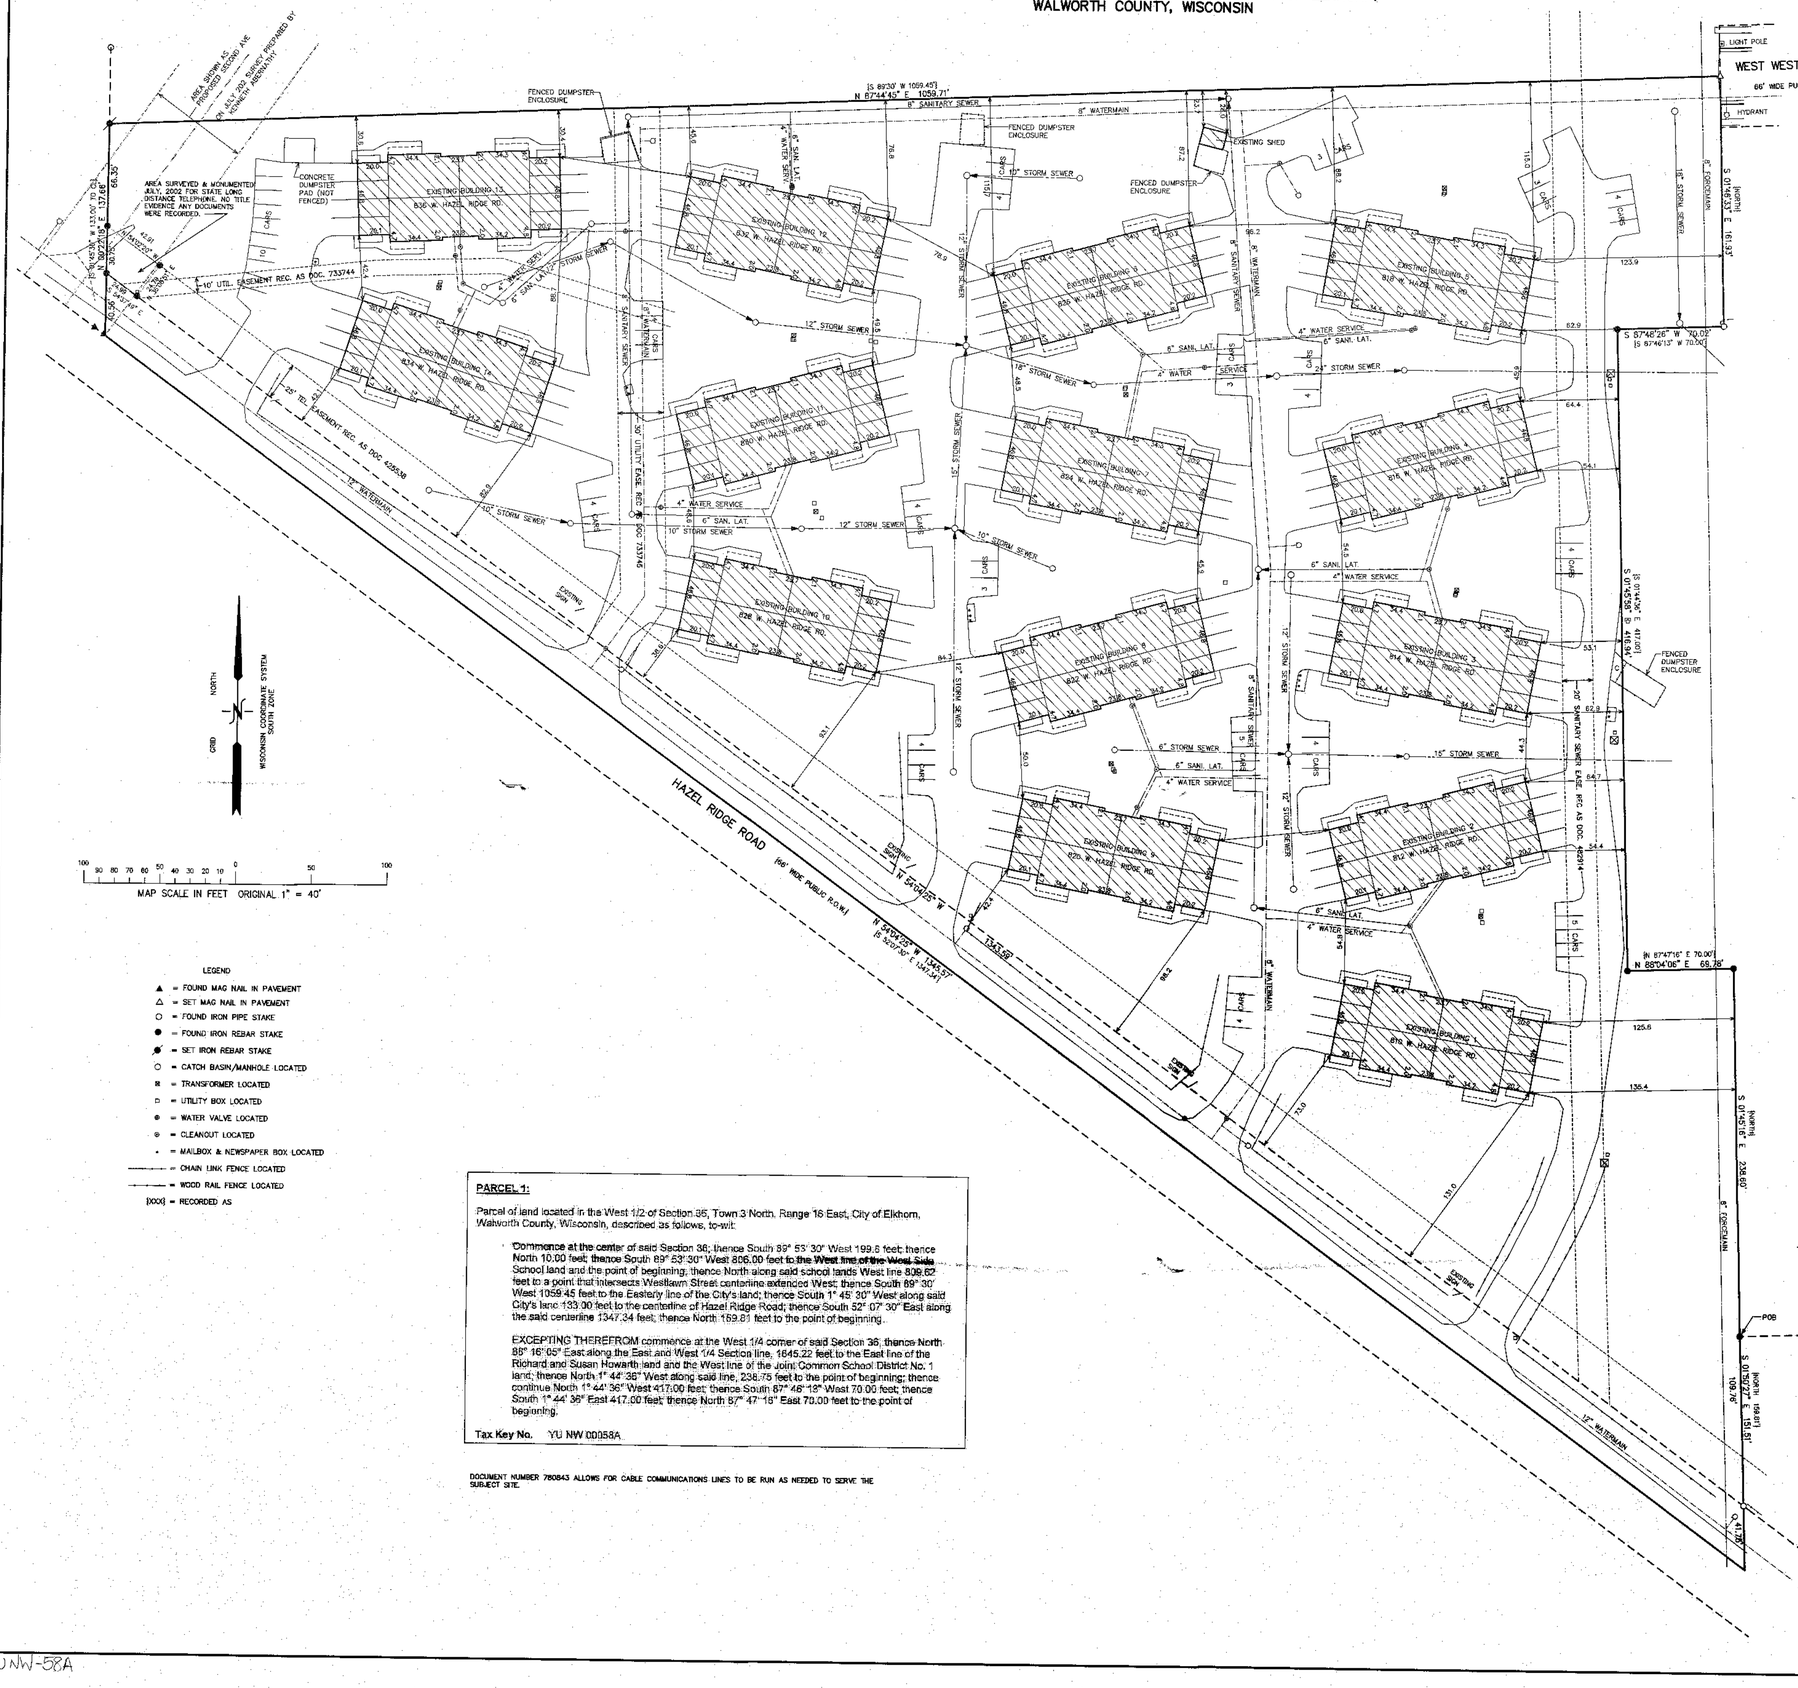
TITLE SURVEY

PART OF THE NORTHWEST 1/4 AND SOUTHWEST 1/4 OF SECTION 36, TOWN 3 NORTH, RANGE 16 EAST, CITY OF ELKHORN, WALWORTH COUNTY, WISCONSIN


WEST WESTLAWN AVE
66' WIDE PUBLIC ROW
HAZEL RIDGE ROAD
66' WIDE PUBLIC R.O.W.
EXISTING SHED
FENCED DUMPSTER ENCLOSURE
CONCRETE DUMPSTER PAD (NOT FENCED)
AREA SURVEYED & MONUMENTED JULY, 2002 FOR STATE LONG DISTANCE TELEPHONE. NO TITLE EVIDENCE ANY DOCUMENTS WERE RECORDED.
AREA STAKED AS PROPOSED SECOND AVE. PER JULY, 2002 SURVEY PREPARED BY KENNETH ABERNATHY
10' UTIL. EASEMENT REC. AS DOC. 733744
25' TEL. EASEMENT REC. AS DOC. 405638
10' RESERVED
EXISTING SIGN
EXISTING GRID
POB
POINT OF BEGINNING
N 87°44'45" E 1059.71'
S 89°30' W 1059.45'
N 87°47'16" E 70.00'
N 88°04'06" E 66.78'
S 87°48'26" W 70.02'
S 87°46'13" W 70.00'
