
57-55

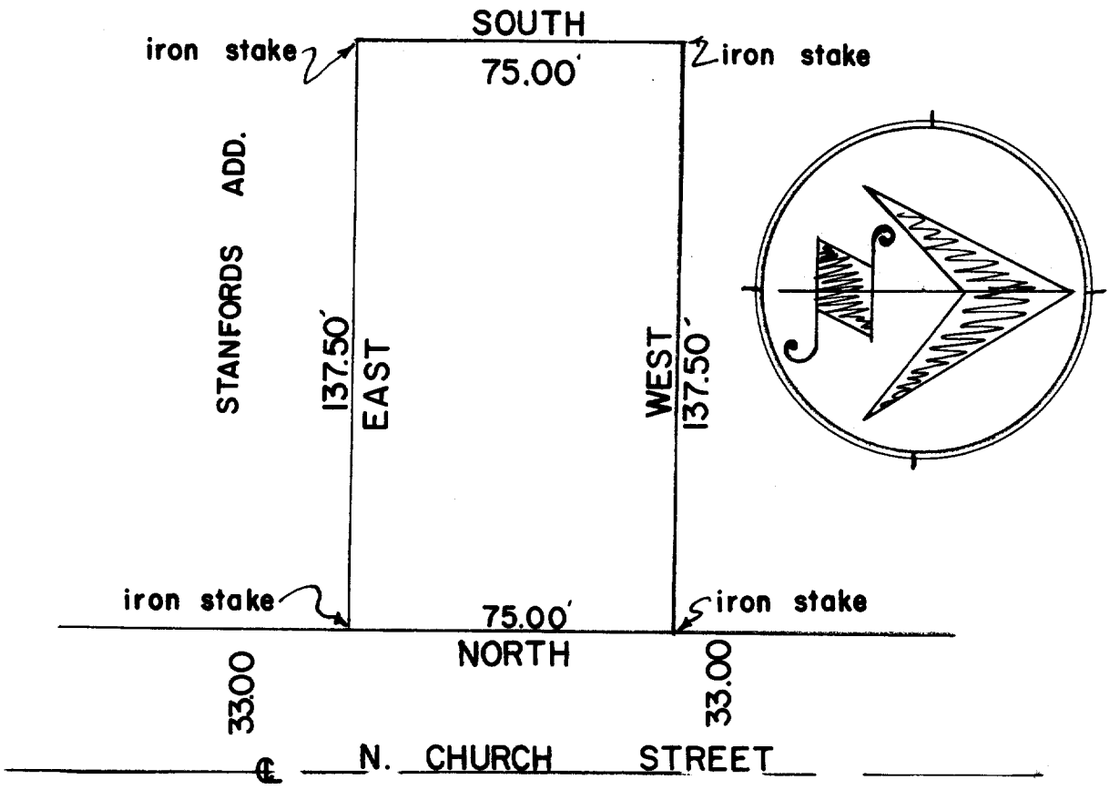

DESCRIPTION: Commencing at an iron stake that is 134.00 feet North of the intersection of the North line of 2nd. Ave and the West line of North Church Street, in the City of Elkhorn, Wisconsin; thence North in the West line of North Church Street 75.00 feet to an iron stake, thence West 137.50 feet to an iron stake, thence South 75.00 feet to an iron stake, thence East 137.50 feet to the place of beginning.

CERTIFICATE: I, James F. Biagi surveyor, hereby certify that I have surveyed the property hereon described and that no encroachments exist.

James F. Biagi
SURVEYOR

WISCONSIN
JAMES F. BIAGI
MILWAUKEE, WIS.
LAND SURVEYOR

c UNW-26

NE¼ - 36-3-16

4-2428