

Wisconsin Registered Land Surveyor S-2582


**N9330 Knuteson Drive
Whitewater, WI 53190
Phone: (262) 495-3284
MARKMIRITZ@
LAND-MARKSURVEYING.COM**

**LOT 5, IN BLOCK 1, HODGES ADDITION,
IN THE CITY OF ELKHORN, WALWORTH
COUNTY, WISCONSIN**

**ORDERED BY: CONNIE POGGENSEE
RAULAND AGENCY, INC.
118 KENOSHA STREET
WALWORTH, WI 53184**

SURVEYOR'S NOTE:

THIS SURVEY WAS BASED ON RESURVEY INFORMATION OF THE CITY OF ELKHORN BY H.H. TUBBS, CITY ENGINEER, DATED JULY 1930.

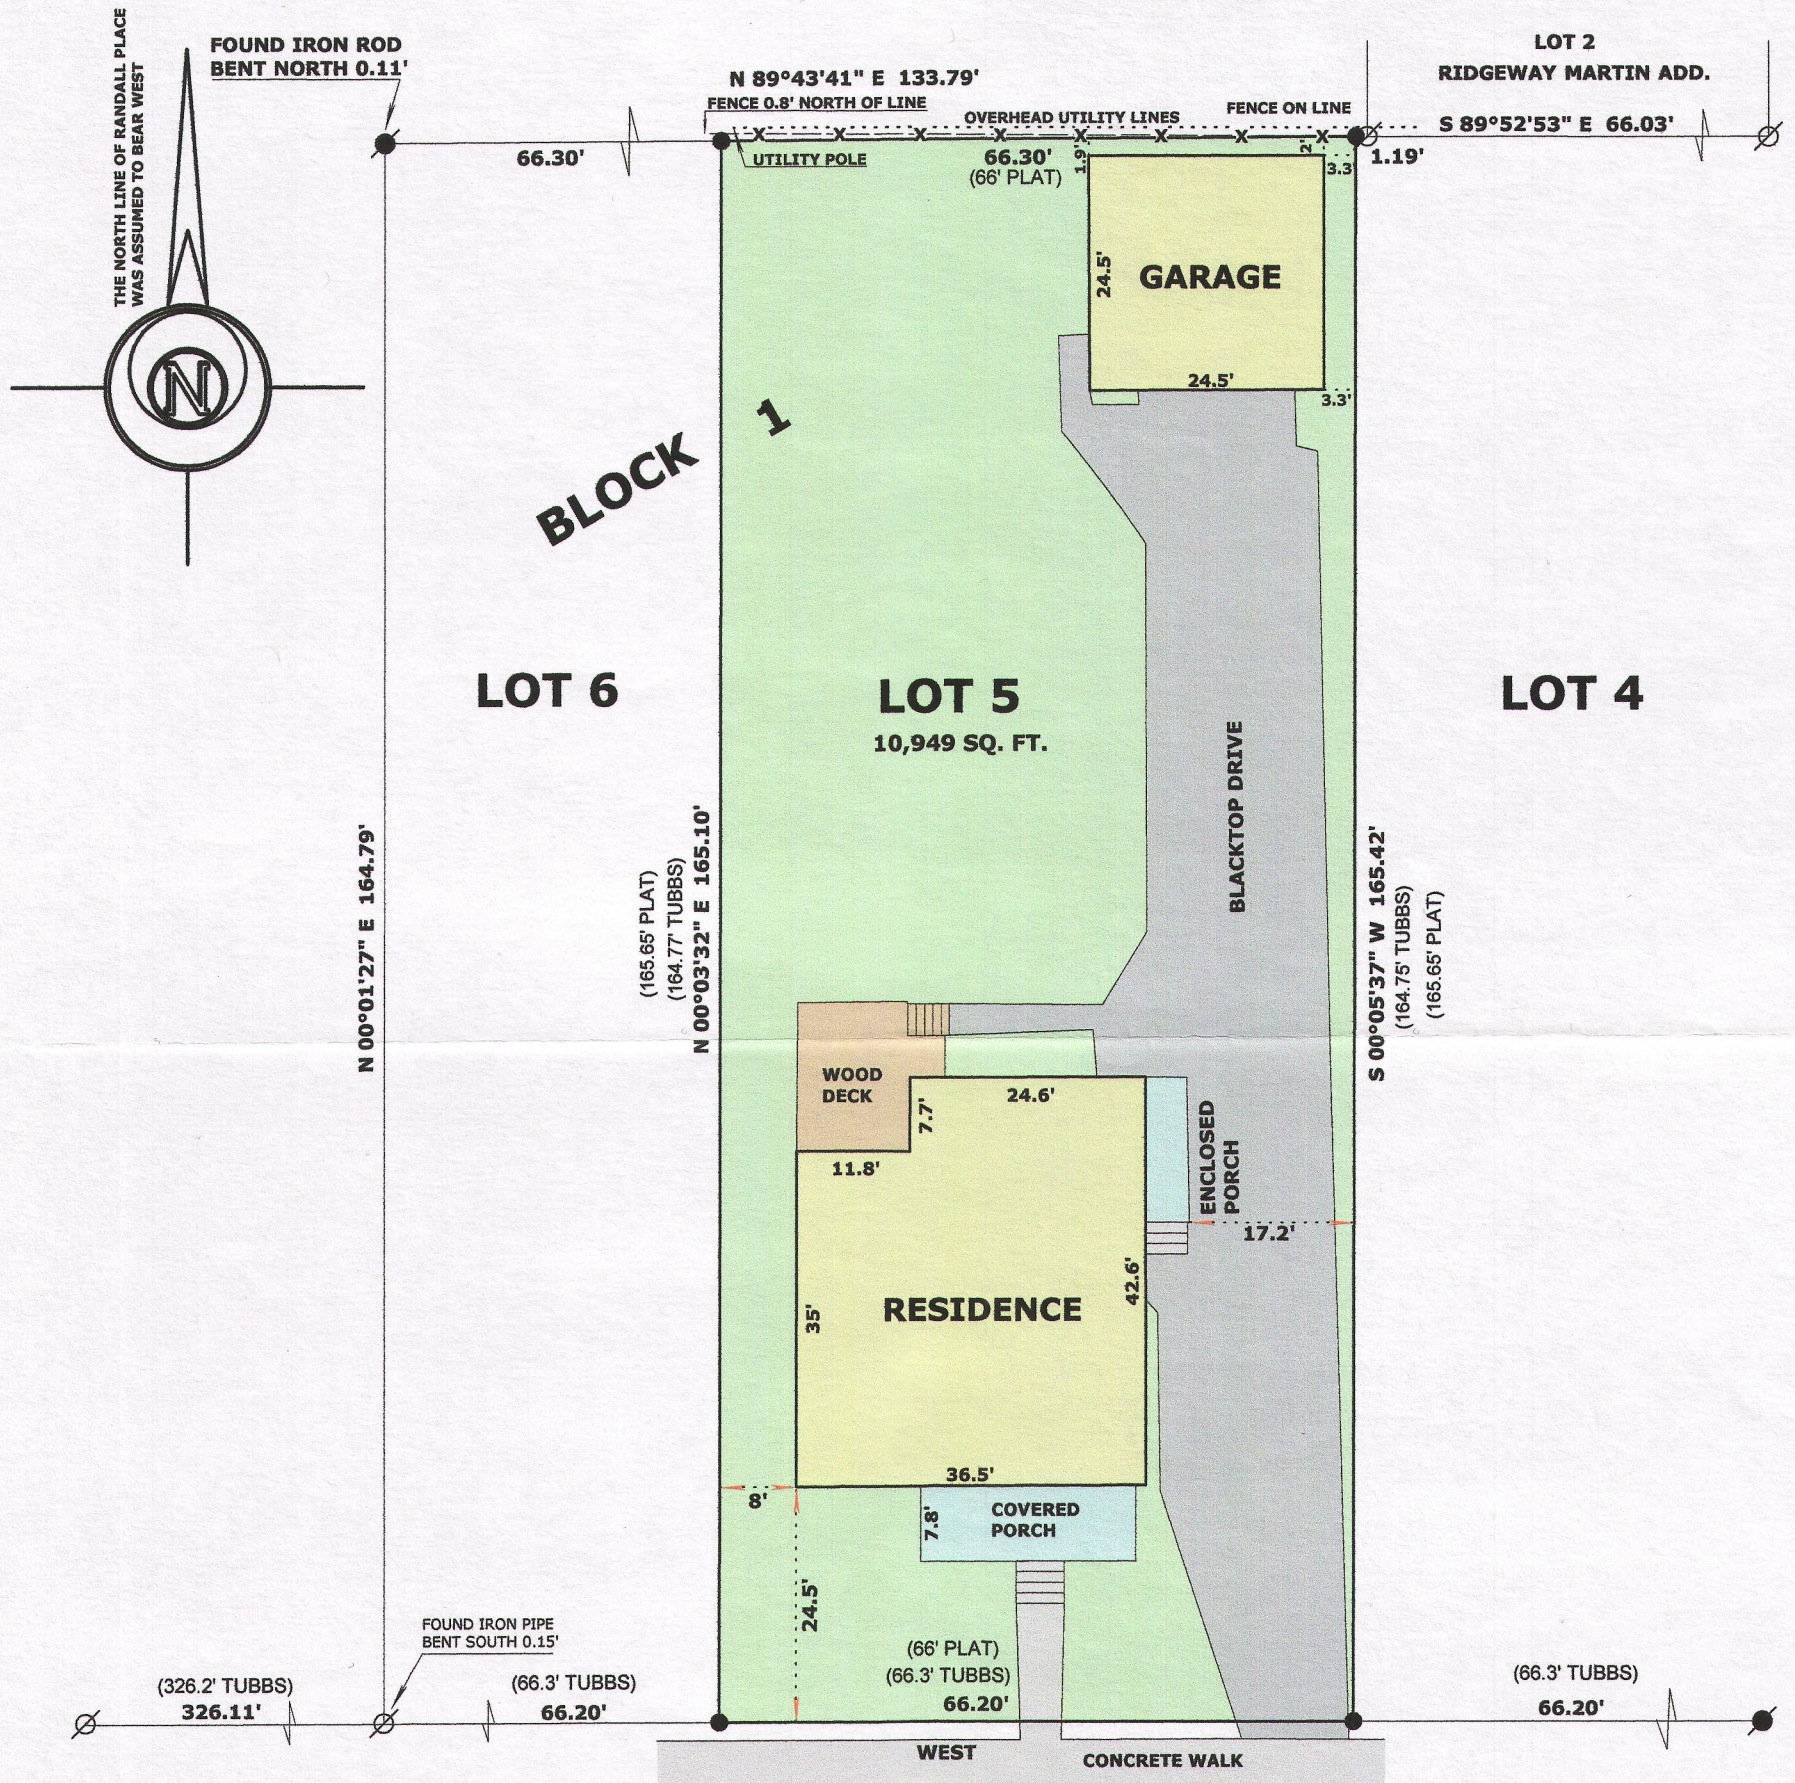

LEGEND

- | | |
|---|--|
|  | FOUND IRON PIPE |
|  | FOUND IRON ROD |
|  | SET IRON ROD, 18" LONG, WEIGHING
1.5 LBS./LINEAL FT., 3/4" DIA. |
| (x x) | RECORDED AS DIMENSION |
|  | EXISTING FENCE |

SCALE: 1 INCH = 20 FEET

"I hereby certify that the above described property has been surveyed by me or under my direction and that the above map is a true representation thereof and shows the size and location of the property, its exterior boundaries, the location of all visible structures and dimensions of all principal buildings thereon, boundary fences, apparent easements, roadways and visible encroachments, if any."

"This survey is made for the use of the present owners of the property, and also those who purchase, mortgage, or guarantee the title thereto within one year from date hereof."

MARK L. MIRITZ

**WISCONSIN REGISTERED
LAND SURVEYOR S-2582**

DATE: OCT. 15, 2014 **JOB NO.** 14.1006



YHO - 4

004-2436