
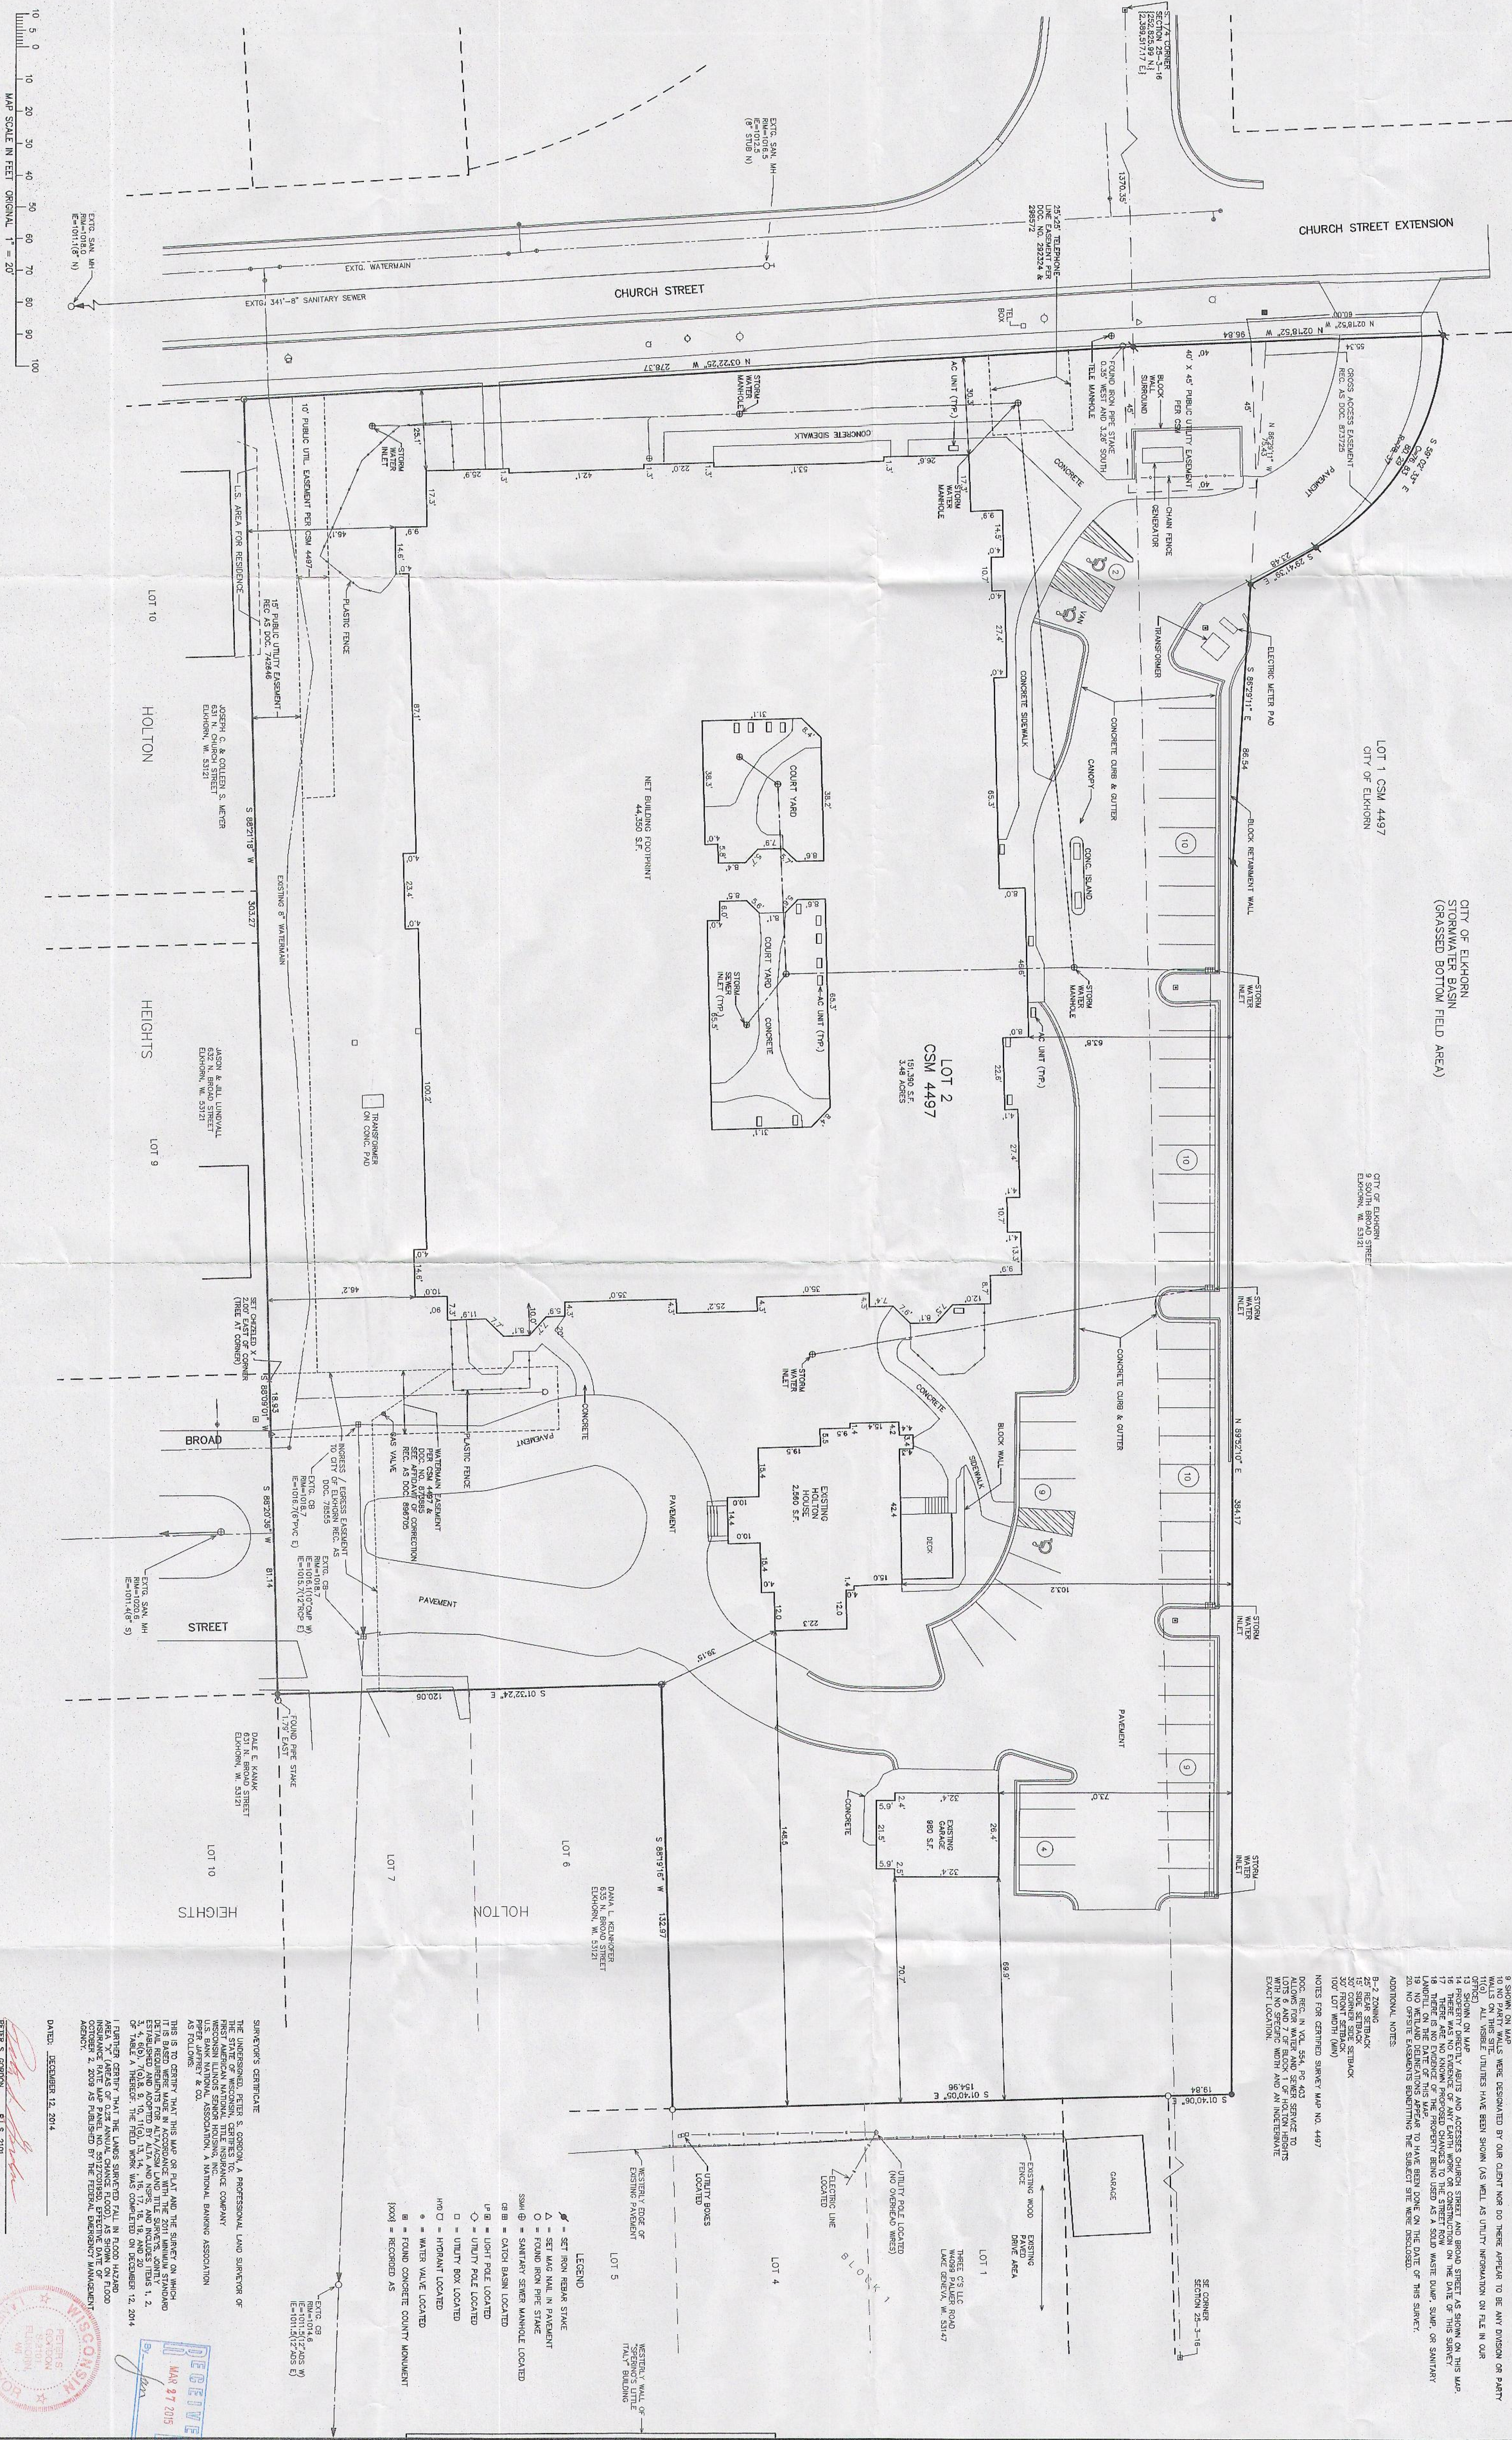


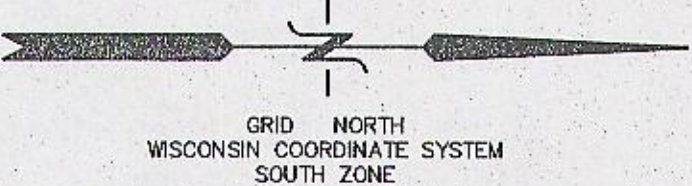

ALTA/ACSM LAND TITLE SURVEY
LOT 2 OF CERTIFIED SURVEY MAP NO. 4497
REC. IN VOL. 29, ON PAGE 194 AS DOC. 873885
PART OF THE SE 1/4 OF SECTION 25 AND PART OF THE
NE 1/4 OF SECTION 36, TOWN 3 NORTH, RANGE 16 EAST,
CITY OF ELKHORN, WALWORTH COUNTY, WISCONSIN

SURVEY NOTES

THIS MAP HAS BEEN PREPARED IN RELATION TO THE FIRST AMERICAN TITLE INSURANCE COMPANY COMMITMENT NO. 14740, DATED 12/23/2014.

1. ALL UNUSUALS HAVE BEEN FOUND OR NOTED.
2. ADDRESS: 638 NORTH BROAD STREET, ELKHORN, WI. PER TITLE INFORMATION PROVIDED.
FARRIS, HANSEN & ASSOCIATES, INC.
ENGINEERING - ARCHITECTURE - SURVEYING
7 RIDGWAY COURT P.O. BOX 437
ELKHORN, WISCONSIN 53121
OFFICE: (262) 723-2098 FAX: (262) 723-5886

WORK ORDERED BY:
HOLTON MANOR SKILLED NURSING FACILITY
638 NORTH BROAD STREET
ELKHORN, WI. 53121

ALTA/ACSM LAND
TITLE SURVEY

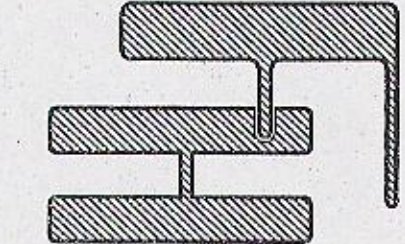

PROJECT NO.
8749
DATE
12/14/2014
SHEET NO.
1 OF 1