
LAND-MARK SURVEYING
Mark L. Miritz
Wisconsin Professional Land Surveyor S-2582

N9330 Knuteson Drive
Whitewater, WI 53190
Phone:(262)495-3284
MARKMIRITZ@
LAND-MARKSURVEYING.COM

ORDERED BY:
CONNIE POGGENSEE
THE RAULAND AGENCY
118 KENOSHA STREET
WALWORTH, WI 53184

PLAT OF SURVEY

LOT 17, URBANDALE, ACCORDING TO THE PLAT THEREOF RECORDED IN CABINET B, SLIDE 119 AS DOCUMENT NO. 234555, CITY OF ELKHORN, WALWORTH COUNTY, WISCONSIN.

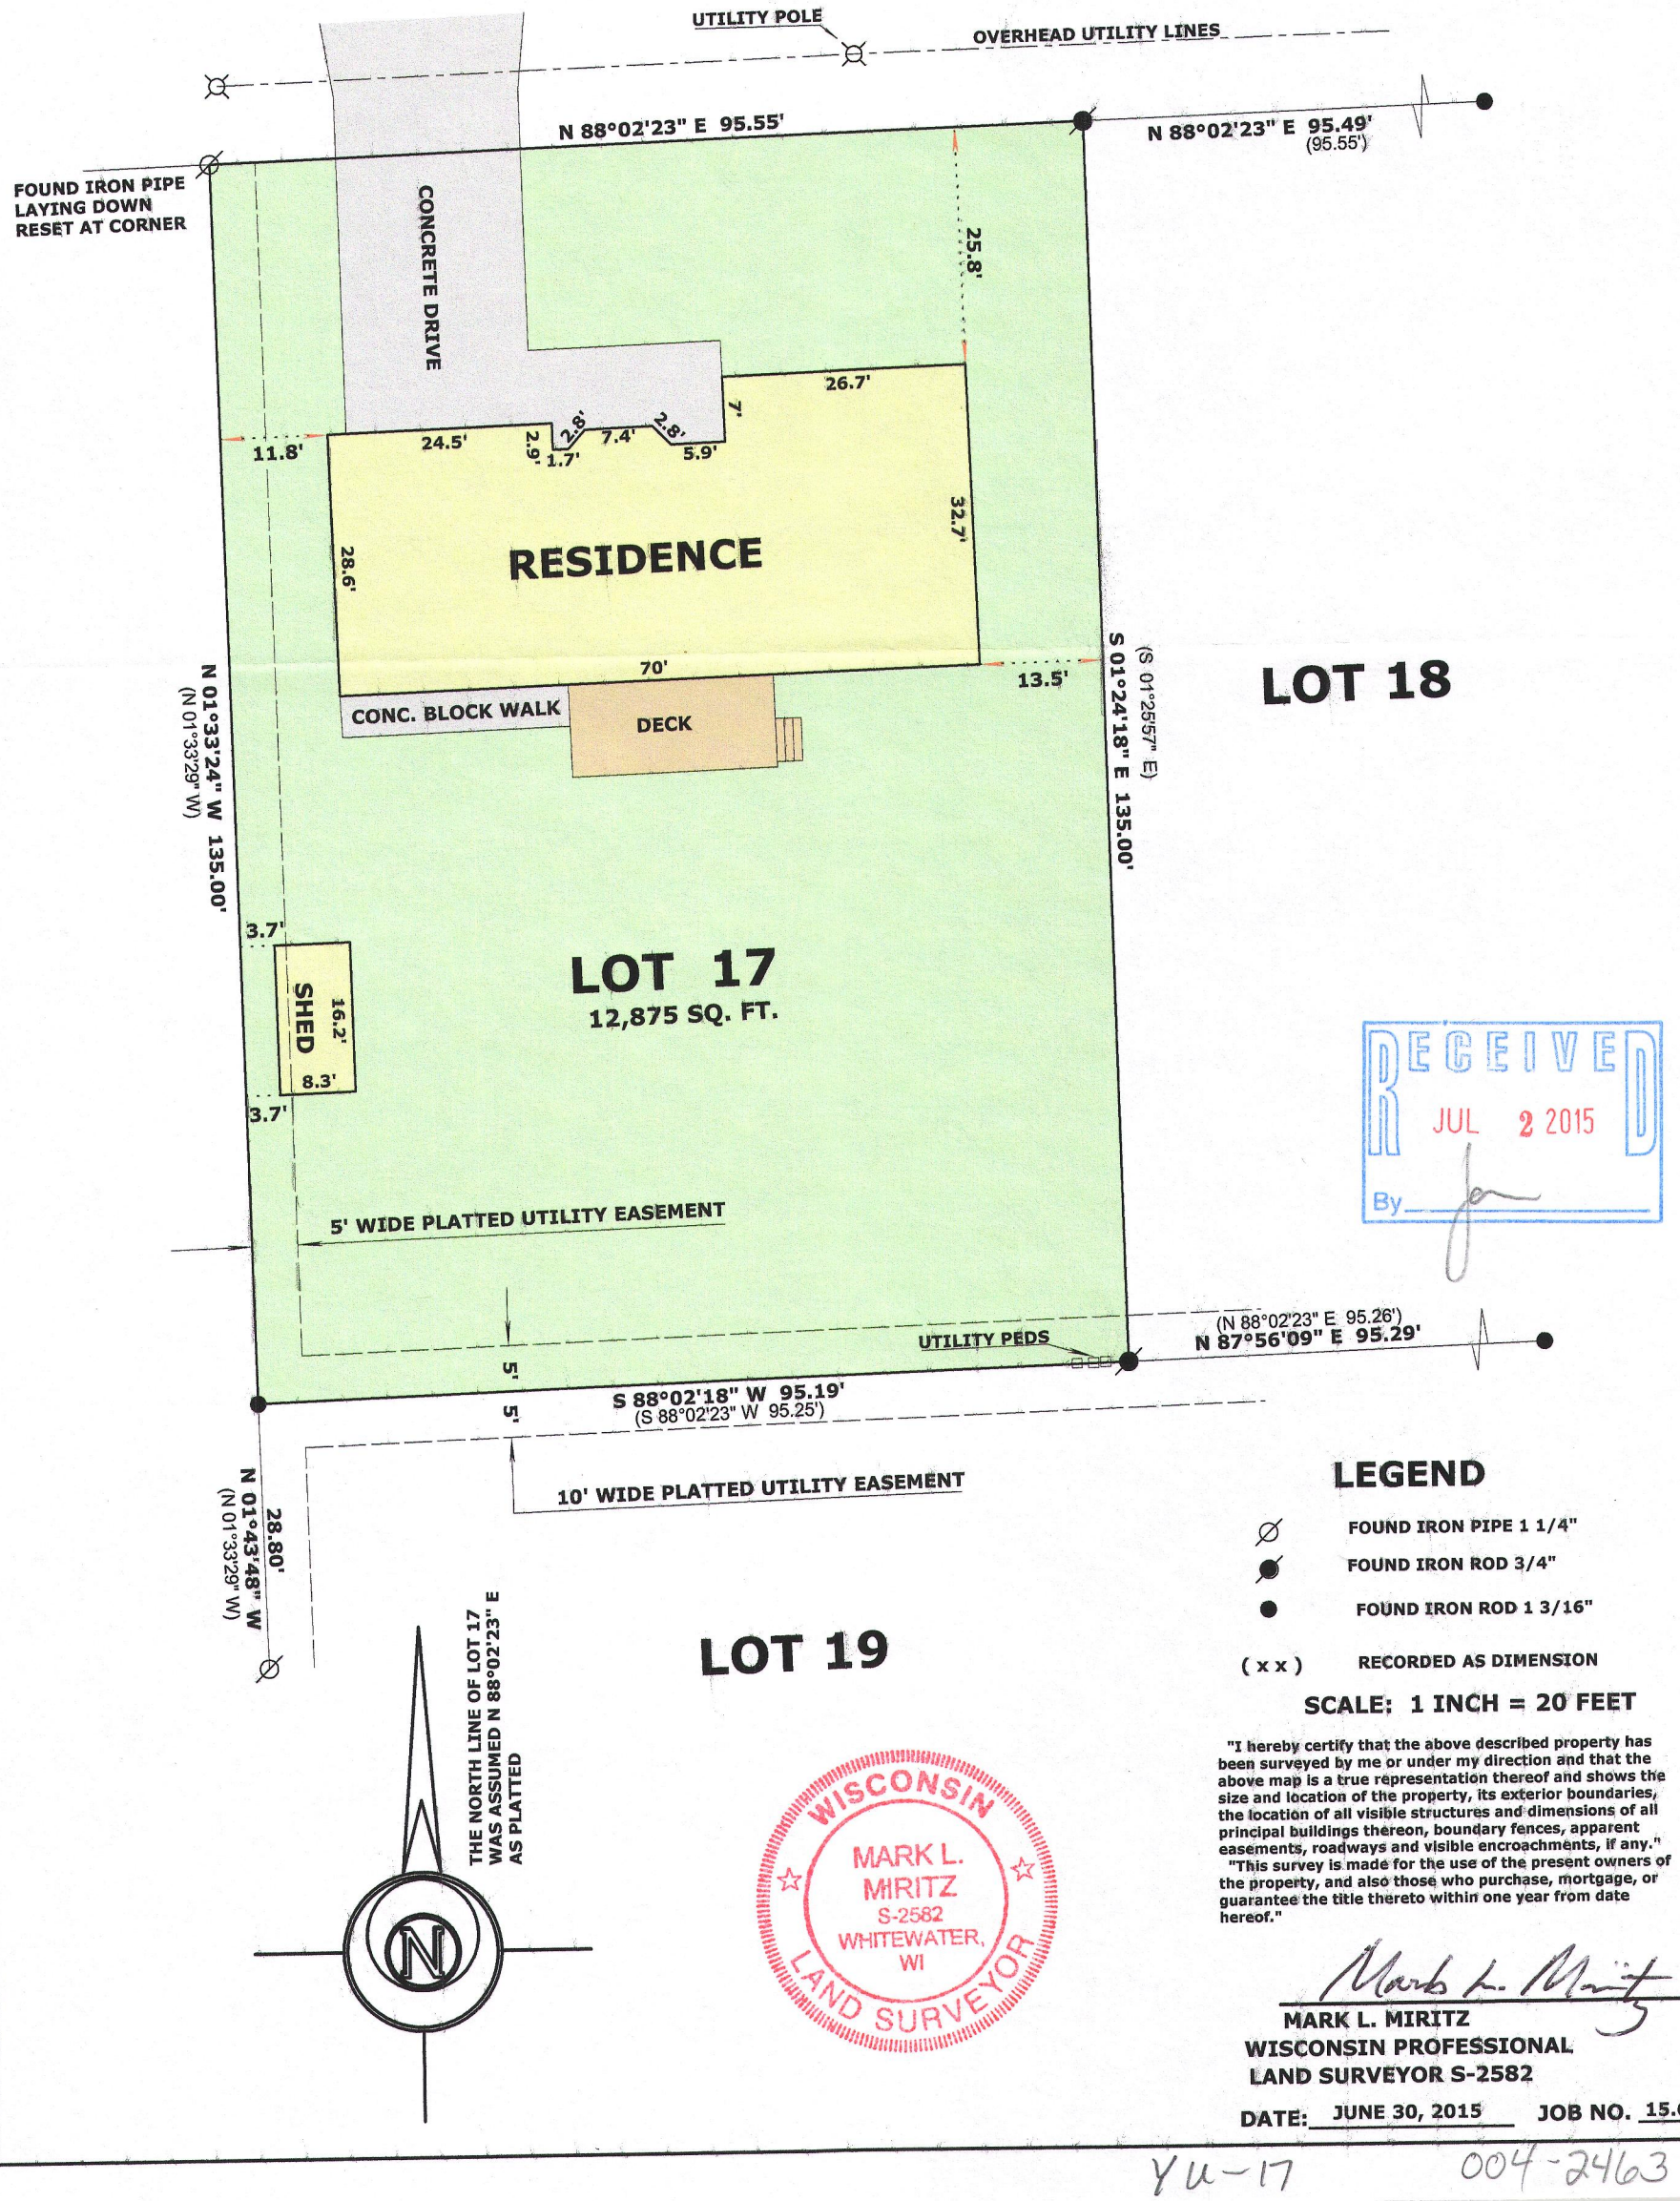

RECEIVED
JUL 2 2015
By

LEGEND

- ⌀ FOUND IRON PIPE 1 1/4"
- ● FOUND IRON ROD 3/4"
- ● FOUND IRON ROD 1 3/16"
- (x x) RECORDED AS DIMENSION

SCALE: 1 INCH = 20 FEET

"I hereby certify that the above described property has been surveyed by me or under my direction and that the above map is a true representation thereof and shows the size and location of the property, its exterior boundaries, the location of all visible structures and dimensions of all principal buildings thereon, boundary fences, apparent easements, roadways and visible encroachments, if any."
"This survey is made for the use of the present owners of the property, and also those who purchase, mortgage, or guarantee the title thereto within one year from date hereof."

WISCONSIN
MARK L. MIRITZ
S-2582
WHITEWATER, WI
LAND SURVEYOR

Mark L. Miritz

MARK L. MIRITZ
WISCONSIN PROFESSIONAL
LAND SURVEYOR S-2582

DATE: JUNE 30, 2015 **JOB NO.** 15.614

YU-17 004-2463