

LEGEND

- ◎ FOUND 1-3/16" DIA. IRON ROD
- ● FOUND 3/4" DIA. IRON ROD
- ○ SET 1-5/16" O.D. IRON PIPE
- ( ) RECORDED AS

BEARINGS HEREON RELATE TO THE SOUTH LINE OF LOT 17 OF ALDER SUBDIVISION. ASSUMED BEARING OF SOUTH 89°13'29" WEST AS PLATTED.

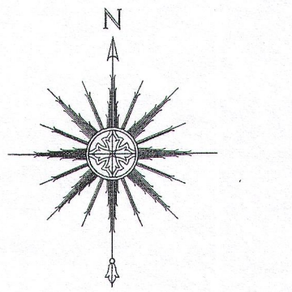

SCALE: 1" = 20'

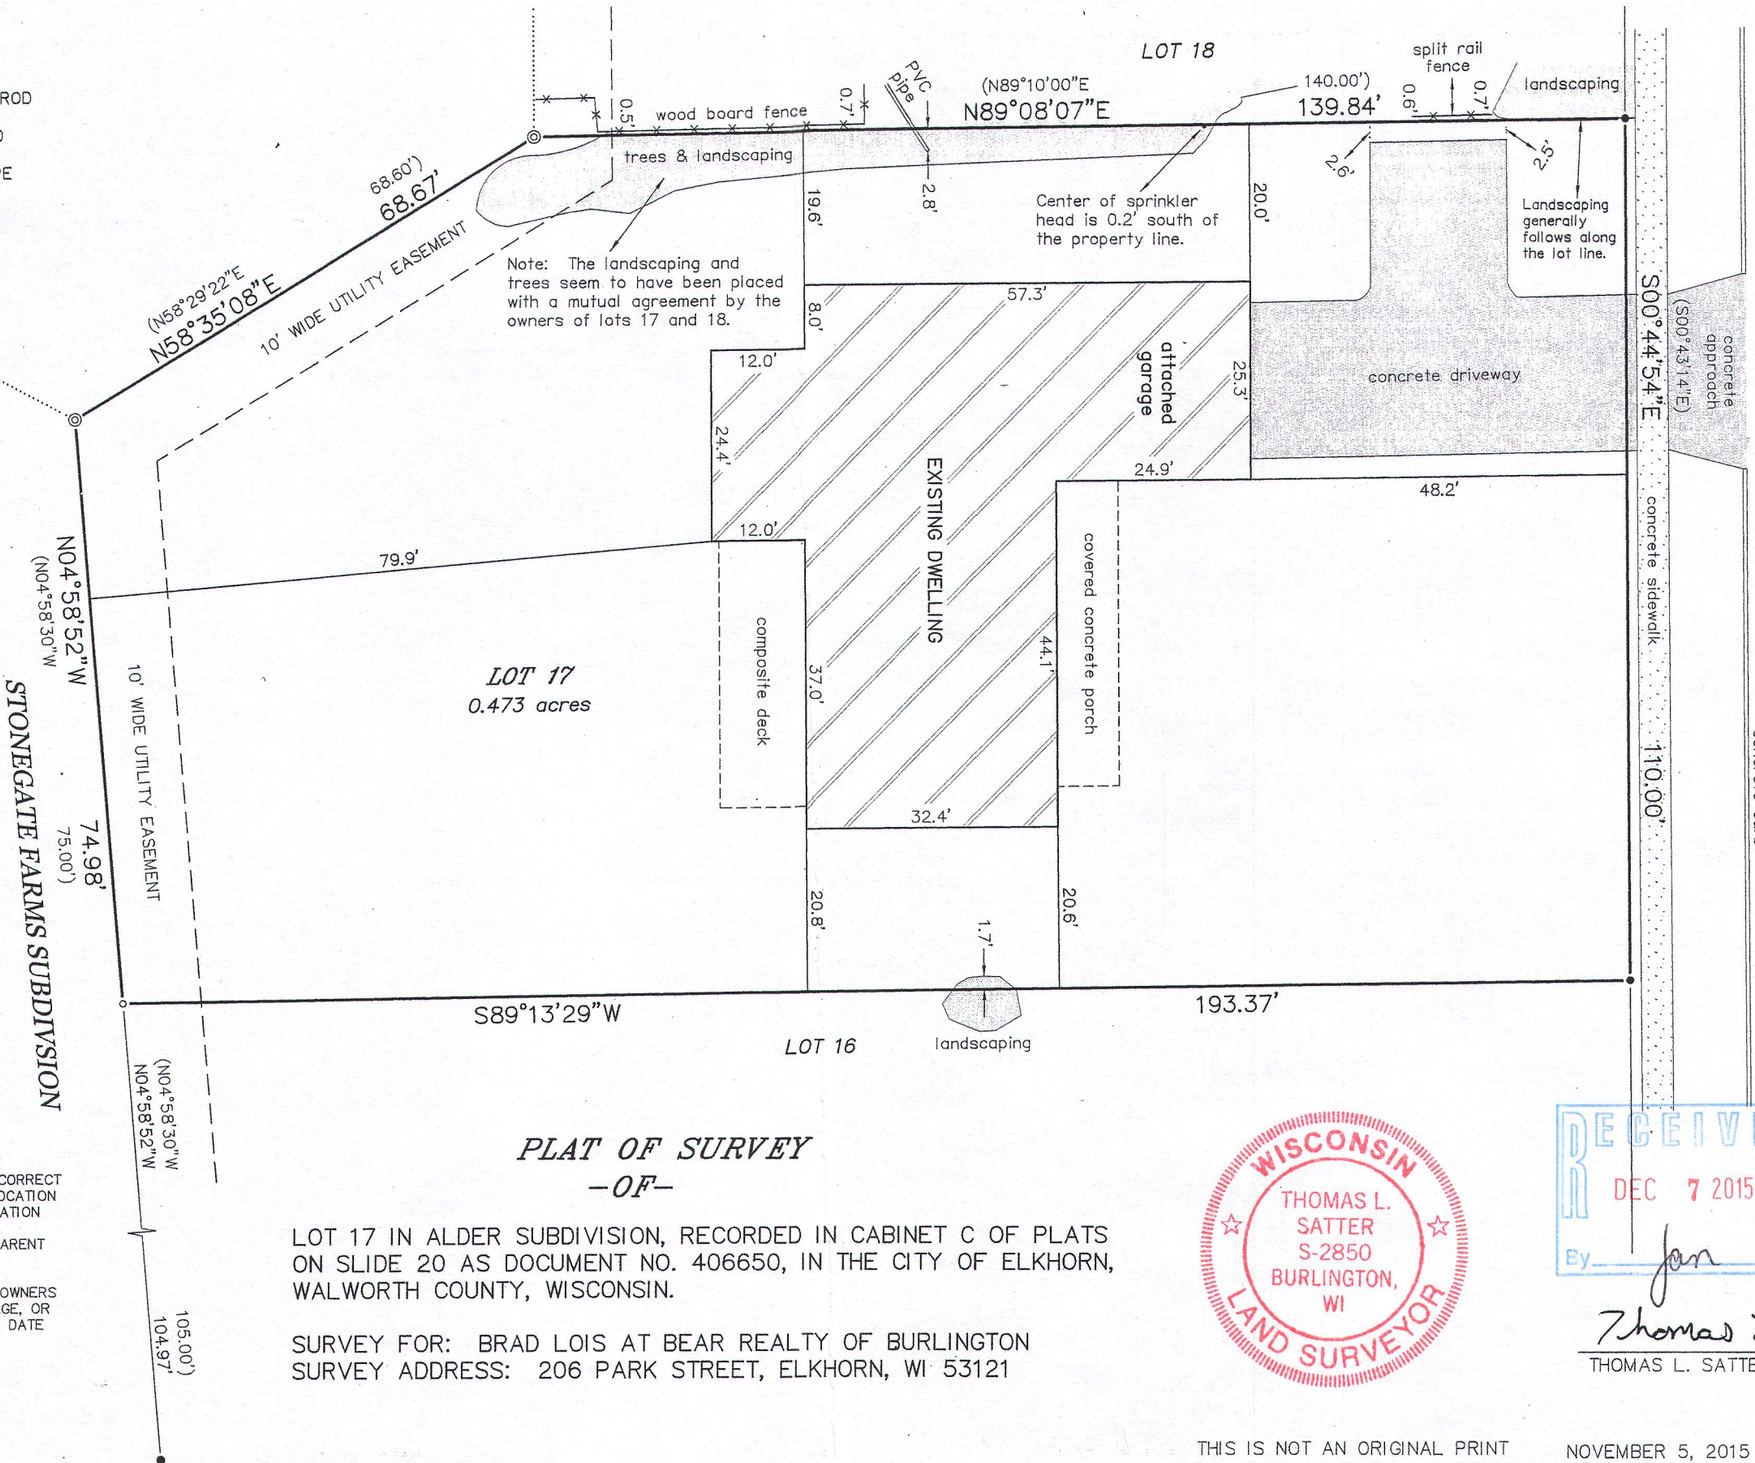

"I HEREBY CERTIFY THAT I HAVE SURVEYED THE ABOVE DESCRIBED PROPERTY AND THAT THE ABOVE MAP IS A CORRECT REPRESENTATION THEREOF AND SHOWS THE SIZE AND LOCATION OF THE PROPERTY, ITS EXTERIOR BOUNDARIES, THE LOCATION OF ALL VISIBLE STRUCTURES AND DIMENSIONS OF ALL PRINCIPAL BUILDINGS THEREON, BOUNDARY FENCES, APPARENT EASEMENTS, ROADWAYS AND ENCROACHMENTS, IF ANY."

"THIS SURVEY IS MADE FOR THE USE OF THE PRESENT OWNERS OF THE PROPERTY, AND THOSE WHO PURCHASE, MORTGAGE, OR GUARANTEE THE TITLE THERETO WITHIN ONE YEAR FROM DATE HEREOF."

SATTER SURVEYING, LLC
LAND SURVEYS, MAPPING AND PLANNING
272 ORIGEN STREET
BURLINGTON, WI 53105
262-661-4239

PLAT OF SURVEY
-OF-

LOT 17 IN ALDER SUBDIVISION, RECORDED IN CABINET C OF PLATS ON SLIDE 20 AS DOCUMENT NO. 406650, IN THE CITY OF ELKHORN, WALWORTH COUNTY, WISCONSIN.

SURVEY FOR: BRAD LOIS AT BEAR REALTY OF BURLINGTON
SURVEY ADDRESS: 206 PARK STREET, ELKHORN, WI 53121

WISCONSIN
THOMAS L. SATTER
S-2850
BURLINGTON, WI
LAND SURVEYOR

RECEIVED
DEC 7 2015
By

Thomas L. Satter
THOMAS L. SATTER S-2850

THIS IS NOT AN ORIGINAL PRINT UNLESS THIS SEAL IS RED.

NOVEMBER 5, 2015
DATE

101514
JOB NUMBER

YALd-17 004-2480