FARRIS, HANSEN & ASSOCIATES, INC.


ENGINEERING – ARCHITECTURE – SURVEYING
7 RIDGWAY COURT – P.O. BOX 437 – ELKHORN, WISCONSIN 53121
PHONE: (262) 723–2098 FAX: (262) 723–5886

PLAT OF SURVEY

PART OF THE NE 1/4 SECTION 36
TOWN 3 NORTH, RANGE 16 EAST
CITY OF ELKHORN
WALWORTH COUNTY, WISCONSIN

– WORK ORDERED BY –
JON WINDEN
315 N. BROAD STREET
ELKHORN, WI.

A piece or parcel of land situated in the Southeast ¼ of the Northeast ¼ of Section 36, Town 3 North, Range 16 East, City of Elkhorn, Walworth County, Wisconsin, State of Wisconsin, and described as beginning at an iron gas pipe set at a point in the East line of North Broad Street, 66 feet North of the East and West 1/4 line in said Section 36, thence East parallel with said 1/4 line, 91 feet to an iron gas pipe, thence North 99 feet to an iron gas pipe; thence West 91 feet to an iron gas pipe set in the East line of Broad Street; thence South in said East line 99 feet to the place of beginning.

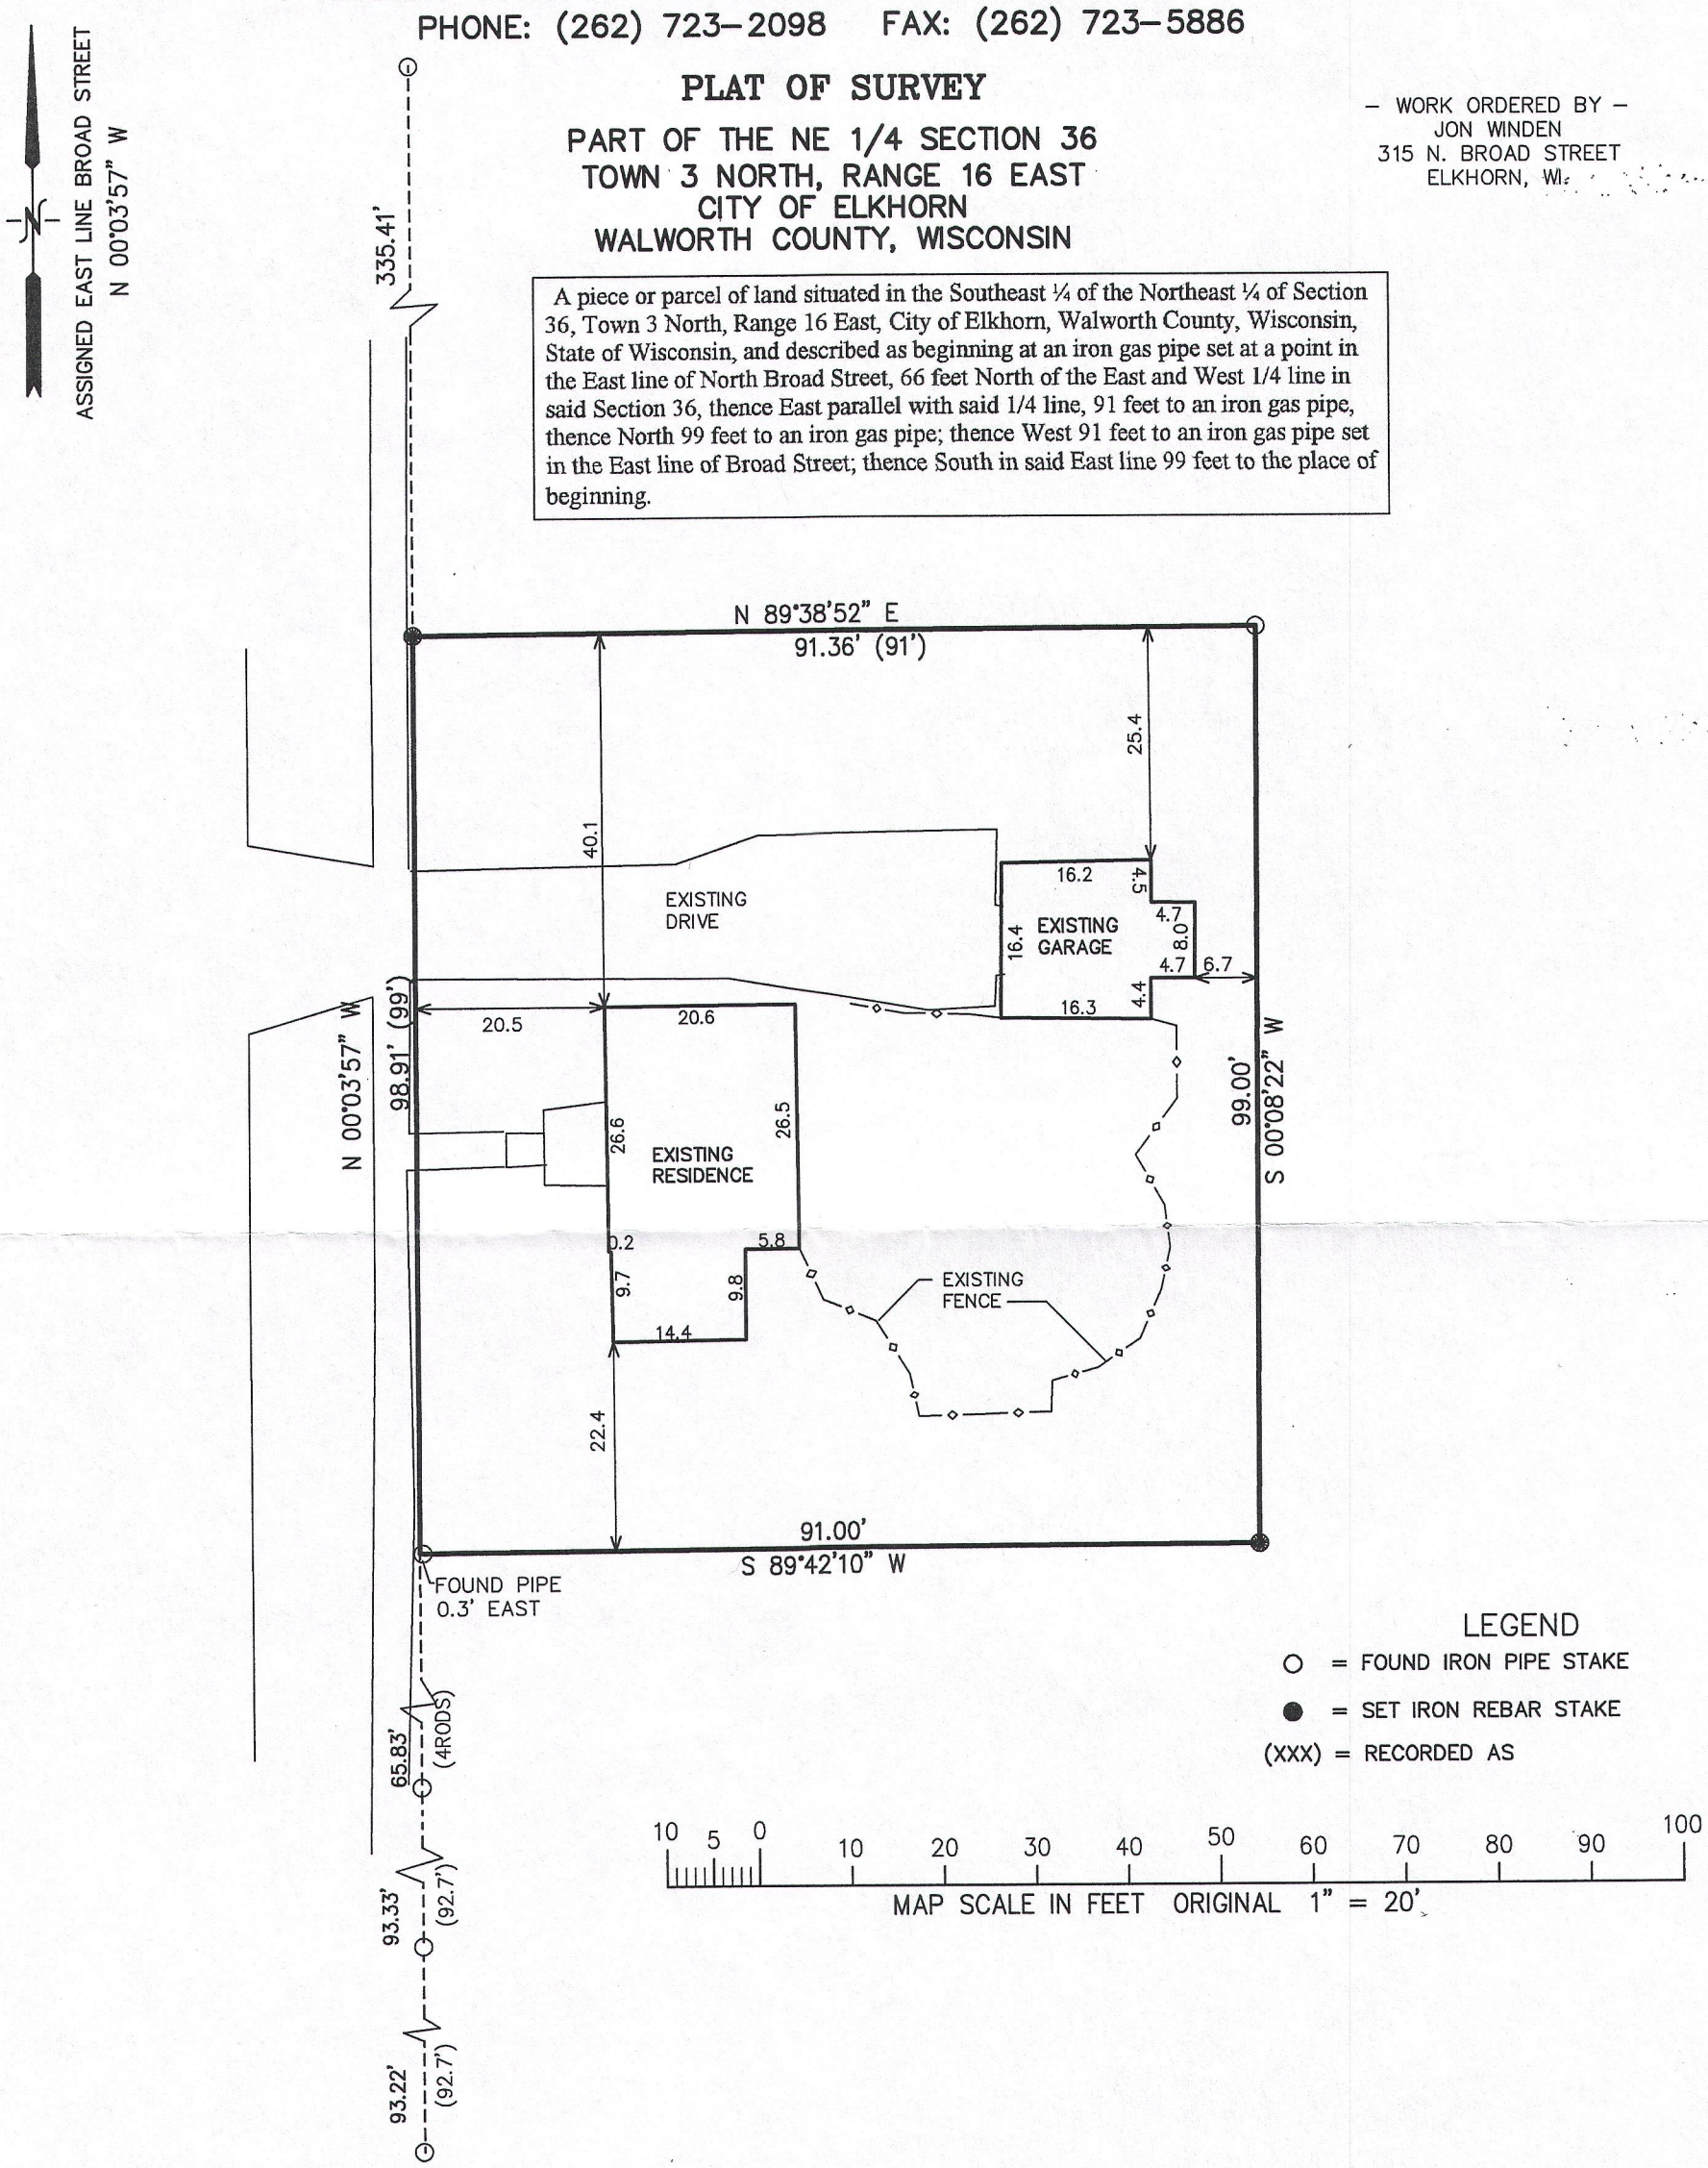

NOTE: COPIES OF THIS MAP TO WHICH THE FOLLOWING CERTIFICATE WILL APPLY SHOW THE SURVEYOR'S ORIGINAL SEAL AND SIGNATURE IN RED INK. COPIES BY ANY OTHER MEANS MAY HAVE ALTERATIONS WHICH DO NOT REPRESENT THE SURVEYOR'S WORK PRODUCT.

I HEREBY CERTIFY THAT THE ABOVE DESCRIBED PROPERTY HAS BEEN SURVEYED UNDER MY DIRECTION AND THAT THE ABOVE MAP IS A TRUE REPRESENTATION THEREOF AND SHOWS THE SIZE AND LOCATION OF THE PROPERTY AND ITS EXTERIOR BOUNDARIES. THIS SURVEY IS MADE FOR THE USE OF THE PRESENT OWNERS OF THE PROPERTY, AND ALSO THOSE WHO PURCHASE, MORTGAGE, OR GUARANTEE THE TITLE THERETO WITHIN ONE YEAR FROM THE DATE HEREOF.

DATED: SEPTEMBER 15, 2015

PETER S. GORDON P.L.S. 2101

WISCONSIN
PETER S. GORDON S-2101 ELKHORN, WI
LAND SURVEYOR

RECEIVED
DEC 9 2015
By

PROJECT: 9352
DATE: 09–15–2015
SHEET 1 OF 1

9/15/2015 X:\Projects\9352\DCAD\SURVEY