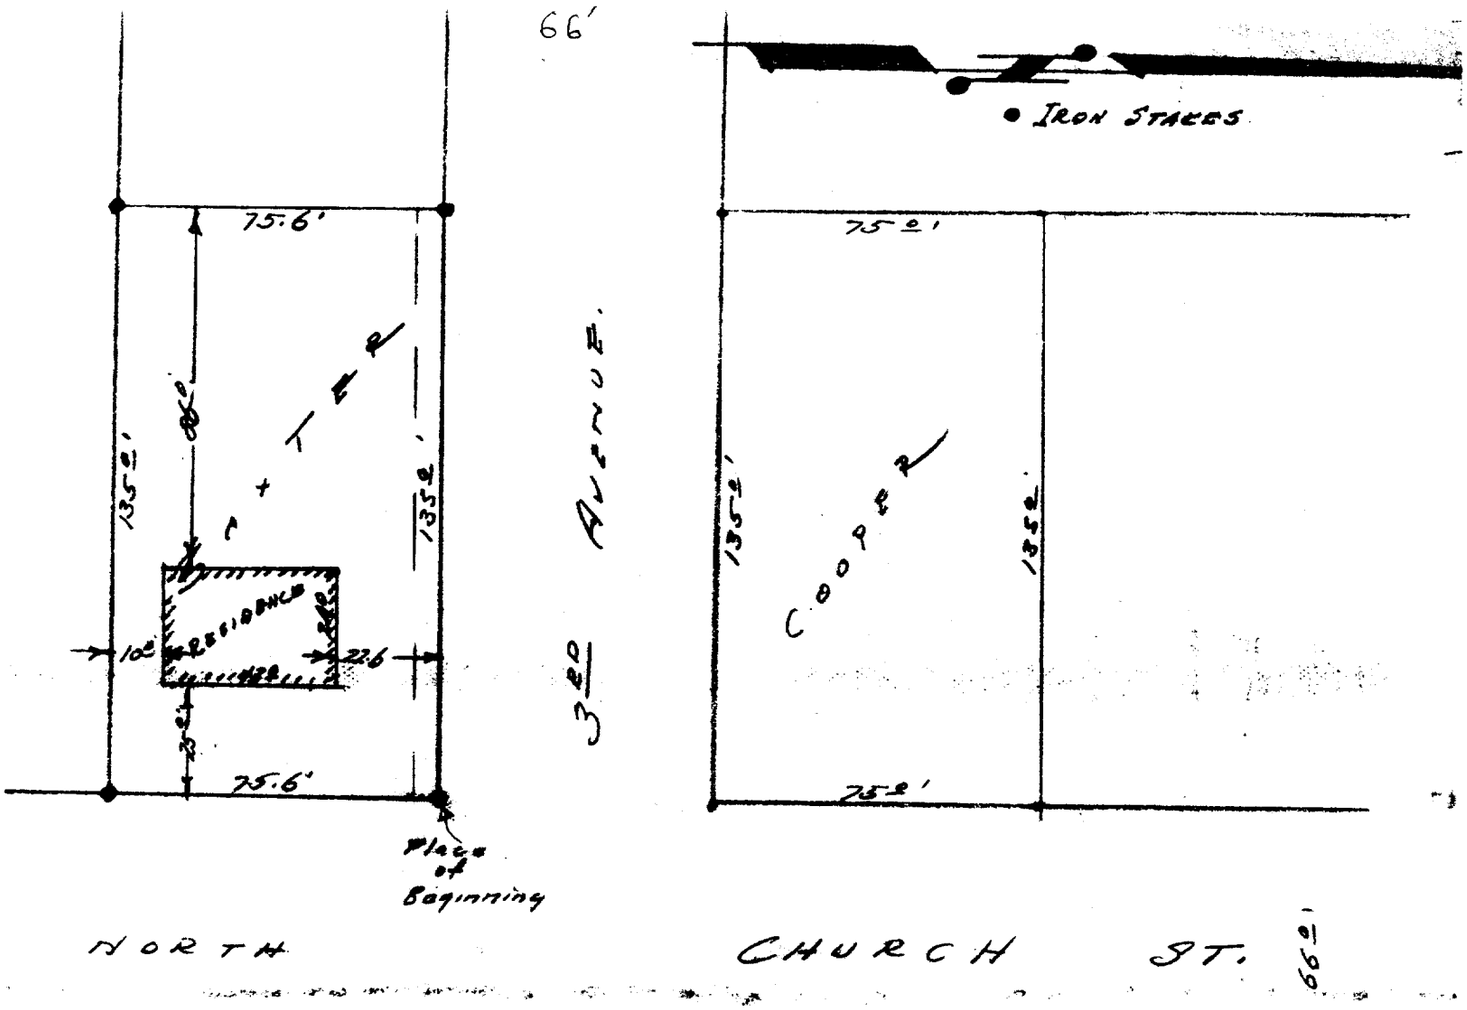


DESCRIPTION:

Commencing at an iron stake in the west line of North Church Street of the City of Elkhorn, Walworth County, Wisconsin, that is 454.14 feet north of the intersection of the north line of Second Avenue and the west line of North Church Street of said city, thence South 75.6 feet to an iron stake, thence West 135.0 feet to an iron stake thence North 75.6 feet to an iron stake, thence East 135.0 feet to the place of beginning.

CERTICIGATE:

I hereby certify that I have on this the 7th day of March 1957, surveyed the above described property according to the official records on file in the office of the Recorder of Deeds inand for Walworth County, Wisconsin, and find that no encroachments exist.

SIGNED AND SEALED ON THIS THE 7th DAY OF MARCH 1957.

Joseph M. Biagi, P.E.
Elkhorn Wisconsin

U-NW 32 & UNW-34

4-249-B