
Dick Johnson

60-33

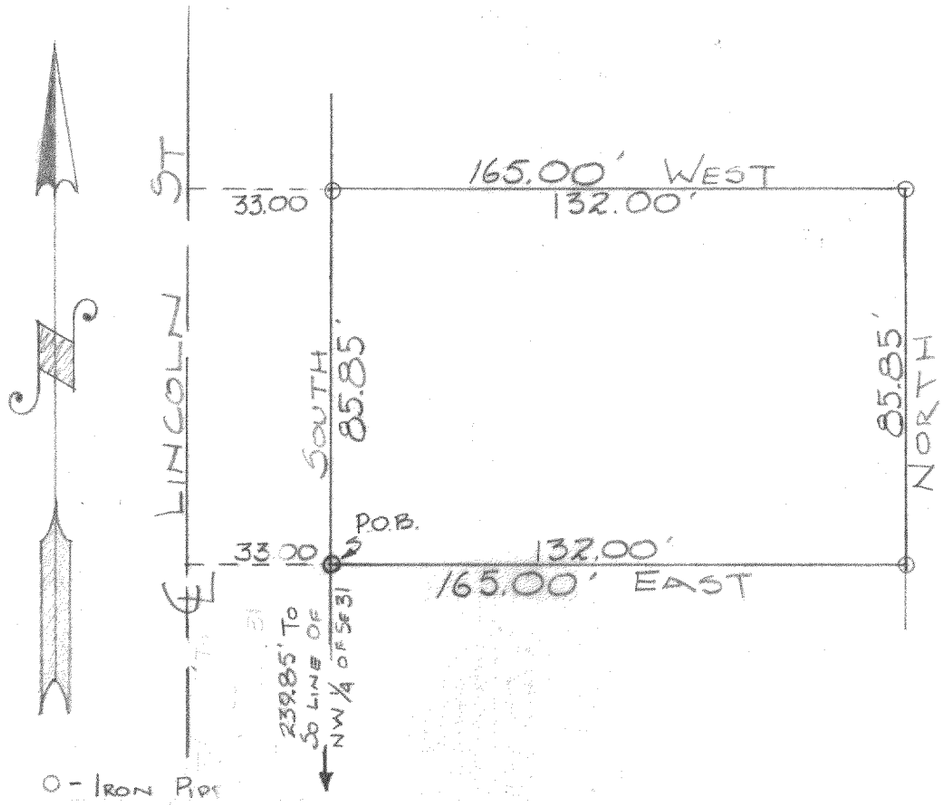

DESCRIPTION: Commencing at an iron stake in the east line of Lincoln Street, that is 239.85 feet north of the intersection of said east line and the south line of the N. W. ¼ of Section 31, Town 3 North, Range 17 East in the City of Elkhorn, Walworth County, Wisconsin; thence east 132.00 feet to an iron stake, thence north 85.85 feet to an iron stake, thence west 132.00 feet to an iron stake, thence south 85.85 feet to the P.O.B.

CERTIFICATE: I, James F. Biagi, surveyor do hereby certify that I have surveyed the property hereon described and that the drawing shown above is a correct representation of said survey.

SIGNED AND SEALED THIS 6TH DAY OF APRIL 1960

WISCONSIN JAMES F. BIAGI MILWAUKEE, WIS. LAND SURVEYOR

James F. Biagi RLS 272

UNE - 71

4-254B