


- OF -

COMMENCING AT A POINT IN THE CENTERLINE OF SECTION 36, TOWN 3 NORTH, RANGE 16 EAST OF THE FOURTH PRINCIPAL MERIDIAN, CITY OF ELKHORN, WALWORTH COUNTY, WISCONSIN, THAT 8,000.19 FEET SOUTH OF THE NORTH CORNER SAID SECTION 36, THENCE SOUTH IN THE CENTERLINE OF SAID SECTION 880.00 FEET TO A POINT; THENCE WEST 1000.00 FEET TO A POINT; THENCE NORTH 880.20 FEET TO A POINT; THENCE EAST 1000.00 FEET TO THE POINT OF BEGINNING, CONTAINING 20.2 ACRES, MORE OR LESS, IT BEING UNDERSTOOD THAT THE SOUTHERLY LINE OF THE DESCRIBED PARCEL SHALL LIE IN THE NORTHERLY LINE OF SECOND AVENUE, EXTENDED DUE WEST.

PREPARED FOR : ST. PATRICK'S CONGREGATION
107 W. WALWORTH ST.
ELKHORN, WI. 53121

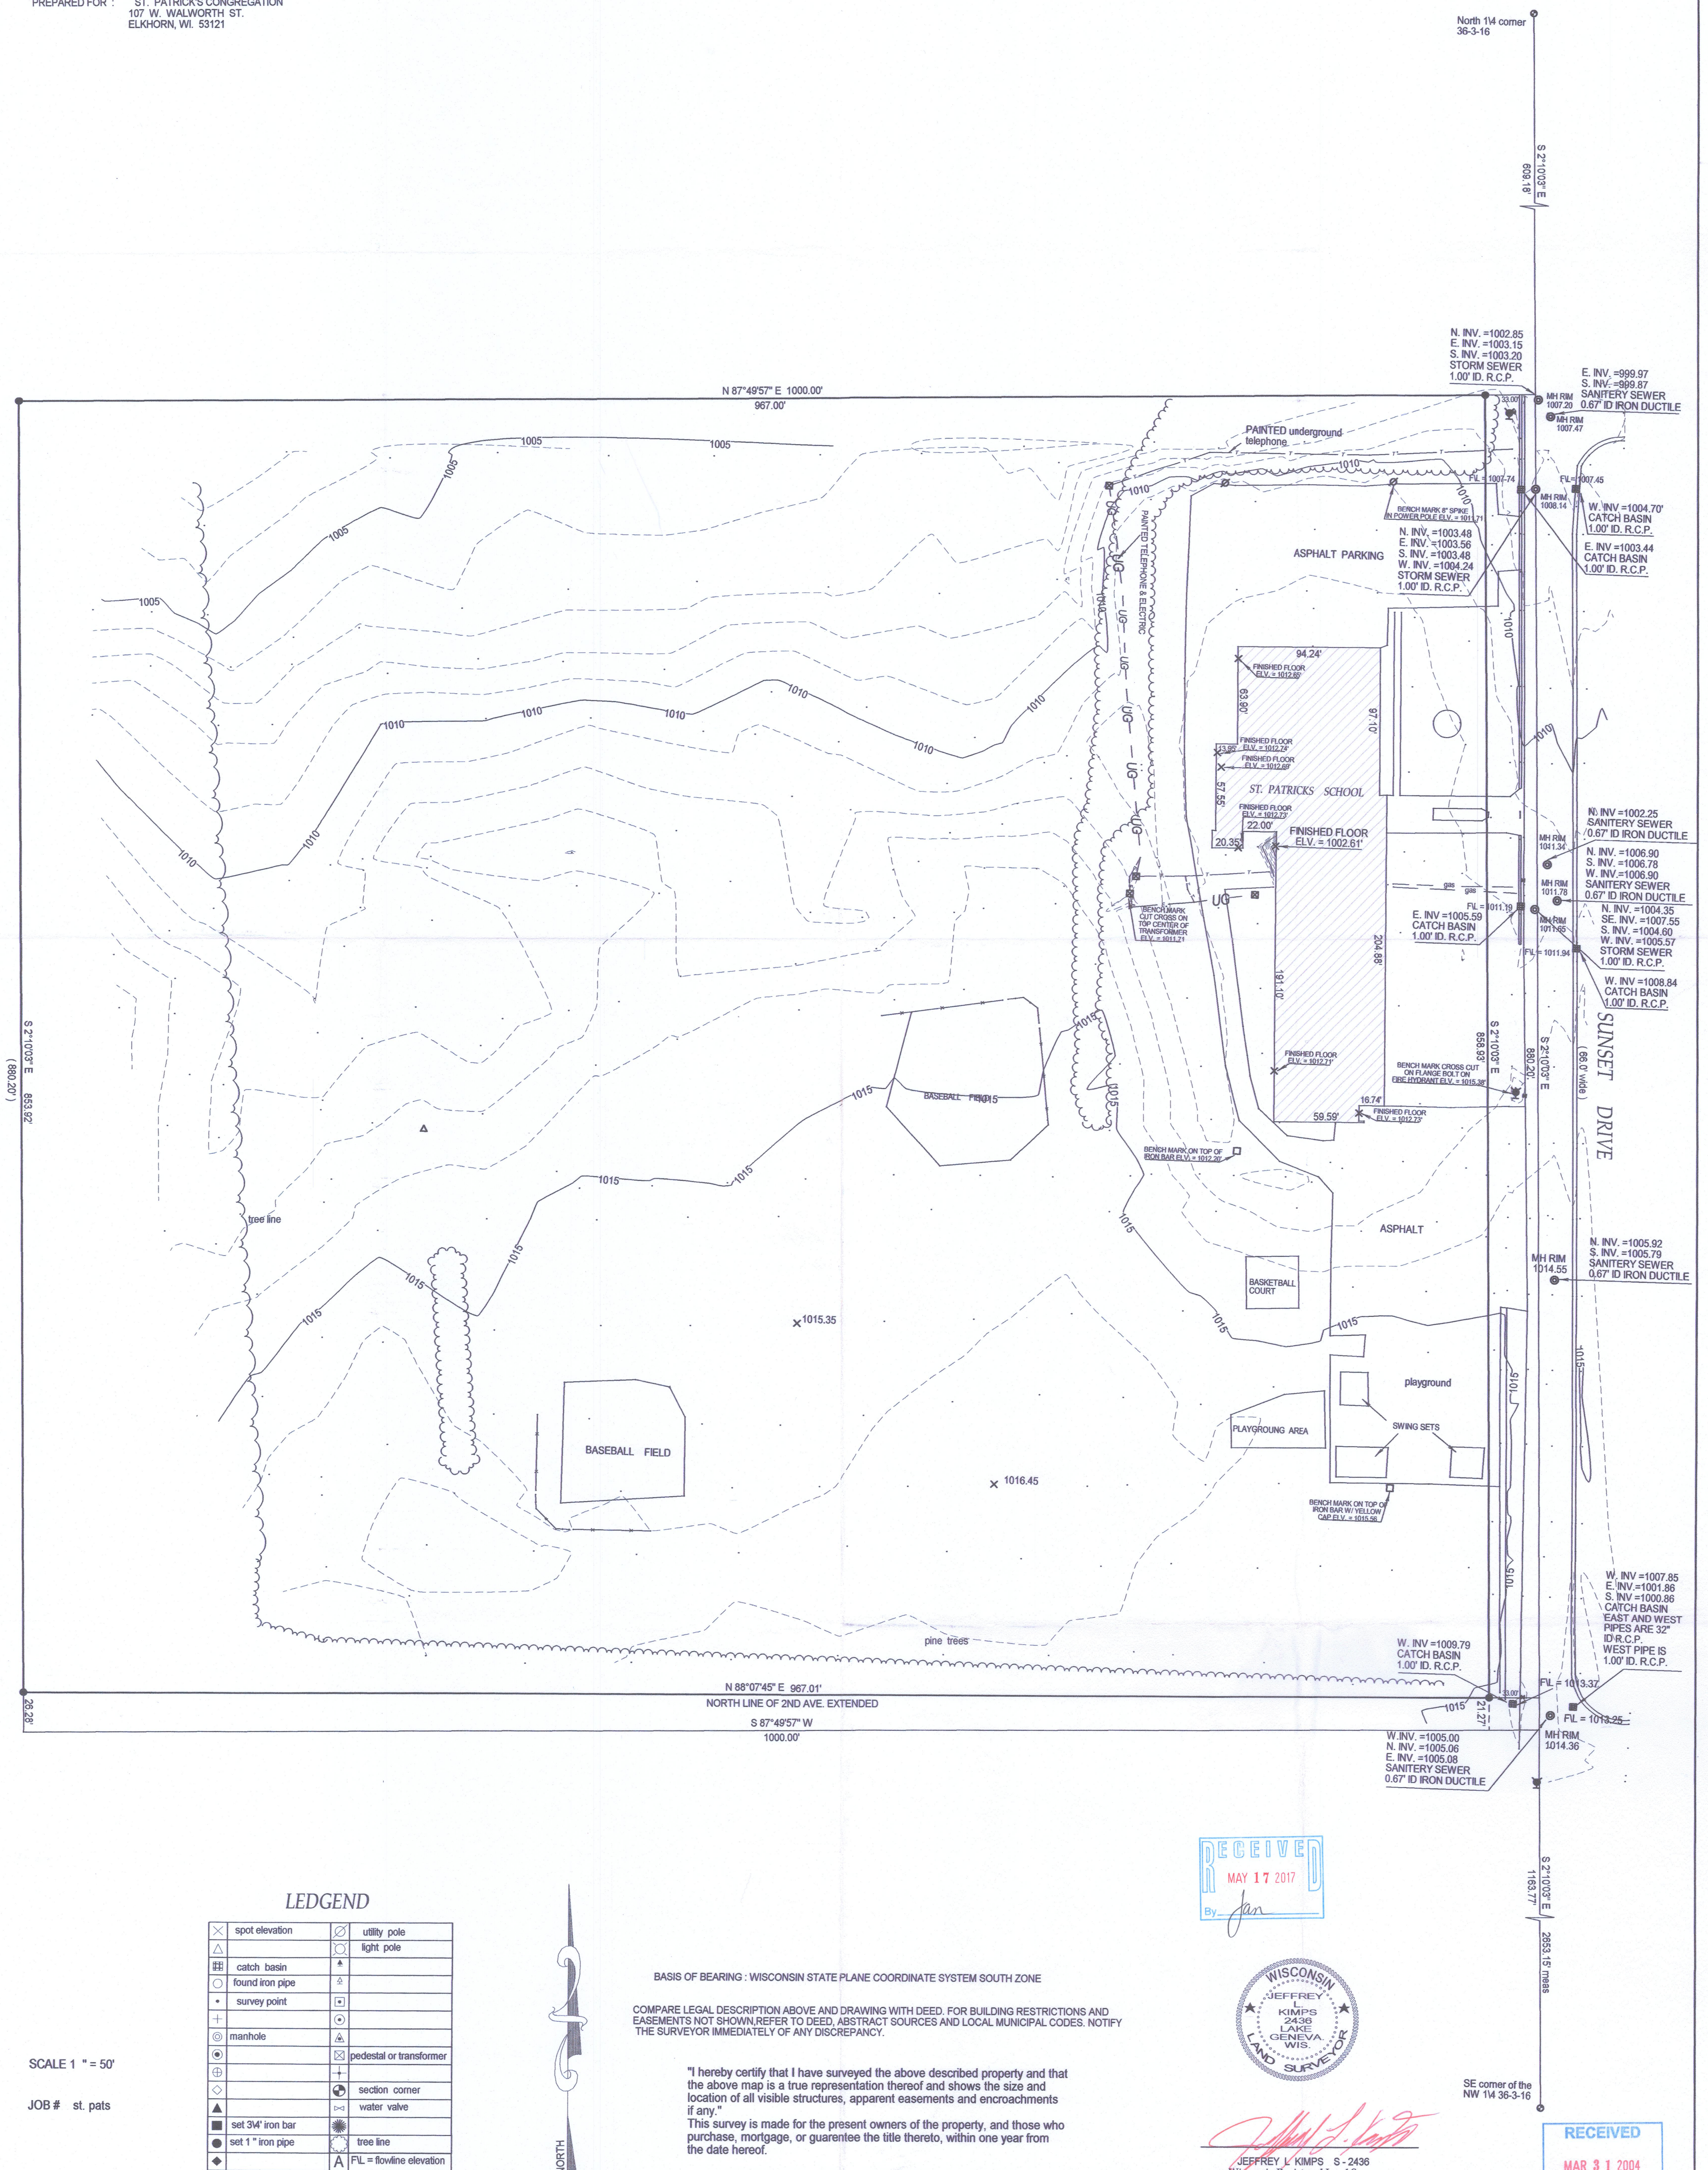

JOB # st. pats

COMPARE LEGAL DESCRIPTION ABOVE AND DRAWING WITH DEED. FOR BUILDING RESTRICTIONS AND EASEMENTS NOT SHOWN, REFER TO DEED, ABSTRACT SOURCES AND LOCAL MUNICIPAL CODES. NOTIFY THE SURVEYOR IMMEDIATELY OF ANY DISCREPANCY.


"I hereby certify that I have surveyed the above described property and that the above map is a true representation thereof and shows the size and location of all visible structures, apparent easements and encroachments if any."

This survey is made for the present owners of the property, and those who purchase, mortgage, or guarantee the title thereto, within one year from the date hereof.

DATED THIS 16 TH, DAY OF NOVEMBER, 2000.

Yu NW-43

RECEIVED
MAY 17 2017
By *Jan*

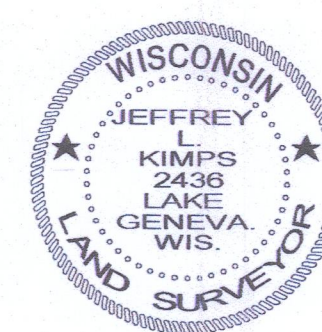

JEFFREY L KIMPS S - 2436
Wisconsin Registered Land Surveyor
(original if signed in red)
DATE OF LAST REVISION 12-27-02

004-2588

RECEIVED
MAR 31 2004
PZA CONSULTANTS, LLC

PC 2003.016
HAND DELIVERED
DAVE ROONES