

Street.

Lincoln

North


(421 North Lincoln Street)

264.00 feet to the NW $\frac{1}{4}$ of the
NW $\frac{1}{4}$ of Section 31 Town 3 north,
Range 17 east, City of Elkhorn
Walworth County.



Legend:

o Iron pipe

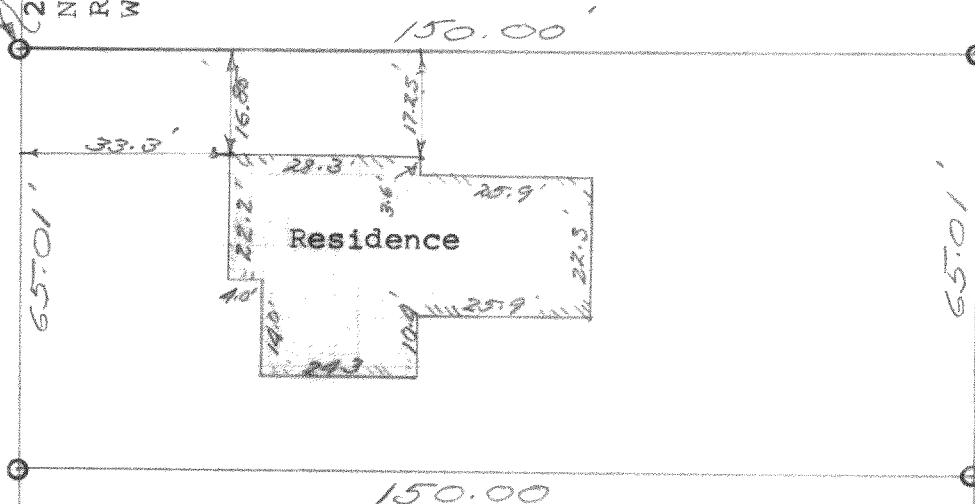

DESCRIPTION: Beginning at a point on the east line of North Lincoln Street (formerly East Street) in the City of Elkhorn Walworth County, Wisconsin, which point is 329.01 feet South of the South line of the NW $\frac{1}{4}$ of the NW $\frac{1}{4}$ of Section 31 Town 3 north, Range 17 east; thence East 150.00 feet; thence North parallel with the East line of North Lincoln Street 65.01 feet thence West 150.00 feet to the East line of North Lincoln Street, thence South along the east line of North Lincoln Street to the place of beginning.

CERTIFICATE:

I, Joseph M. Biagi, Surveyor, do hereby certify
that I have surveyed the lands hereon described

Date March 11 1974.

Joseph M. Biagi
Joseph M. Biagi RLS #12
Elkhorn, Wisconsin.