


Plat of Survey

of

Lot 1 in Block 45 of Davis Addition, EXCEPTING the South 5.48 feet thereof,

located in the Northeast 1/4 of the Northeast 1/4 of Section 36, Town 3
North, Range 16 East, City of Elkhorn, Walworth County, Wisconsin.

Surveyed for: **Nicole Hill**
518 North Wisconsin Street
Elkhorn, Wisconsin. 53121

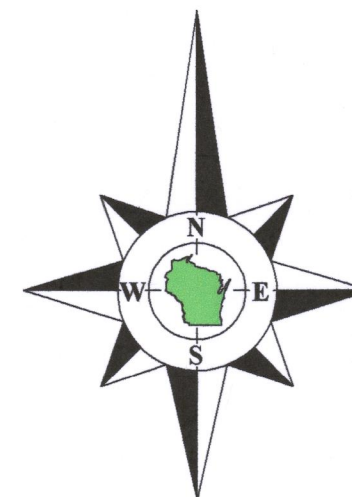

Bearings referenced to the East line of the Northeast 1/4 of Section 36-3-16,
recorded as N1°29'42"W in the Wisconsin State Plane Coordinate System,
South Zone, (NAD-27).

Coordinates are referenced to the Wisconsin State
Plane Coordinate System, South Zone, (NAD-27).

**Northeast Corner
Section 36-3-16**
N. 252,896.86
E. 2,392,185.68

Survey Date: June 8, 2017.

Revisions:

Scale in Feet
1" = 20'



45 South Wisconsin Street | P.O. Box 322
Elkhorn, Wisconsin. 53121
Telephone: (262) 723-3434
Facsimile: (262) 723-8044
Email: doug@olsonsurveying.com
Website: www.olsonsurveying.com


OLSON
LAND SURVEYING, LLC
Rural | Residential | Commercial

Legend of Symbols & Abbreviations
North Arrow
Section Corner
Found Iron Pipe
Found Iron Rod, 1-3/16" dia.
Set Iron Pipe, 1" dia.
Set Iron Rod, 1" dia.
Utility Box
Fire Hydrant
Catch Basin
Asphalt Surface
Concrete Surface
Gravel Surface

Sheet 1 of 1 Sheets

Drawing Name
Job Reference Number
2017.051

2017.051

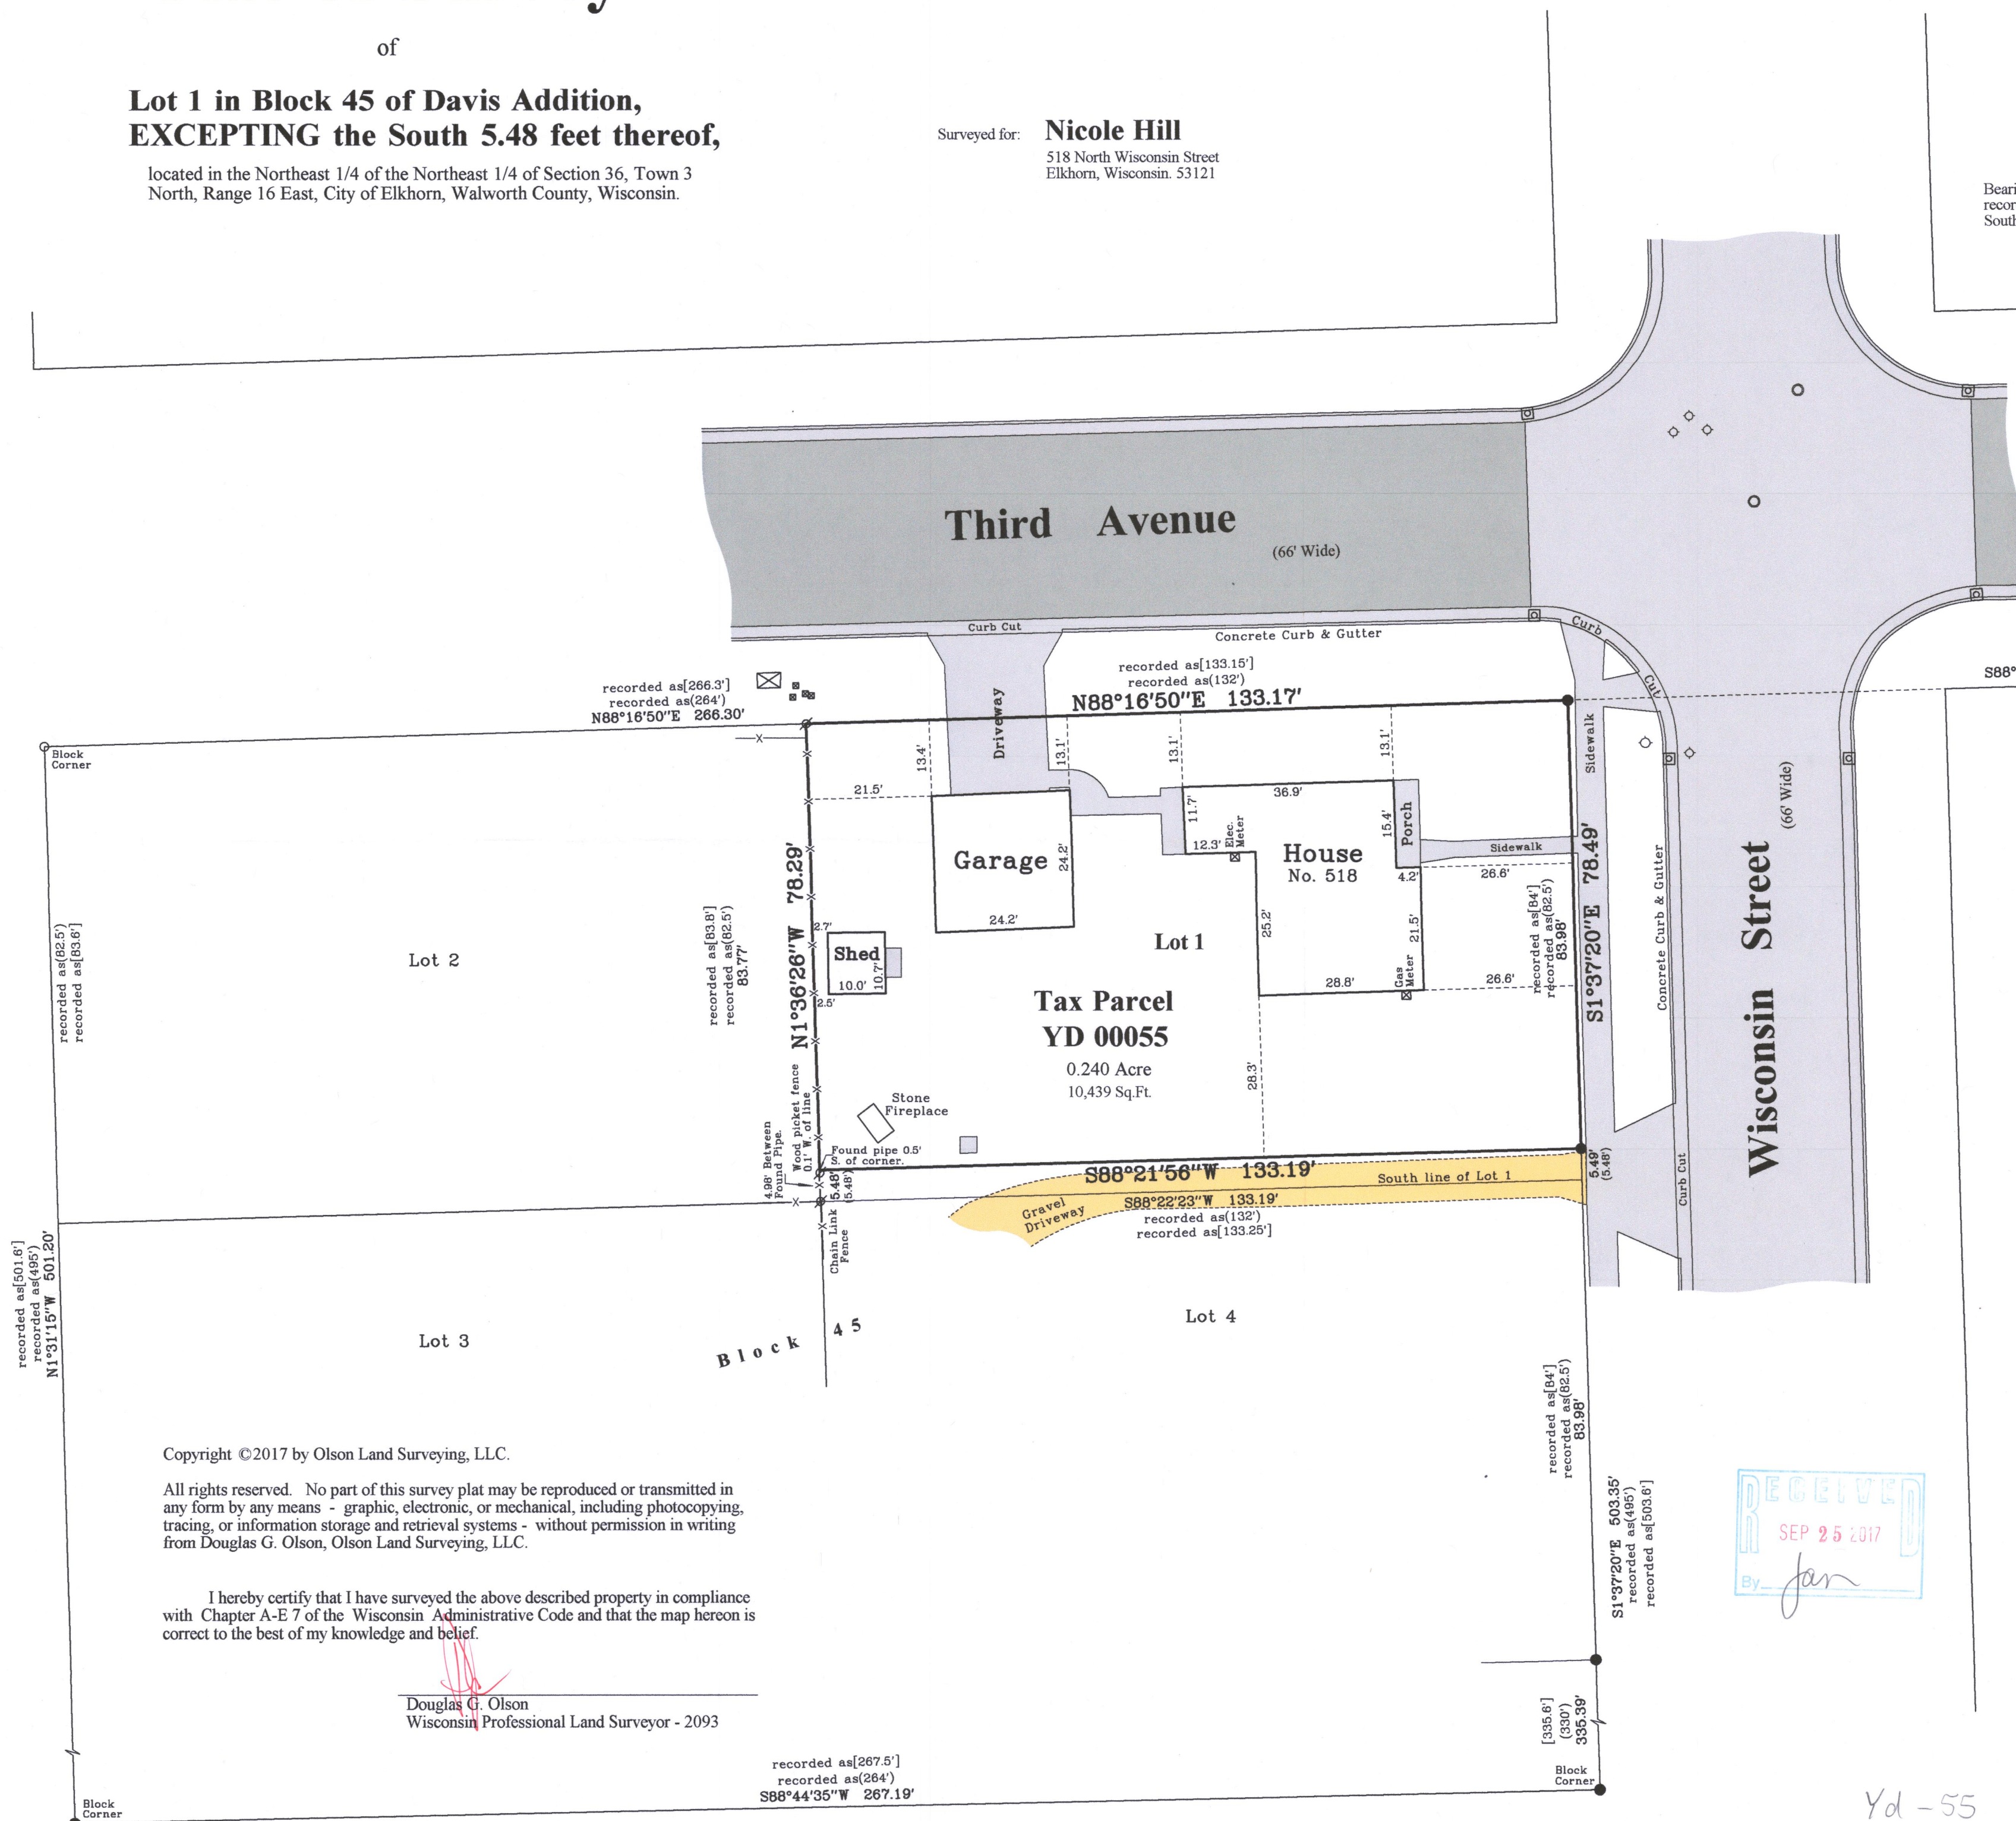

Copyright ©2017 by Olson Land Surveying, LLC.



All rights reserved. No part of this survey plat may be reproduced or transmitted in
any form by any means - graphic, electronic, or mechanical, including photocopying,
tracing, or information storage and retrieval systems - without permission in writing
from Douglas G. Olson, Olson Land Surveying, LLC.

I hereby certify that I have surveyed the above described property in compliance
with Chapter A-E 7 of the Wisconsin Administrative Code and that the map hereon is
correct to the best of my knowledge and belief.

Douglas G. Olson
Wisconsin Professional Land Surveyor - 2093

recorded as[267.5']
recorded as[264']
S88°44'35"W 267.19'

recorded as[84']
recorded as[495']
S1°37'20"E 503.35'
recorded as[503.8']

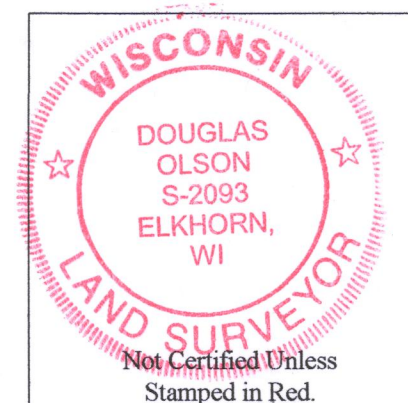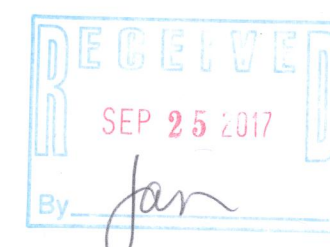

Notes:

- 1) This Plat of Survey is not certified unless signed and sealed in red ink.
- 2) This survey is subject to Wisconsin lien laws. This Plat of Survey is the notice of intent to file lien. Lien waiver required.
- 3) The Survey Date shown on this Plat of Survey is the completion date of the field work.

Yd - 55

004-2622