Plat of Survey

of


Lot 1 in Block 45 of Davis Addition,
EXCEPTING the South 5.48 feet thereof,

located in the Northeast 1/4 of the Northeast 1/4 of Section 36, Town 3 North, Range 16 East, City of Elkhorn, Walworth County, Wisconsin.

Surveyed for: **Nicole Hill**
518 North Wisconsin Street
Elkhorn, Wisconsin. 53121

Bearings referenced to the East line of the Northeast 1/4 of Section 36-3-16, recorded as N1°29'42"W in the Wisconsin State Plane Coordinate System, South Zone, (NAD-27).

Coordinates are referenced to the Wisconsin State Plane Coordinate System, South Zone, (NAD-27).

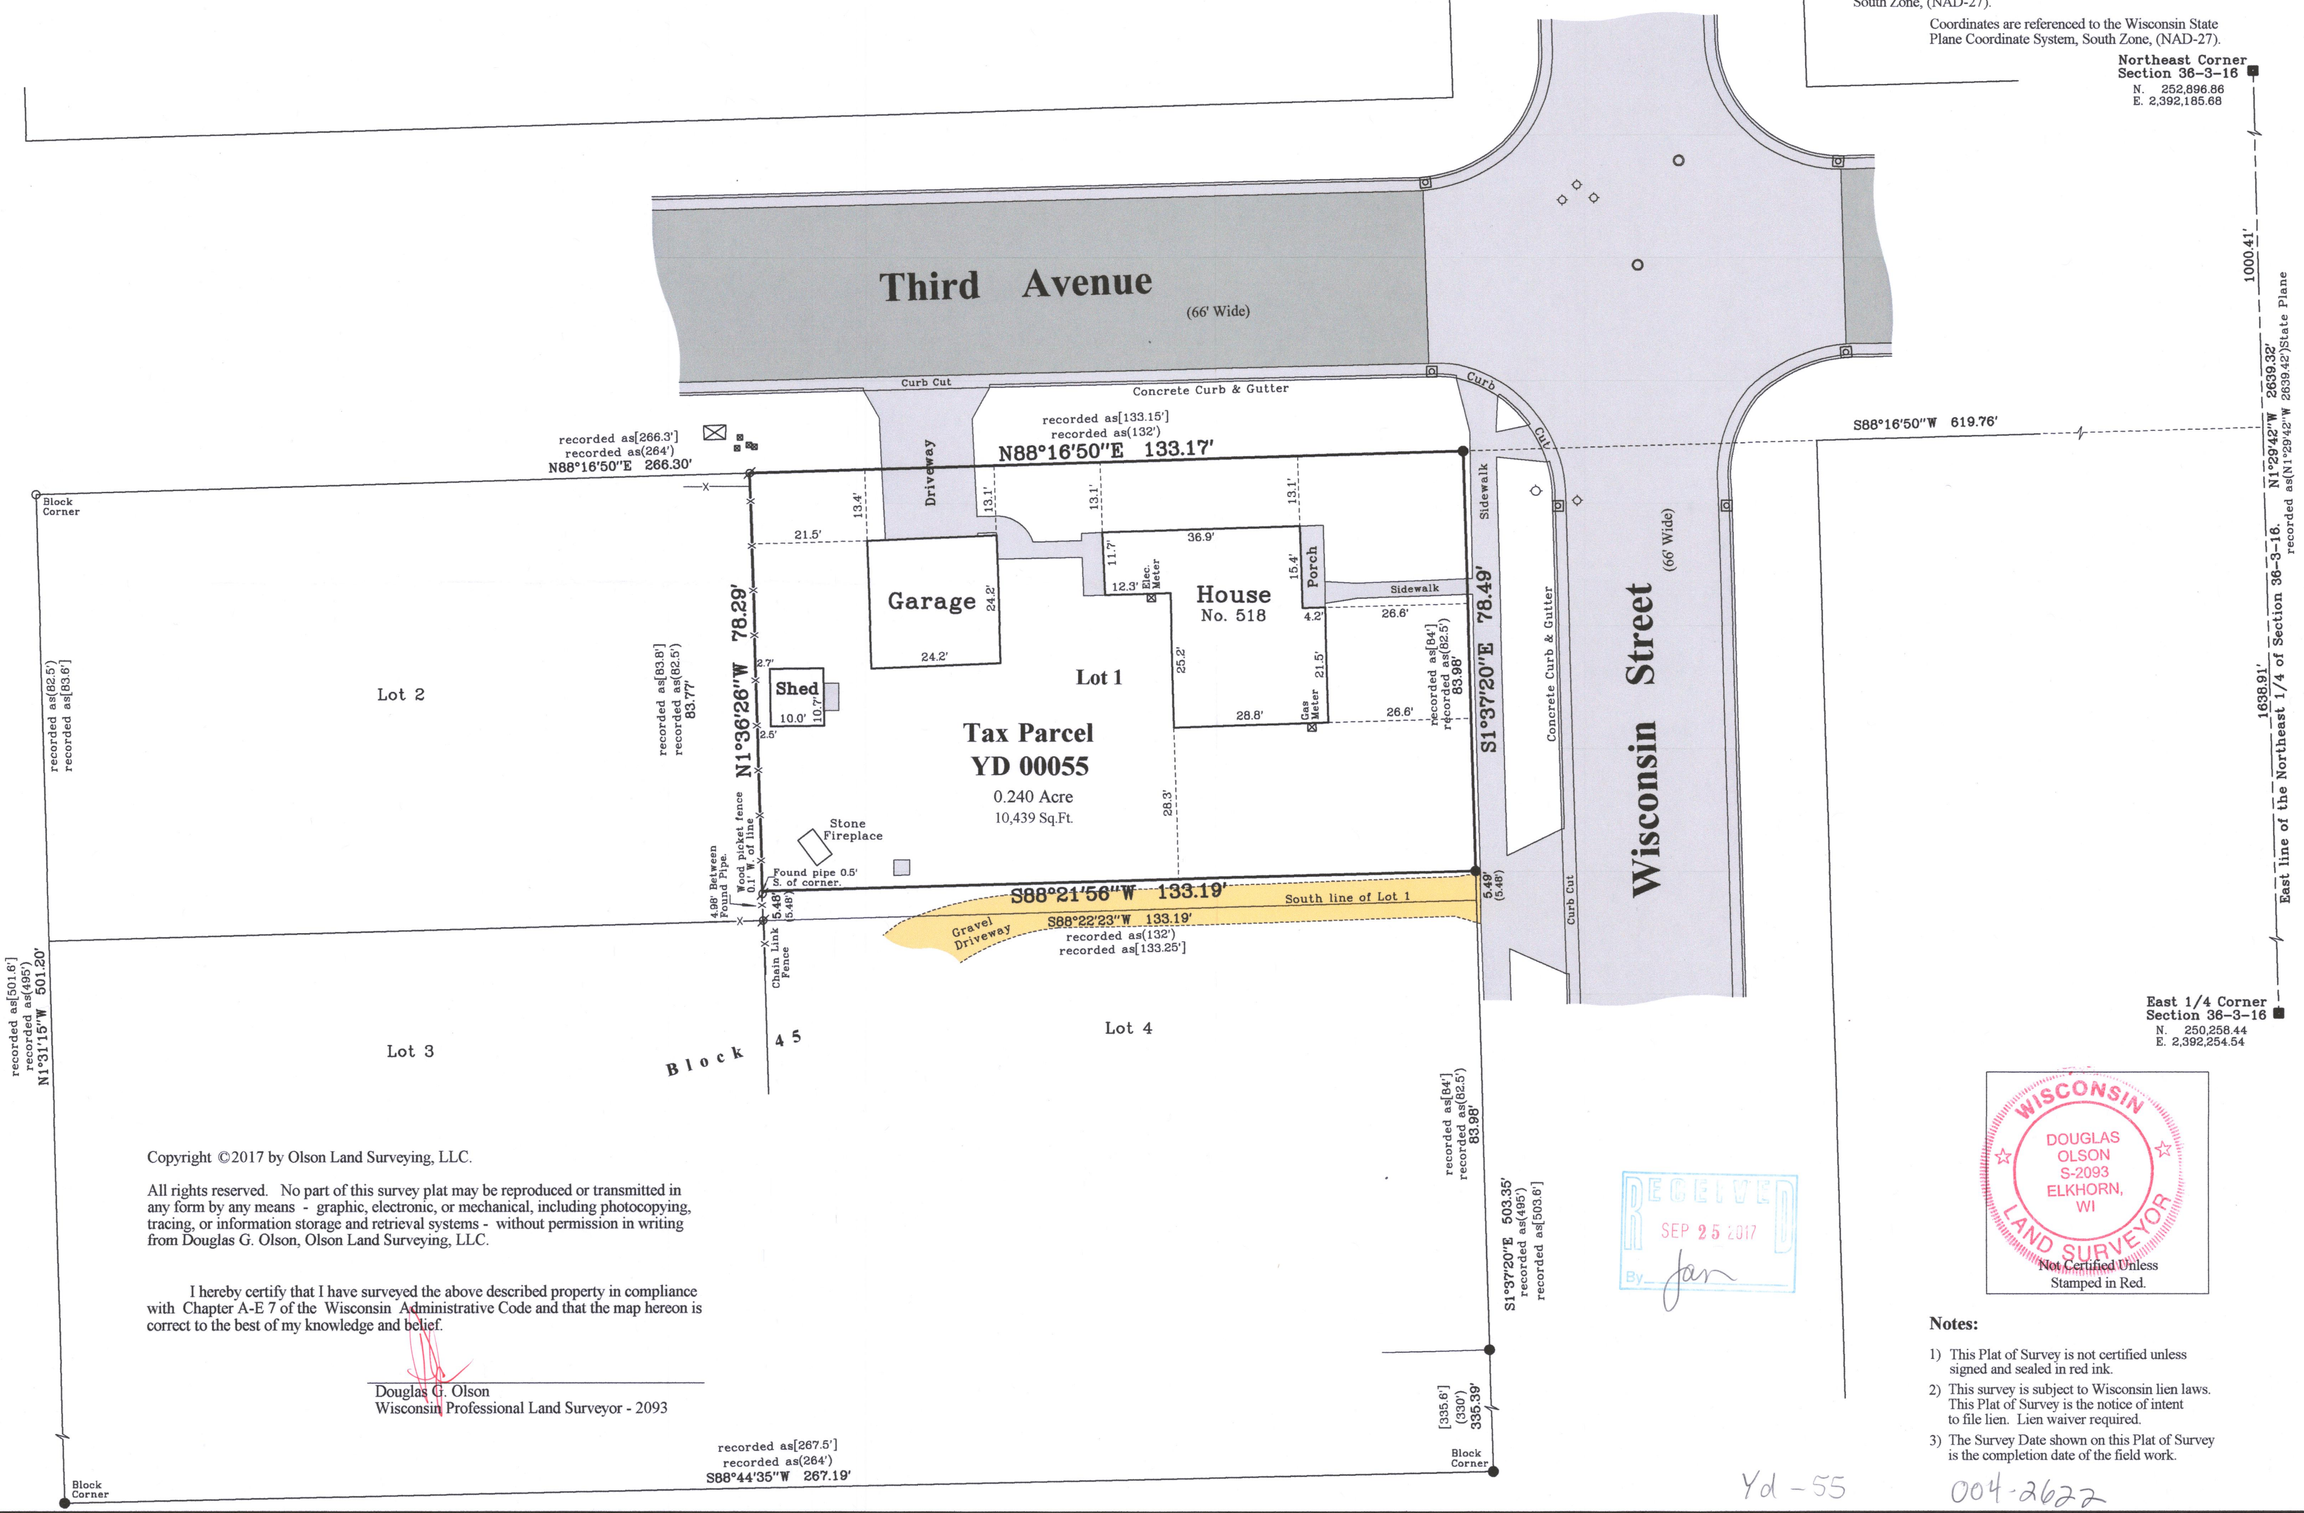

Copyright ©2017 by Olson Land Surveying, LLC.

All rights reserved. No part of this survey plat may be reproduced or transmitted in any form by any means - graphic, electronic, or mechanical, including photocopying, tracing, or information storage and retrieval systems - without permission in writing from Douglas G. Olson, Olson Land Surveying, LLC.

I hereby certify that I have surveyed the above described property in compliance with Chapter A-E 7 of the Wisconsin Administrative Code and that the map hereon is correct to the best of my knowledge and belief.

Douglas G. Olson
Wisconsin Professional Land Surveyor - 2093

RECEIVED
SEP 25 2017
By: Jan

WISCONSIN
DOUGLAS OLSON S-2093 ELKHORN, WI
LAND SURVEYOR
Not Certified Unless Stamped in Red.

Notes:

1) This Plat of Survey is not certified unless signed and sealed in red ink.
2) This survey is subject to Wisconsin lien laws. This Plat of Survey is the notice of intent to file lien. Lien waiver required.
3) The Survey Date shown on this Plat of Survey is the completion date of the field work.

Yd - 55

004-2622

Survey Date: June 8, 2017.
Revisions:

Scale in Feet
1" = 20'
0' 10' 20' 40' 60'

OLSON
LAND SURVEYING, LLC
Rural | Residential | Commercial
45 South Wisconsin Street | P.O. Box 322
Elkhorn, Wisconsin. 53121
Telephone: (262) 723-3434
Facsimile: (262) 723-8044
Email: doug@olsonsurveying.com
Website: www.olsonsurveying.com

Legend of Symbols & Abbreviations

Found County Section Corner
Found Iron Pipe
Found Iron Rod, 1-3/16" dia.
Recorded Information
Utility Box or Pedestal
Fire Hydrant
Catch Basin
Asphalt Surface
Concrete Surface
Manhole
Water Valve
Gravel Surface

N North
S South
E East
W West
In Bearings
° Degrees
' Minutes
" Seconds
In Distances
' Feet
" Inches

Sheet 1 of 1 Sheets

Drawing Name:

Job Reference Number
2017.051

2017.051