
PLAT OF SURVEY

FOUNDATION AS-BUILT

BEING ALL OF LOT 62 OF HARVEST POINTE SOUTH SUBDIVISION, LOCATED IN THE SOUTHWEST ¼ OF THE SOUTHWEST ¼ OF SECTION 30, TOWNSHIP 3 NORTH, RANGE 17 EAST, CITY OF ELKHORN, WALWORTH COUNTY, WISCONSIN.

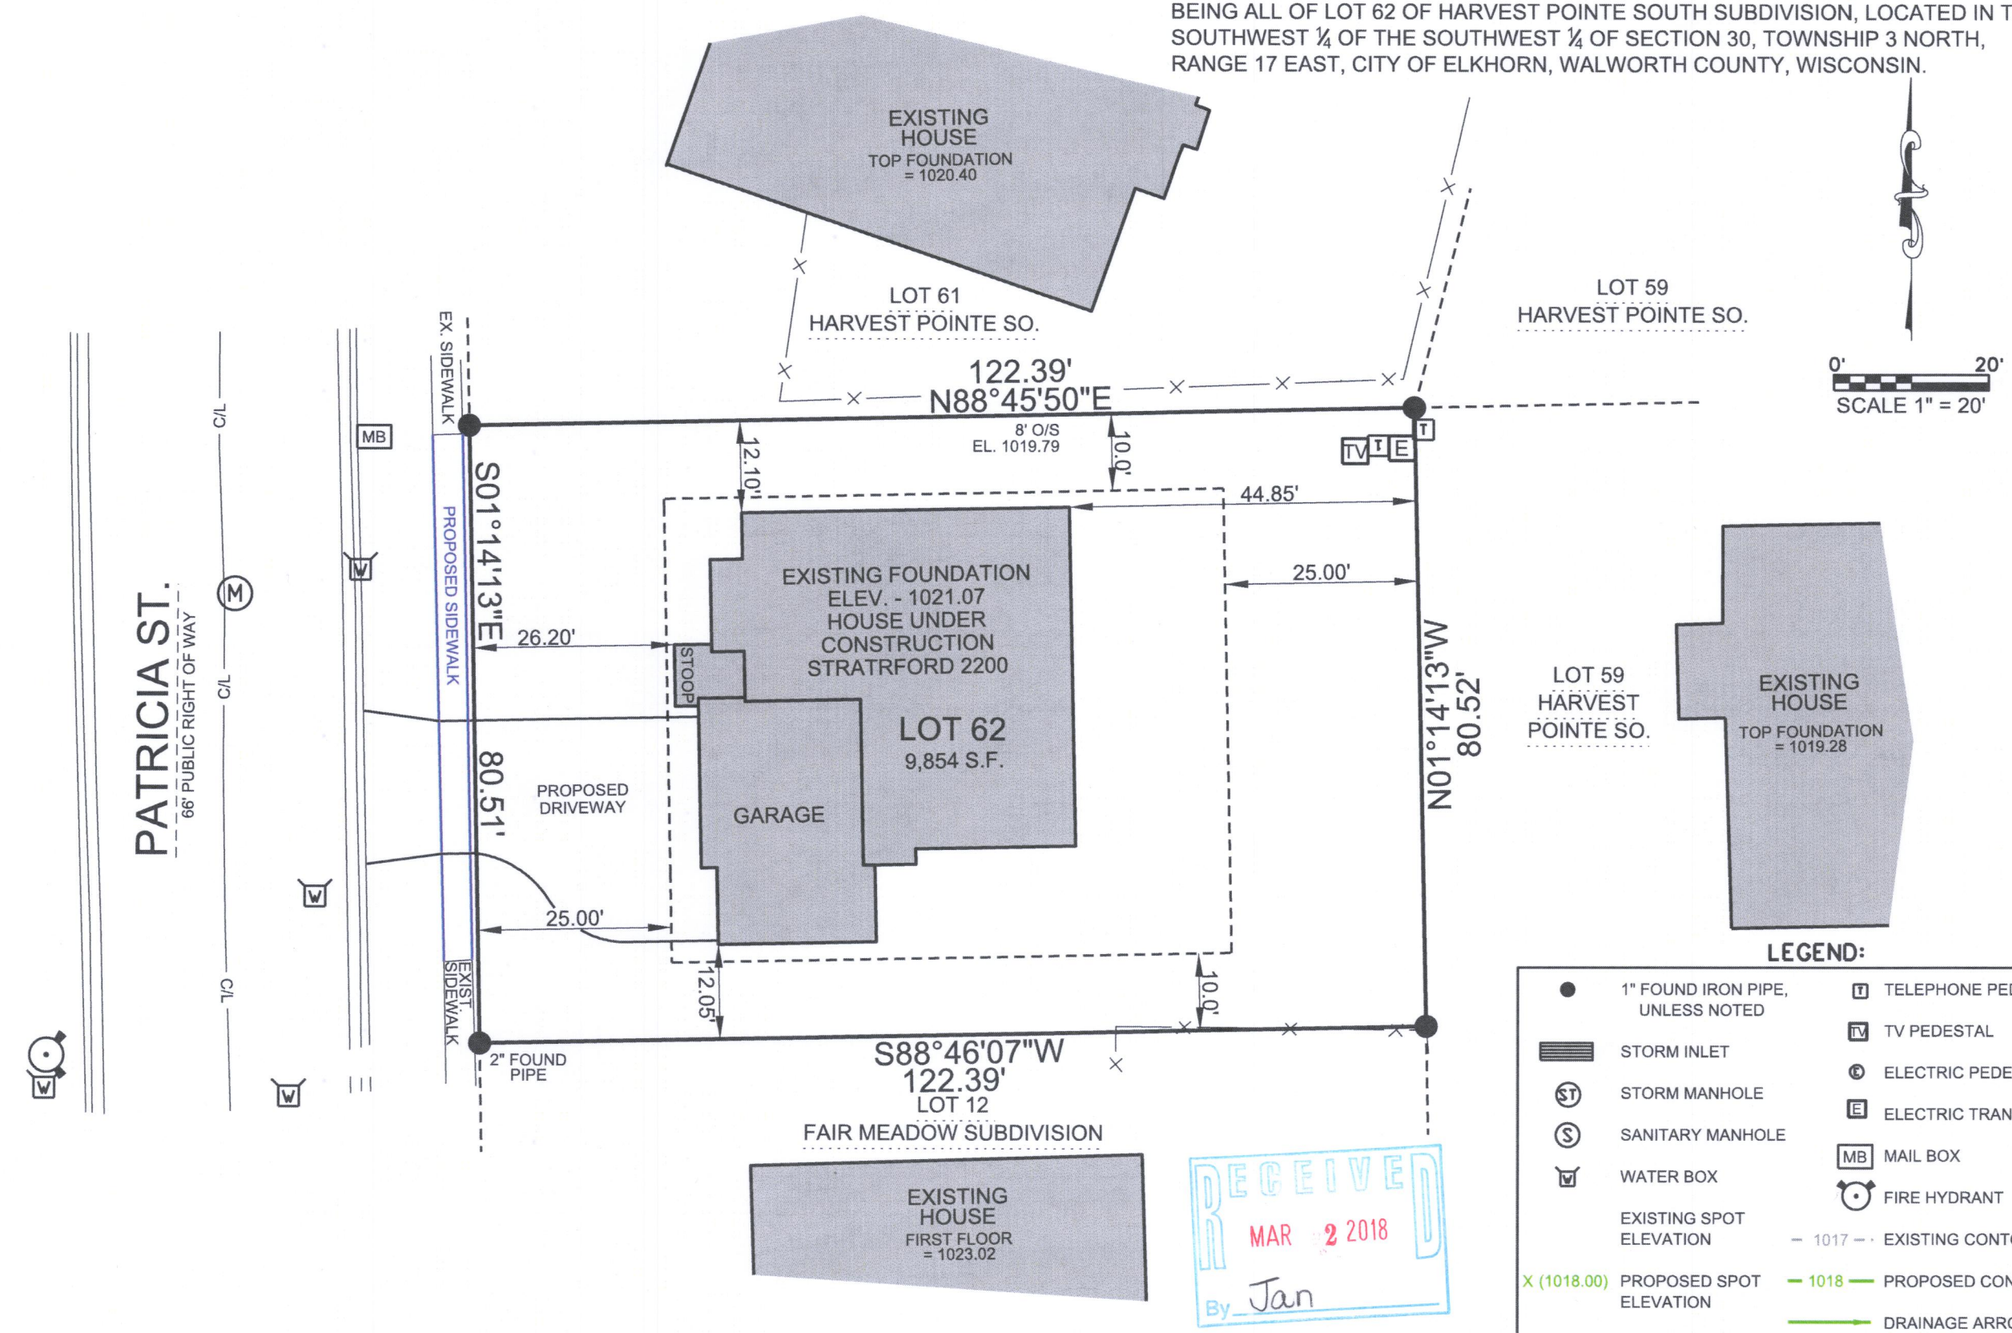

RECEIVED
MAR 2 2018
By Jan

LEGEND:

1" FOUND IRON PIPE, UNLESS NOTED	TELEPHONE PEDESTAL
STORM INLET	TV PEDESTAL
STORM MANHOLE	ELECTRIC PEDESTAL
SANITARY MANHOLE	ELECTRIC TRANSFORMER
WATER BOX	MAIL BOX
EXISTING SPOT ELEVATION	FIRE HYDRANT
X (1018.00) PROPOSED SPOT ELEVATION	1017 EXISTING CONTOUR
EXITING TREE	1018 PROPOSED CONTOUR
	DRAINAGE ARROW
	EXISTING TREE STUMP

WISCONSIN
Michael A. Greeson
S-2770
East Troy
Wis
LAND SURVEYOR

THIS SURVEY IS MADE FOR THE USE OF THE PRESENT OWNERS OF THE PROPERTY, AND ALSO THOSE WHO PURCHASE, MORTGAGE OR GUARANTEE TITLE TO WITHIN ONE (1) YEAR FROM DATE HERETO.

I, MICHAEL A. GREESON R.L.S. X2770, HEREBY CERTIFY THAT THIS SURVEY WAS MADE IN ACCORDANCE WITH THE MINIMUM STANDARDS FOR PROPERTY SURVEYS (CHAPTER A-E 7) FOR THE STATE OF WISCONSIN AND HAS BEEN PREPARED UNDER MY DIRECTION AND CONTROL AND IS CORRECT TO THE BEST OF MY KNOWLEDGE AND BELIEF.

DATE	ITEM
04/21/2017	ORIGINAL SURVEY
05/01/2017	REV. GRADES
05/03/2017	STAKED HOUSE
09/12/2017	ASBUILT SURVEY

SURVEY FOR:
BIELINSKI HOMES, INC.
1830 MEADOW LANE
PEWAUKEE, WI 53072

V²G
SURVEYING, LLC
123 WOLF RUN - SUITE 4
MUKWONAGO, WI 53149
(262) 378-5097

FILE NAME: 2017-051 BIELINSKI HOMES HARVEST PT SOUTH LOT 62.DGN

PLOT DATE: 09/12/2017

V2G JOB # 2017-051

YHPS-62 004-2643