FARRIS, HANSEN & COOPER, INC.

ENGINEERING, SURVEYING AND LAND PLANNING

715 W. WALWORTH ST. - P.O. BOX 487 - ELKHORN, WI 53121

OFFICE: 414/723-2098

WARREN E. HANSEN
PROFESSIONAL ENGINEER

ENGINEERING
MUNICIPAL - STRUCTURAL
HIGHWAYS - PUBLIC WORKS


DANIEL D. COOPER
ROBERT A. FARRIS
LAND SURVEYOR

SURVEYING & PLANNING
SUBDIVISIONS - LOT SURVEYS
CONSTRUCTION STAKING - MAPPING

MORTGAGE INSPECTION SURVEY

GENEVA STREET

Note: This is not a "Property Survey" as defined in Chapter A-E 5.01 of the Wisconsin Administrative Code.

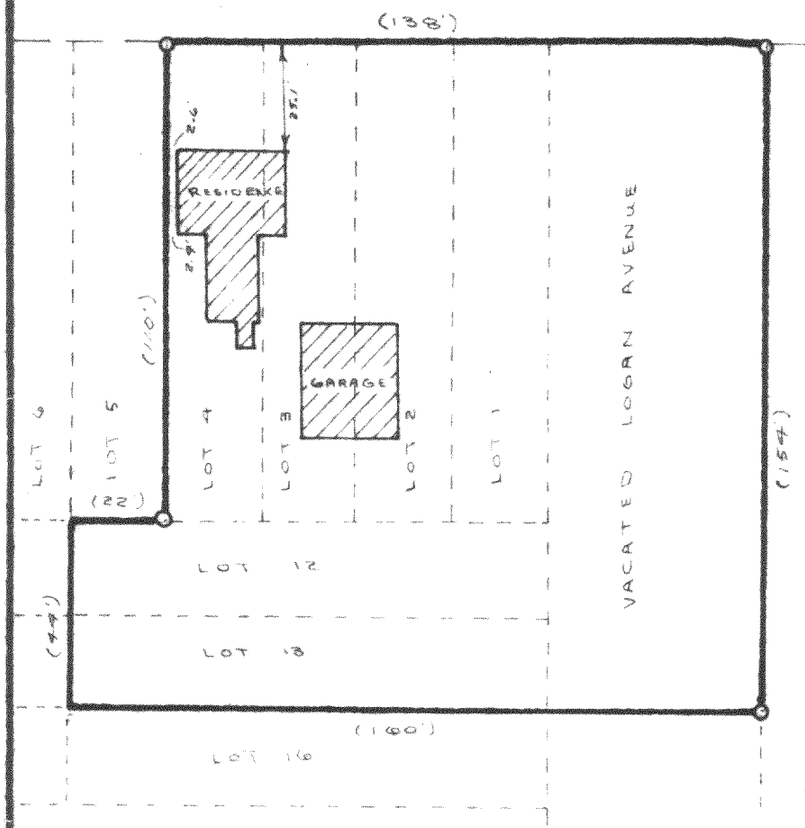

o - indicates iron pipe found
(xxx) - recorded dist.

SCALE 1" = 40'

I hereby certify that this map is a true and accurate representation of the lot lines and the buildings located thereon to the best of my knowledge and belief.

Robert A. Farris

Robert A. Farris
Surveyor No. S- 1293

Dated this 30th day of June, 1978.

WISCONSIN
ROBERT A. FARRIS
S-1293
ELKHORN, WIS.
LAND SURVEYOR

Lots 1, 2, 3, 4, 12, and 13, also the vacated 50 feet of Logan Avenue adjacent to lots 1, 12, and 13, all in Block 2, Elkhorn Garden Subdivision, City of Elkhorn, Walworth County, Wisconsin.

Buyers: Milan B. & Darlene A. Krempel
Sellers: Steven E. & Donna J. Fortney
Property: 415 West Geneva Street
Elkhorn, Wisconsin 53121

Work Ordered By: Sandra J. Butler
for Waukesha Savings
& Loan.

Drawing No. 1359

EN-5 and EN-10

4-265F