
HAROLD H. KOLB

REGISTERED PROFESSIONAL LAND SURVEYOR
LAKE GENEVA, WISCONSIN

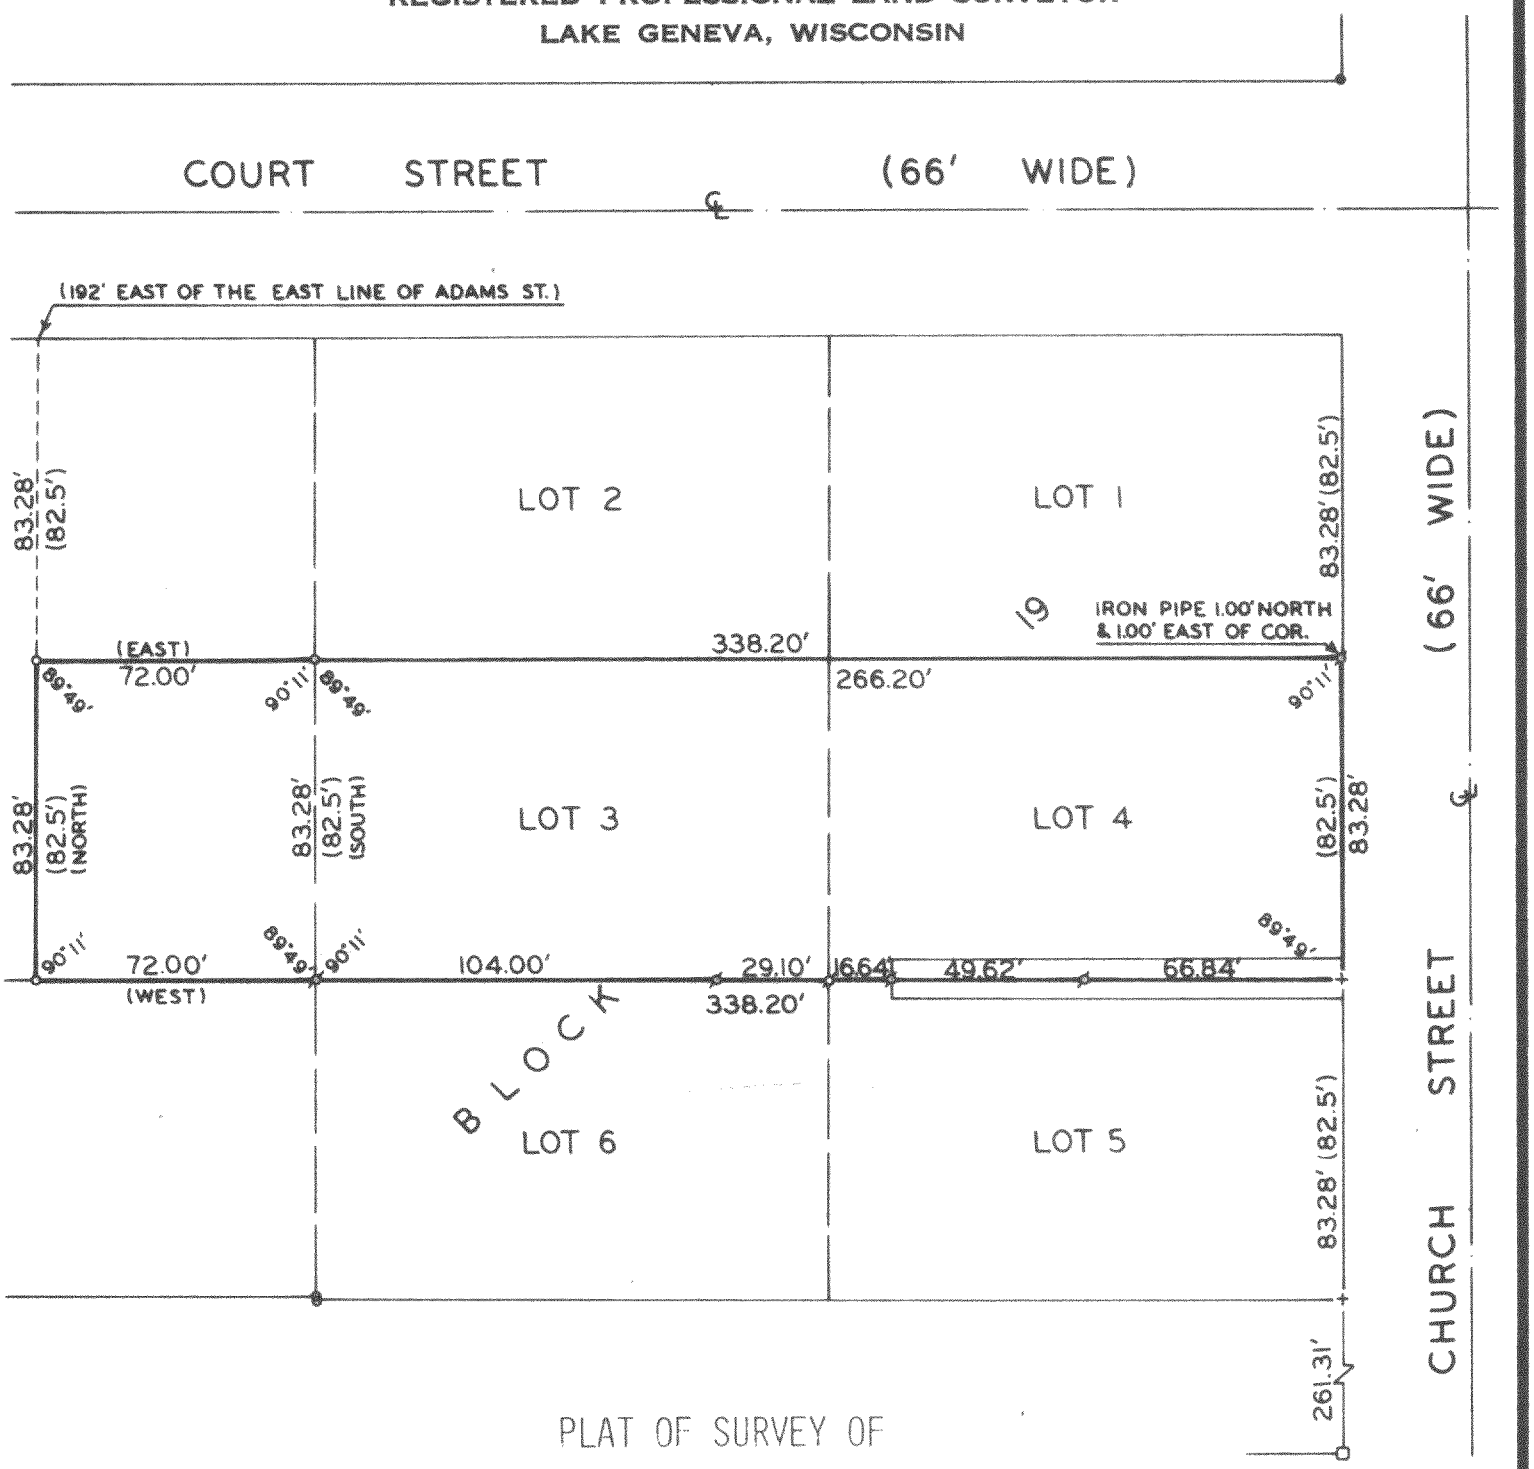

PLAT OF SURVEY OF

LOTS 3 AND 4, BLOCK 19, ORIGINAL PLAT, CITY OF ELKHORN, AND A PART OF OUTLOT 105 AS DESCRIBED IN VOLUME 193, PAGE 568 OF RECORDS, WALWORTH COUNTY, WISCONSIN.

NOTE: SURVEY BASED ON RESURVEY OF ORIGINAL PLAT BY MR. TUBBS, CITY ENGINEER.

ORDERED BY: JOHN T. HUML & LAVERNE E. TWIST
736 MAIN STREET
LAKE GENEVA, WI 53147

I, HAROLD H. KOLB, DO HEREBY CERTIFY THAT I HAVE SURVEYED THE PROPERTY HEREON DESCRIBED ACCORDING TO THE OFFICIAL RECORDS, AND THAT THE PLAT HEREON IS A CORRECT REPRESENTATION OF THE LOT LINES.

Harold H. Kolb
HAROLD H. KOLB
WISCONSIN REGISTERED LAND SURVEYOR, S-187
DATE March 29, 1978

N

SCALE: 1" = 50'

LEGEND

O — IRON PIPE PLACED, 1" x 24" 1.13 LB./LIN. FT.
● — IRON PIN FOUND ( ) — RECORDED AS
ø — IRON PIPE FOUND □ — IRON BAR FOUND + — CUT CROSS FOUND

BRUNING 40-105 1M-6-71

YOP-136 + YUNO-186

4-266 K