PLAT OF SURVEY

FOUNDATION ASBUILT


LOT 31, HARVEST POINTE SUBDIVISION, BEING PART OF LOT 4, CERTIFIED SURVEY MAP No. 2083 AND A PART OF THE NORTHEAST 1/4, NORTHWEST 1/4, SOUTHEAST ¼ AND SOUTHWEST ¼ OF THE SOUTHWEST ¼ OF SECTION 30, TOWNSHIP 3 NORTH, RANGE 17 EAST, CITY OF ELKHORN, WALWORTH COUNTY, WISCONSIN.

0' 100'

SCALE 1" = 100'

LEGEND:

(100.00')	RECORDED DISTANCE
100.00'	MEASURED DISTANCE
●	1" FOUND IRON PIPE, UNLESS NOTED
⌀	¾" x 18" IRON PIPE SET, 1.13 lbs./L.F.
W	WELL
ST	STORM MANHOLE
S	SANITARY MANHOLE
	LIGHT POLE
E	ELECTRIC TRANSFORMER
E	ELECTRIC PEDESTAL
T	TELEPHONE PEDESTAL
T	CABLE TV PEDESTAL

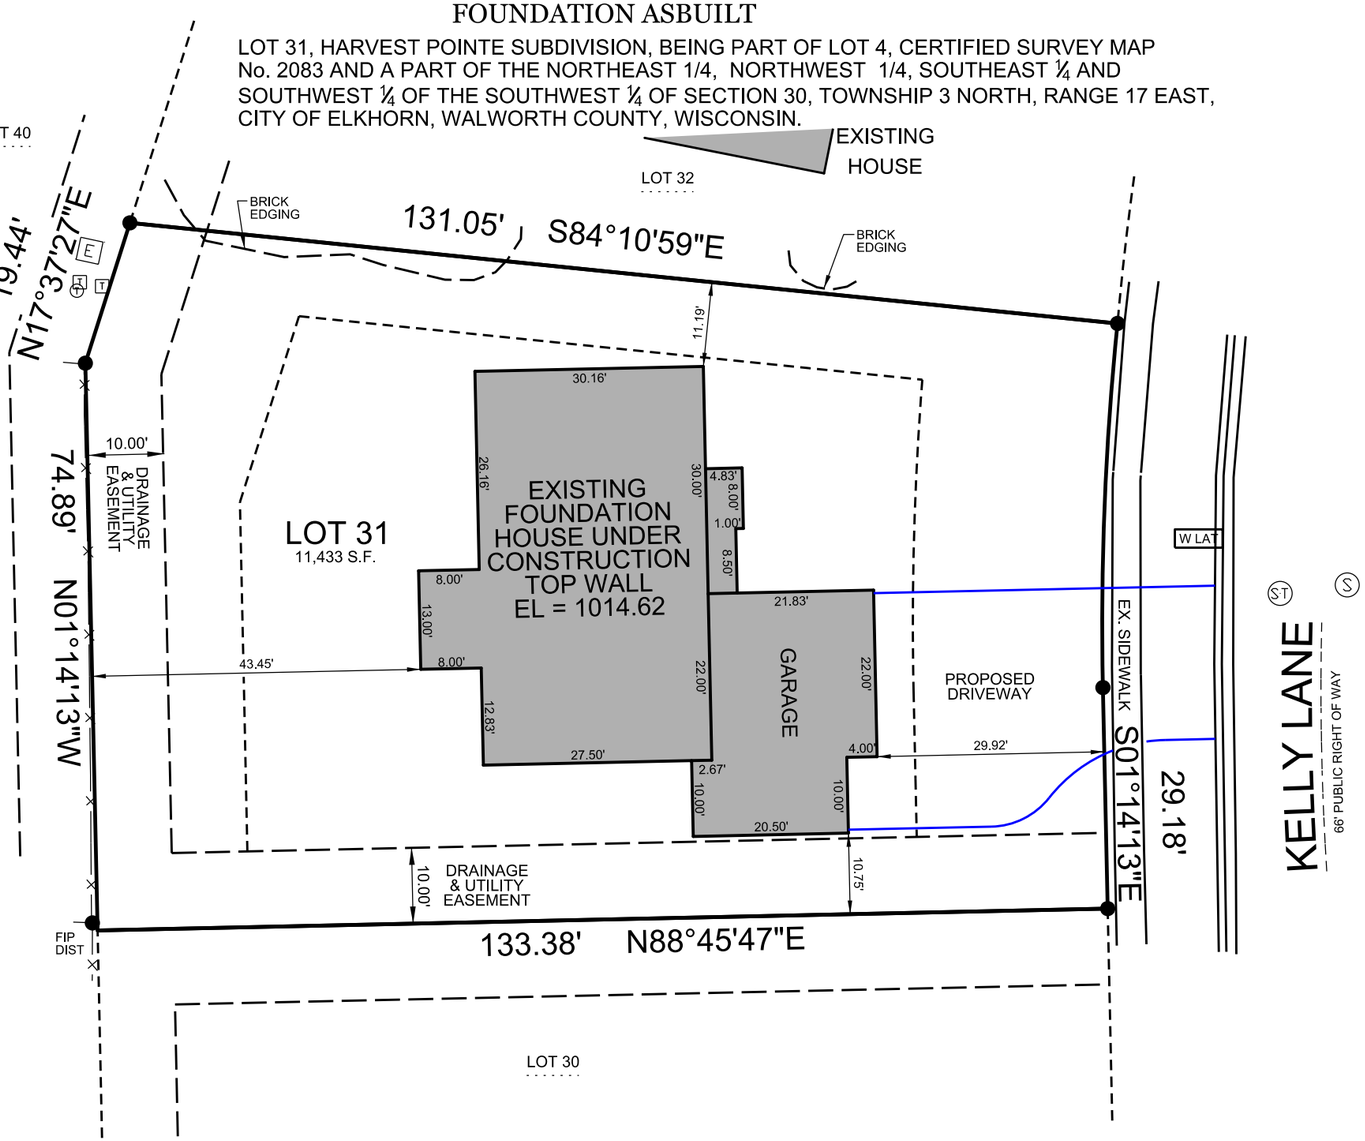

CURVE DATA
C1
ARC - 48.14'
RADIUS - 391.00'
CENTRAL ANGLE - 07°03'14"
CHORD - S02°17'24"W 48.11'

NOTES:

THIS PARCEL IS SUBJECT TO ALL AND ANY RESTRICTIONS, EASEMENTS AND NOTES SHOWN ON THE FINAL PLAT OF HARVEST POINTE SUBDIVISION RECORDED AT THE WALWORTH COUNTY REGISTER OF DEEDS.

EXPOSE SANITARY LATERAL PRIOR TO CONSTRUCTION TO VERIFY GRAVITY FLOW TO BASEMENT.

PROPOSED GRADES PER GRADING PLAN OR ADJUSTED BY BUILDER. CONTRACTOR TO VERIFY ALL PROPOSED GRADES AND WALL HEIGHTS PRIOR TO EXCAVATION.

WISCONSIN
MICHAEL A. GREESON
S-2770
EAST TROY
WIS.
LAND SURVEYOR

Michael A. Greeson

THIS SURVEY IS MADE FOR THE USE OF THE PRESENT OWNERS OF THE PROPERTY, AND ALSO THOSE WHO PURCHASE, MORTGAGE OR GUARANTEE TITLE TO WITHIN ONE (1) YEAR FROM DATE HERETO.

I, MICHAEL A. GREESON P.L.S. X2770, HEREBY CERTIFY THAT THIS SURVEY WAS MADE IN ACCORDANCE WITH THE MINIMUM STANDARDS FOR PROPERTY SURVEYS (CHAPTER A-E 7) FOR THE STATE OF WISCONSIN AND HAS BEEN PREPARED UNDER MY DIRECTION AND CONTROL AND IS CORRECT TO THE BEST OF MY KNOWLEDGE AND BELIEF.

SURVEY MADE FOR:
BIELINSKI HOMES, INC.
1830 MEADOW LANE
PEWAUKEE, WI 53072

DATE	ITEM
02/22/2021	PRELIM SURVEY
03/11/2021	MOVED HOUSE
03/18/2021	PERMIT SURVEY
04/25/2021	FOUND. ASBUILT

V² G
SURVEYING, LLC
123 WOLF RUN – SUITE 4
MUKWONAGO, WI 53149
(262) 378-5097

FILE NAME: 2021-018 BIELINSKI LOT 31 HARVEST POINTE ELKHORN.DGN

PLOT DATE: 04/25/2021

V2G JOB # 2021-018