#205-67

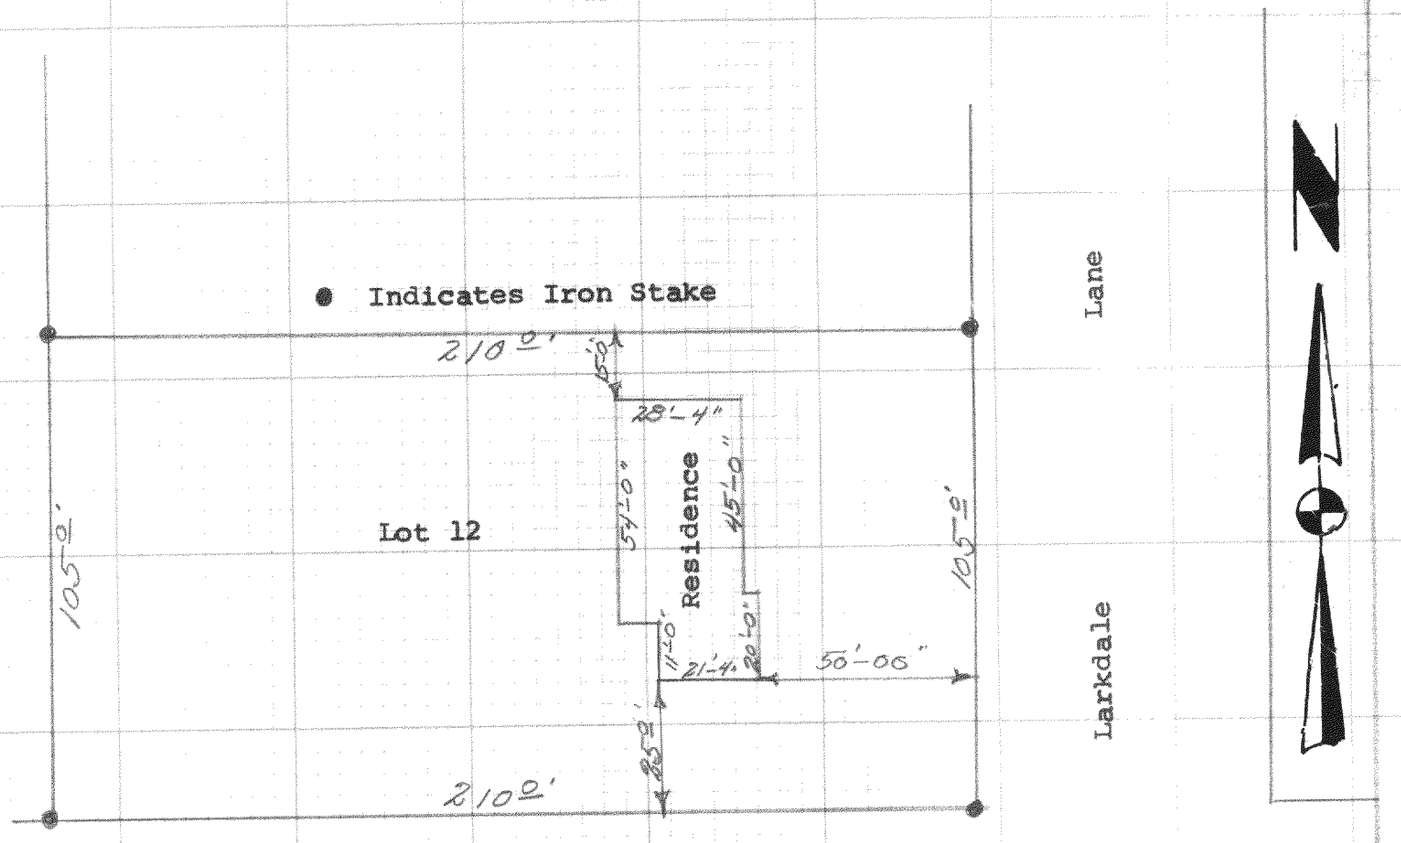

DESCRIPTION:
Lot 12 Green Acres Subdivision of a portion of Section 8, Town 2 north, Range 17 east, Geneva Township, Walworth County, Wisconsin.

CERTIFICATE: I, hereby certify that I have surveyed the above described property on this the 18th day of August 1967.

Carl Elfstrom

Carl Elfstrom RLS-903
Elkhorn, Wisconsin.

Dated this 19th day of August 1967.

WISCONSIN
CARL ELFSTROM
S-903
ELKHORN, WISCONSIN
LAND SURVEYOR