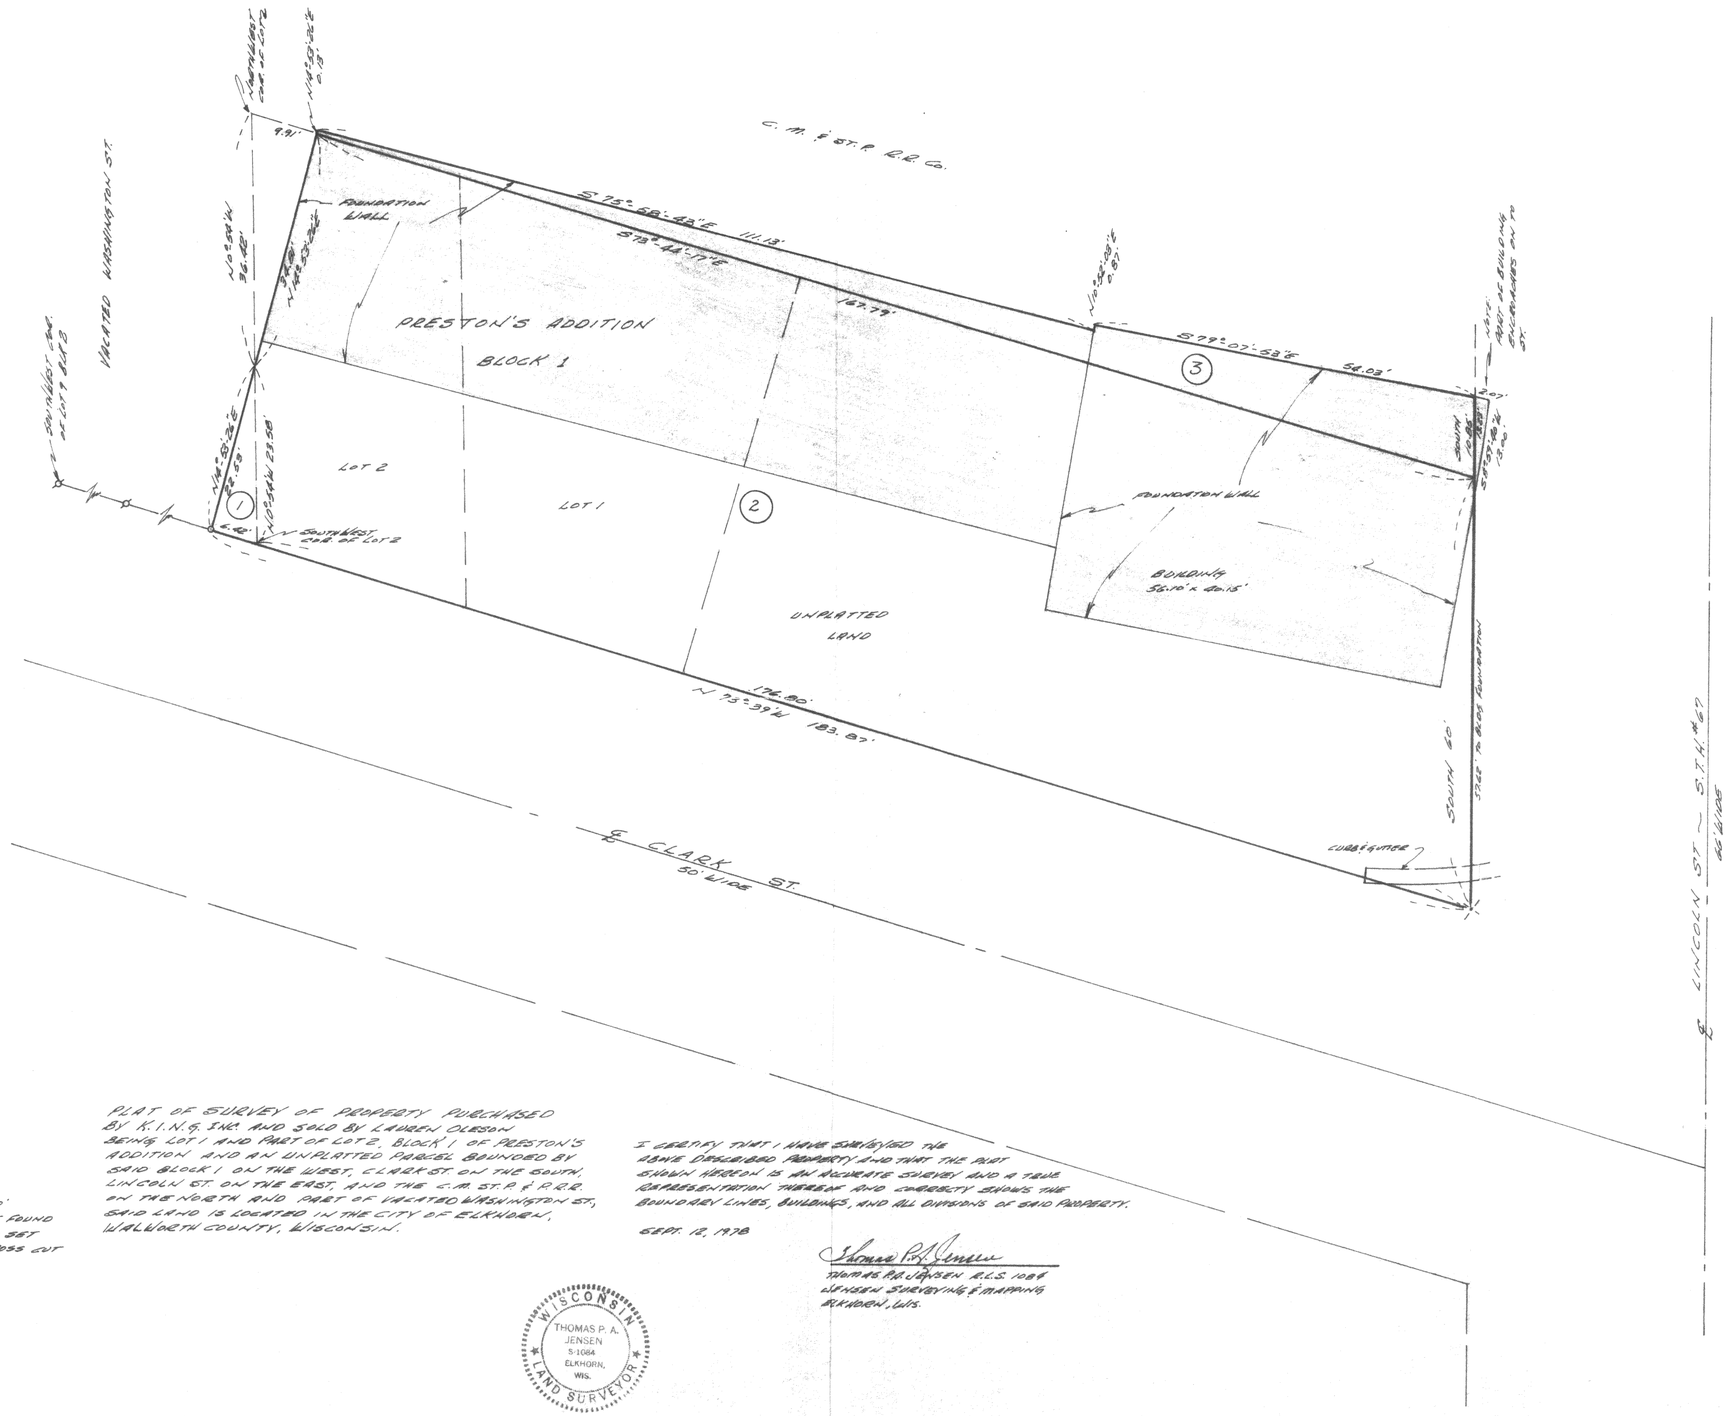

PLAT OF SURVEY OF PROPERTY PURCHASED BY K.I.N.G. INC. AND SOLD BY LAUREN OLSON BEING LOT 1 AND PART OF LOT 2, BLOCK 1 OF PRESTON'S ADDITION AND AN UNPLATTED PARCEL BOUNDED BY SAID BLOCK 1 ON THE WEST, CLARK ST. ON THE SOUTH, LINCOLN ST. ON THE EAST, AND THE C.M. ST. P. & P.R.R. ON THE NORTH AND PART OF VACATED WASHINGTON ST, SAID LAND IS LOCATED IN THE CITY OF ELKHORN, WALWORTH COUNTY, WISCONSIN.

SCALE 1" = 10'
⊗ ~ IRON PIPE FOUND
○ ~ IRON PIPE SET
X ~ CHISEL CROSS CUT

I CERTIFY THAT I HAVE SURVEYED THE ABOVE DESCRIBED PROPERTY AND THAT THE PLAT SHOWN HEREON IS AN ACCURATE SURVEY AND A TRUE REPRESENTATION THEREOF AND CORRECTLY SHOWS THE BOUNDARY LINES, BUILDINGS, AND ALL DIMENSIONS OF SAID PROPERTY.

SEPT. 12, 1978

Thomas P. A. Jensen

THOMAS P.A. JENSEN R.L.S. 1084
JENSEN SURVEYING & MAPPING
ELKHORN, WIS.

WISCONSIN
THOMAS P. A. JENSEN
S-1084
ELKHORN, Wis.
LAND SURVEYOR

1978.068

YP-1A.

4-280