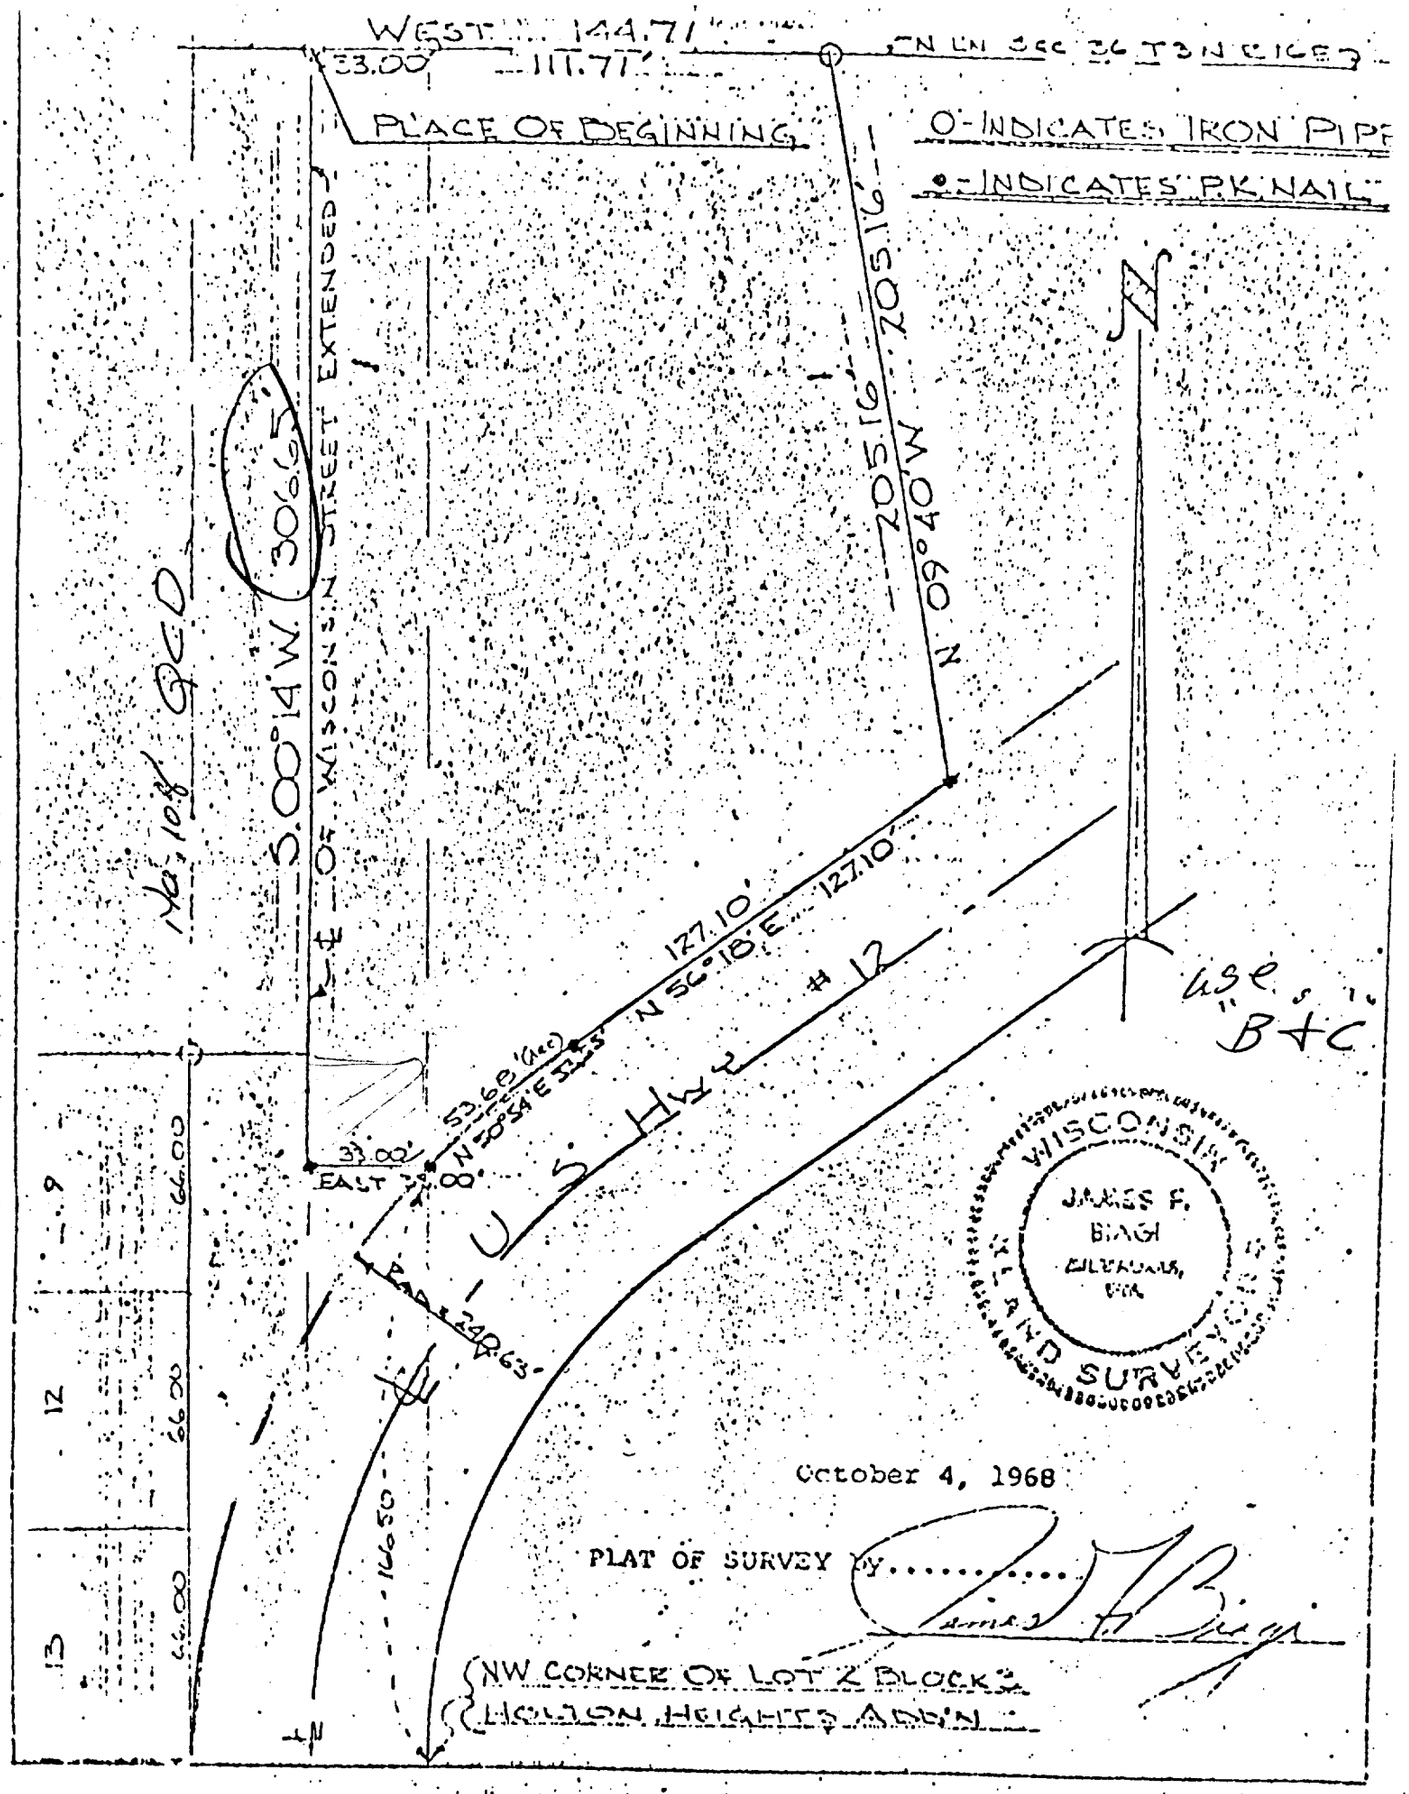
WEST 144.71'
33.00
111.71'
N LN SEC 36 T3N R16E
PLACE OF BEGINNING
O-INDICATES IRON PIPE
•-INDICATES P.K. NAIL
WISCONSIN STREET EXTENDED
S 00°14' W 306.65
N 09°40' W 205.16'
127.10'
N 56°18' E 127.10'
53.68' (rec)
N 40°54' E 51.53'
33.00'
EAST 33.00'
U.S. Hwy 12
Use "B+C"
WISCONSIN
JAMES F. BIAGI
LAND SURVEYOR
October 4, 1968
PLAT OF SURVEY by
NW CORNER OF LOT 2 BLOCK 3
HOLTON HEIGHTS ADD'N
9
12
13
66.00
66.00
66.00
160.50

Yu.nw-3

4-287