
PLAT OF SURVEY

OF LAND LOCATED IN THE SE.¼ OF SECTION 1
T2N, R16E, WALWORTH COUNTY WISCONSIN

JENSEN SURVEYING & MAPPING S.C.
P.O. BOX 322
ELKHORN, WISC 53121

JULY 15, 1981

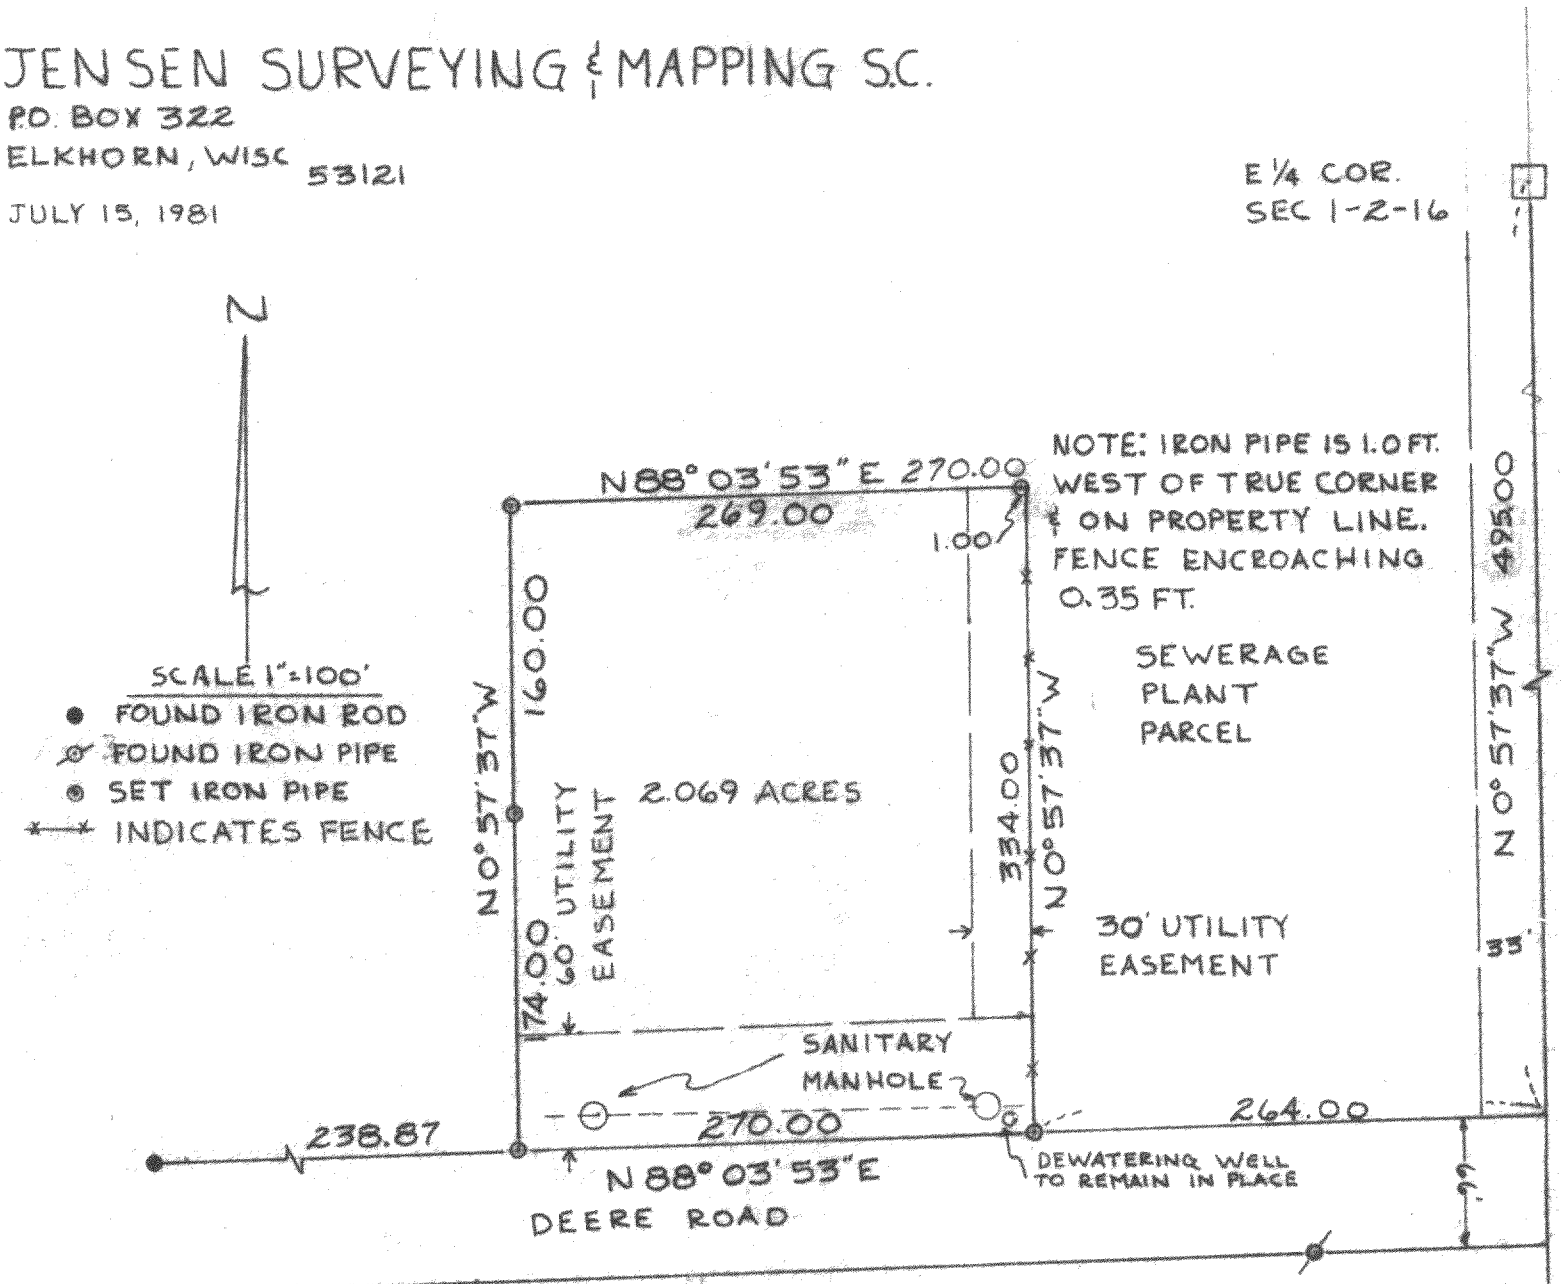

DESCRIPTION: A parcel of land located in the SE¼ of Section 1, T2N, R16E, City of Elkhorn, Walworth County, Wisconsin, described as follows: Commence at thes East ¼ Corner of said Section 1; thence S0°57'37"E 495.00 feet; thence S88°03'53"W 264.00 feet to the point of beginning; thence continue S88°03'53"W 270.00 feet; thence N0°57'37"W 334.00 feet; thence N88°03'53"E 270.00 feet; thence S0°57'37"E 334.00 feet to the point of beginning, parcel contains 2.069 acres of land, more or less. The above described land subject to an easement over the South 60 feet for maintanence and repair of the sanitary sewer and drainage tile lines to the City of Elkhorn. Also----See Below-

I certify that I have surveyed the above described property and that the plat shown hereon is an accurate survey and a true representation thereof and correctly shows the exterior boundary lines and all divisions of said property.

Also the above described land subject to an utility easement over the East 30 feet.

WISCONSIN
THOMAS P. A. JENSEN
S-1084
ELKHORN, WIS.
LAND SURVEYOR

Thomas P.A. Jensen S-1084
Elkhorn, Wis.

YU-SW-47-G

4-320-J ✓